


0.035 - 0.127 RAMP B (7)

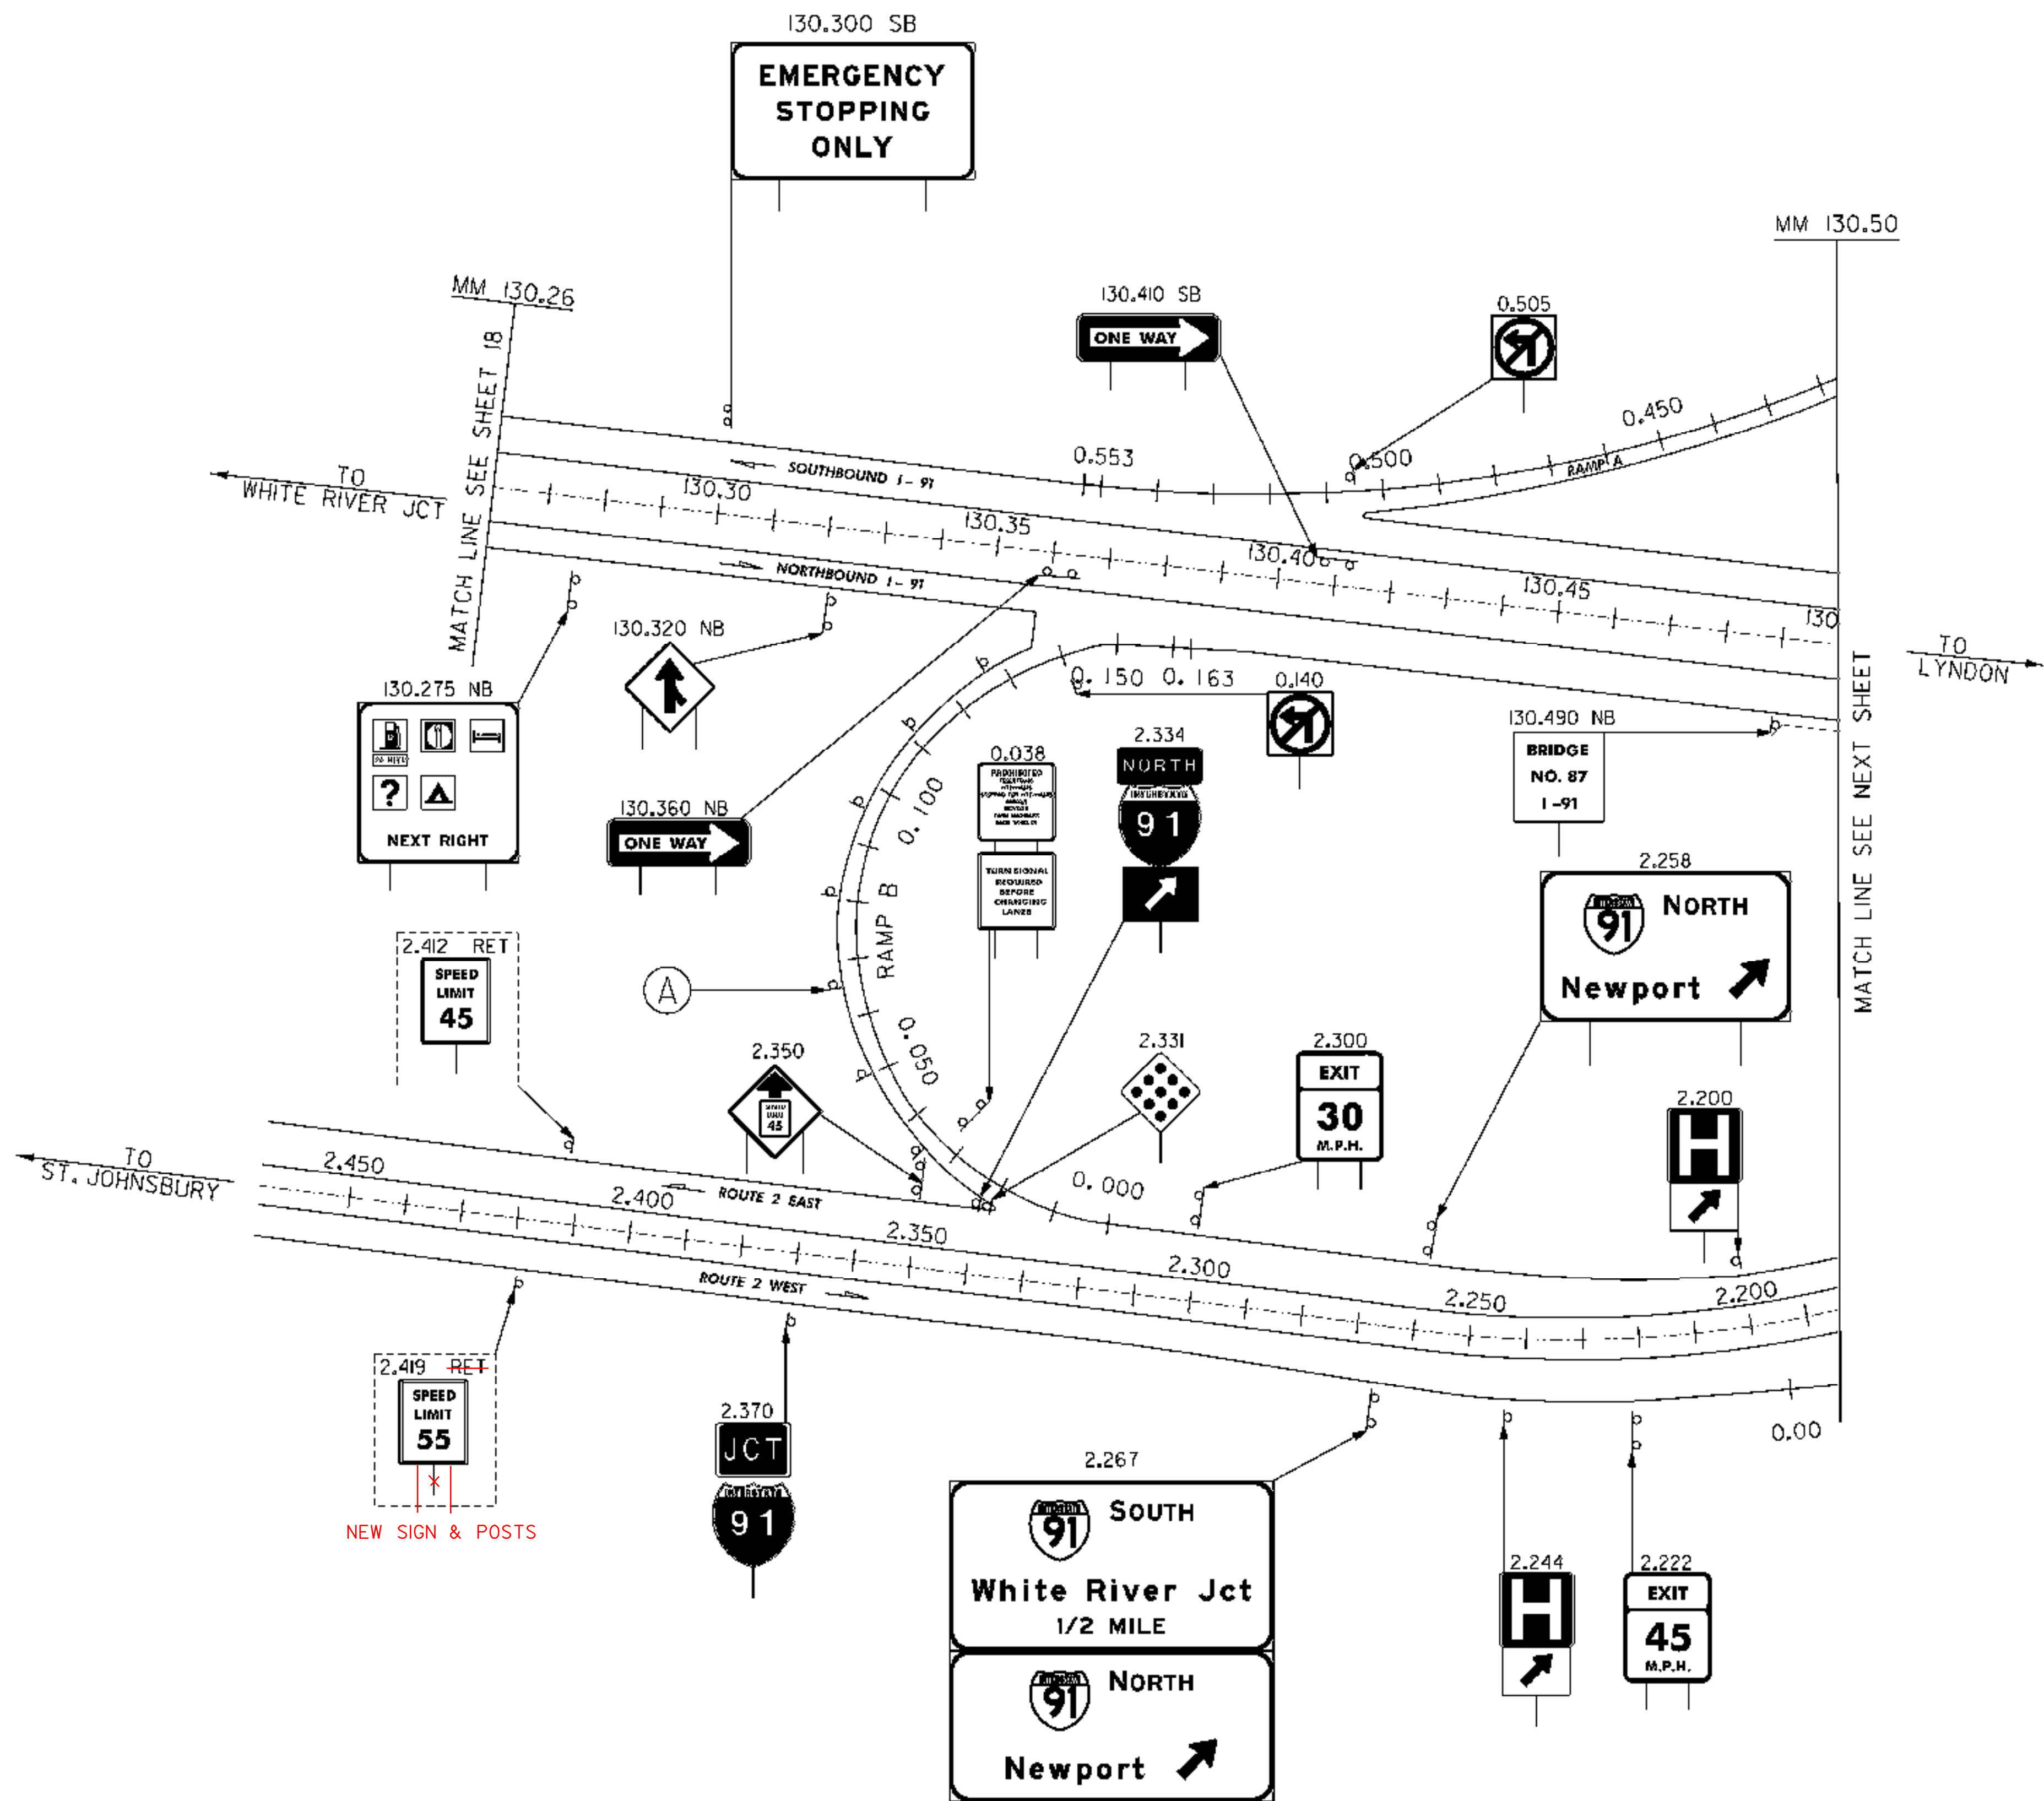

LEGEND  
 [Dashed Box] RET - RETAINED

**ALL SIGNS AND POSTS ARE NEW UNLESS OTHERWISE NOTED**

<b>INTERCHANGE 21 NEW SIGNS</b>	PROJECT NAME: ST. JOHNSBURY-LYNDON	PLOT DATE: 1/4/2007
	PROJECT NUMBER: HES 091-3(42)	DRAWN BY: HJC
	FILE NAME: 97211a-ex1t21.dgn	CHECKED BY: DAM
	CLD REF. NO.: 97-0211	SHEET 21 OF 130