


Accel. lane taper ends at
 130.061±, 1843' from Gore
 Use 19 Type II Delineators

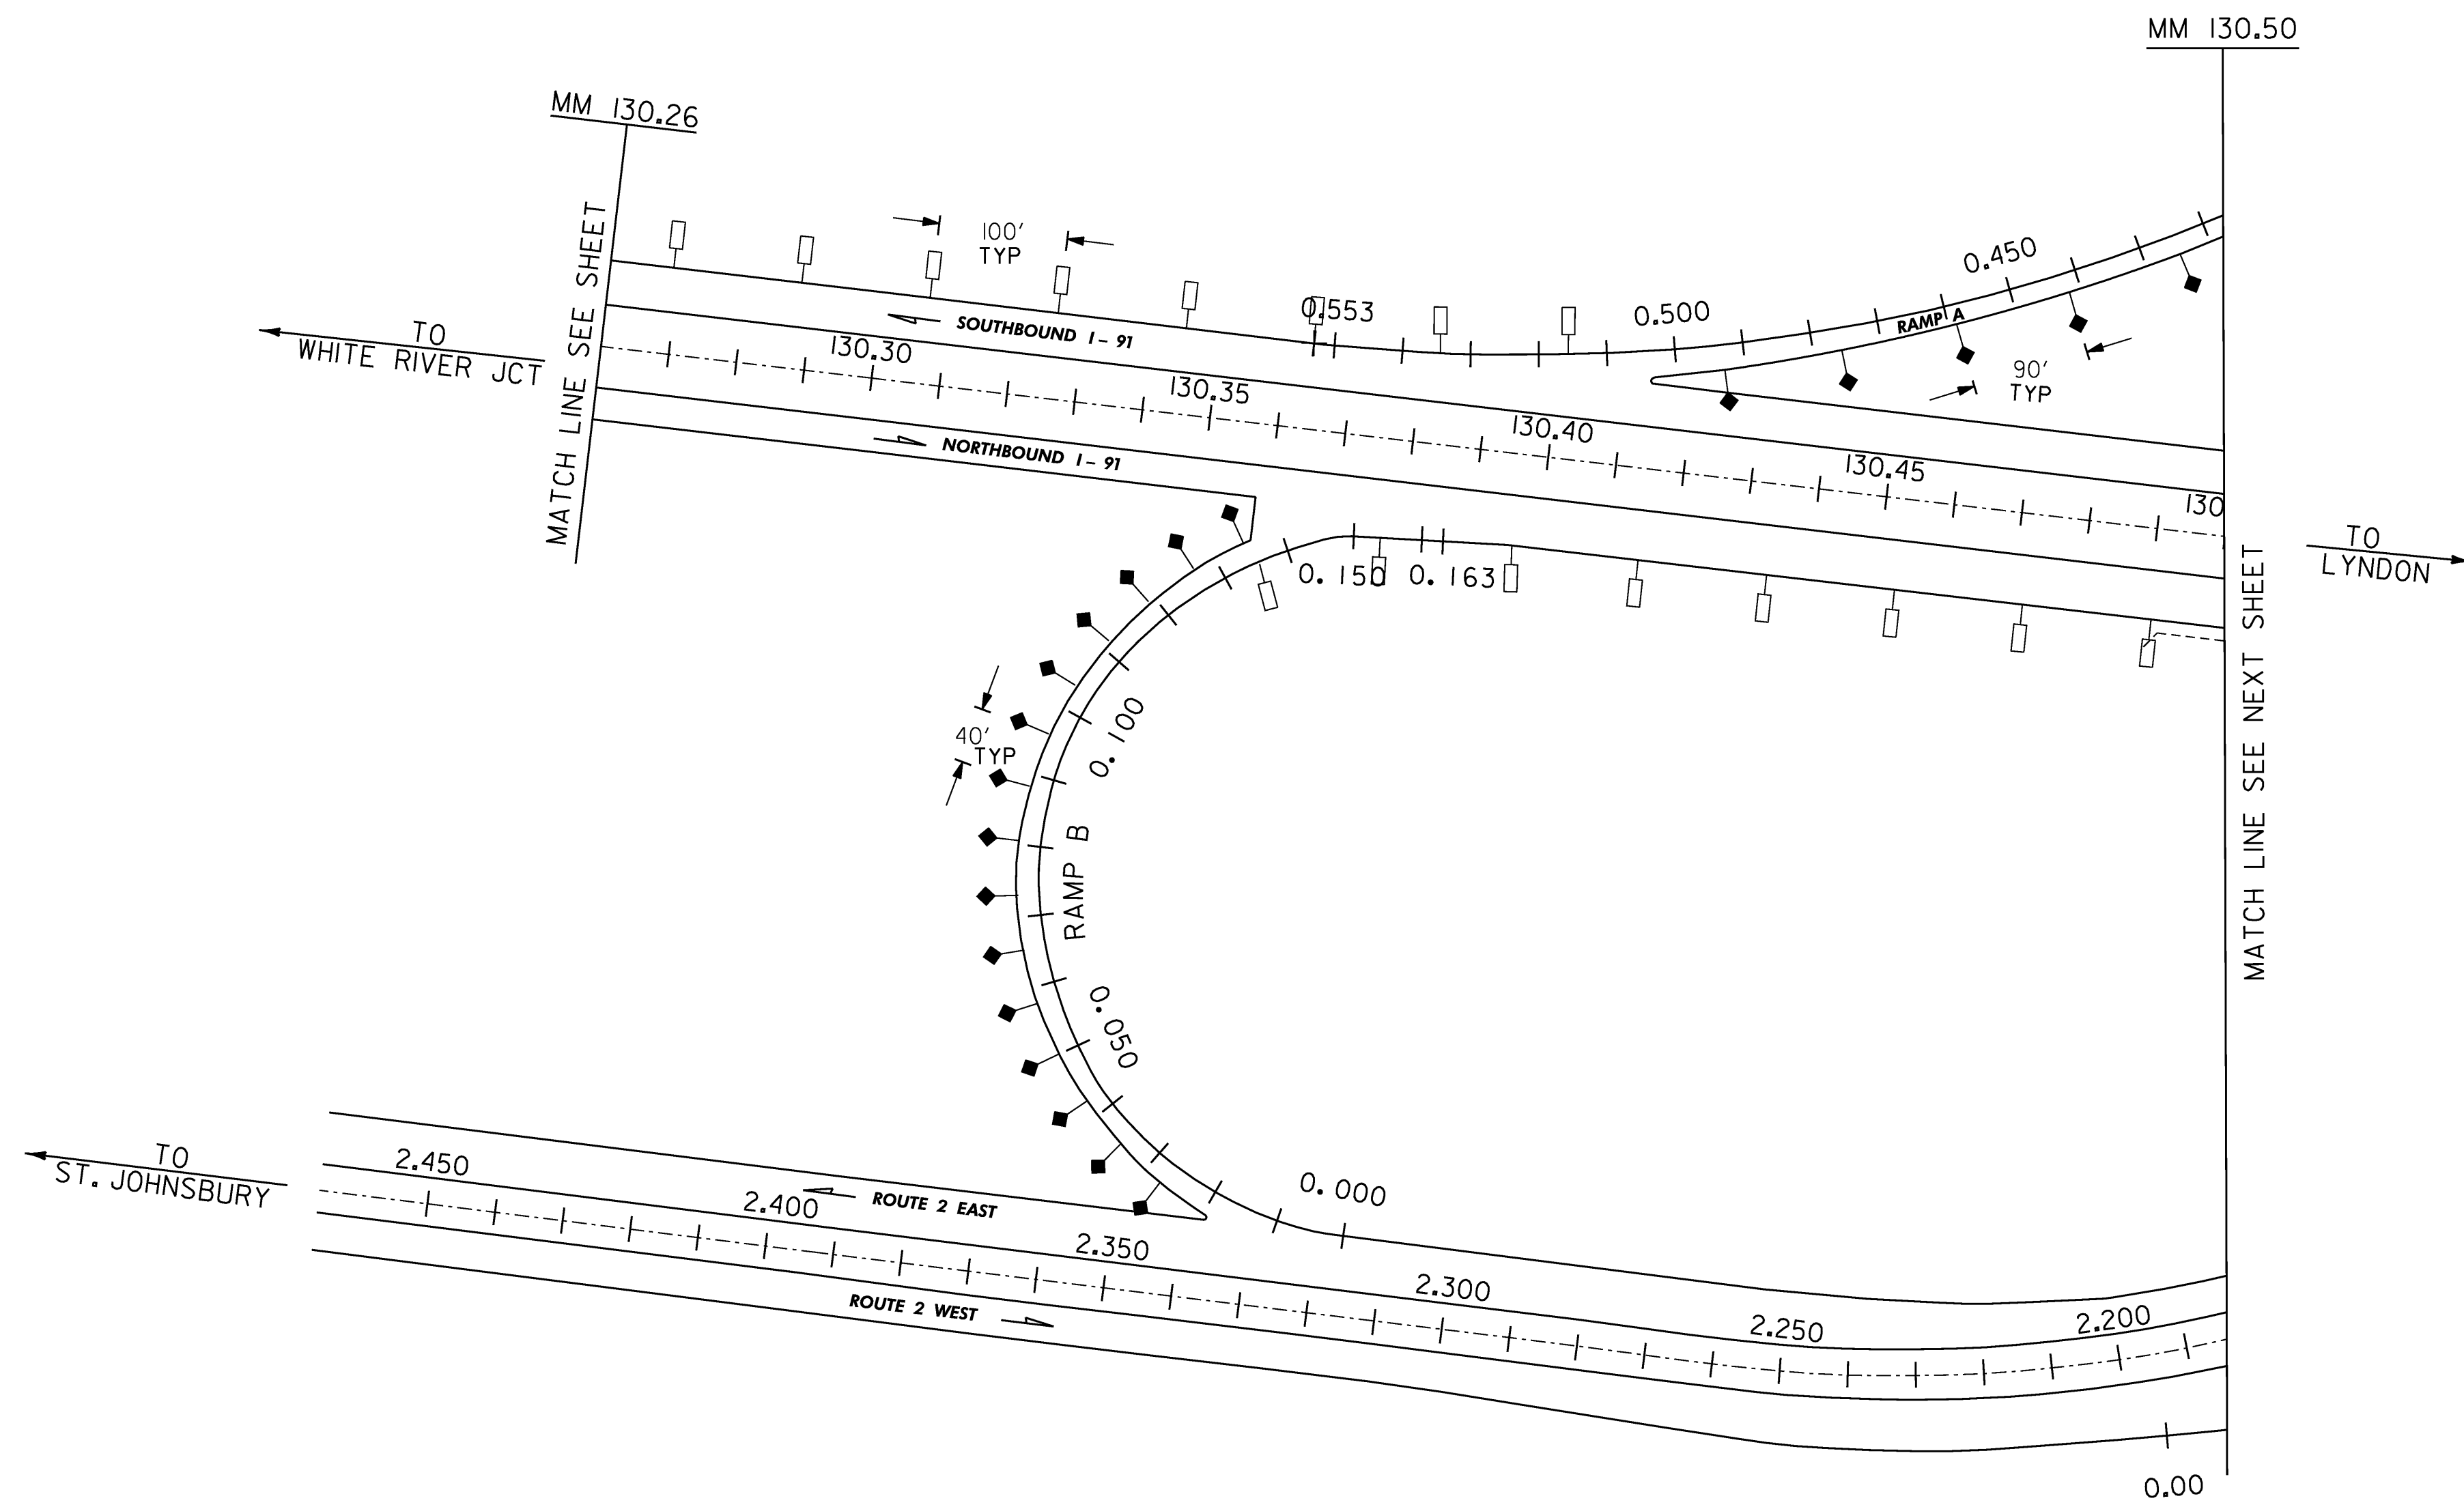

LEGEND

- TYPE I (WHITE)
- TYPE I (YELLOW)
- TYPE II (WHITE)
- TYPE III (RED ON BACK, WHITE)
- TYPE III (RED ON BACK, YELLOW)

**INTERCHANGE 21
 DELINEATOR LAYOUT**

PROJECT NAME:	ST. JOHNSBURY-LYNDON
PROJECT NUMBER:	HES 091-3(42)
FILE NAME:	9721la-ex1+21.dgn
PROJECT LEADER:	CRB
DESIGNED BY:	DAM
CLD REF. NO.:	97-0211
PLOT DATE:	1/4/2007
DRAWN BY:	HJC
CHECKED BY:	DAM
SHEET	25 OF 130