




M.M. 129.921 NB

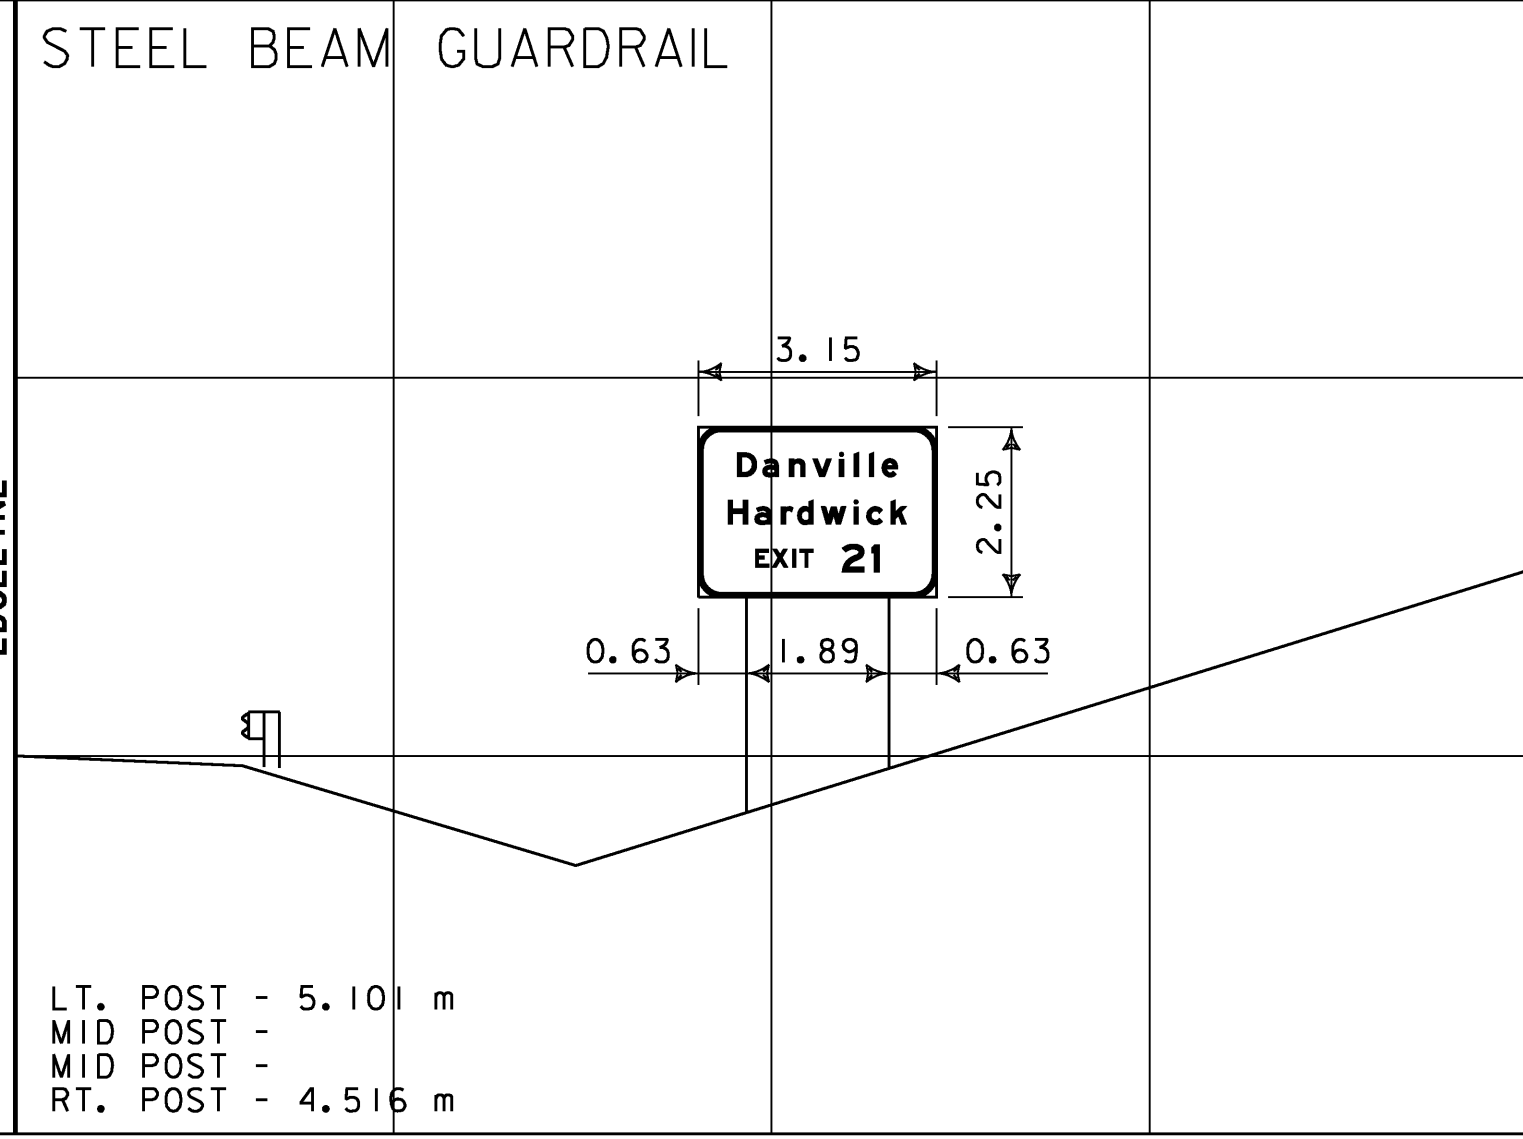


M.M. 130.550 NB

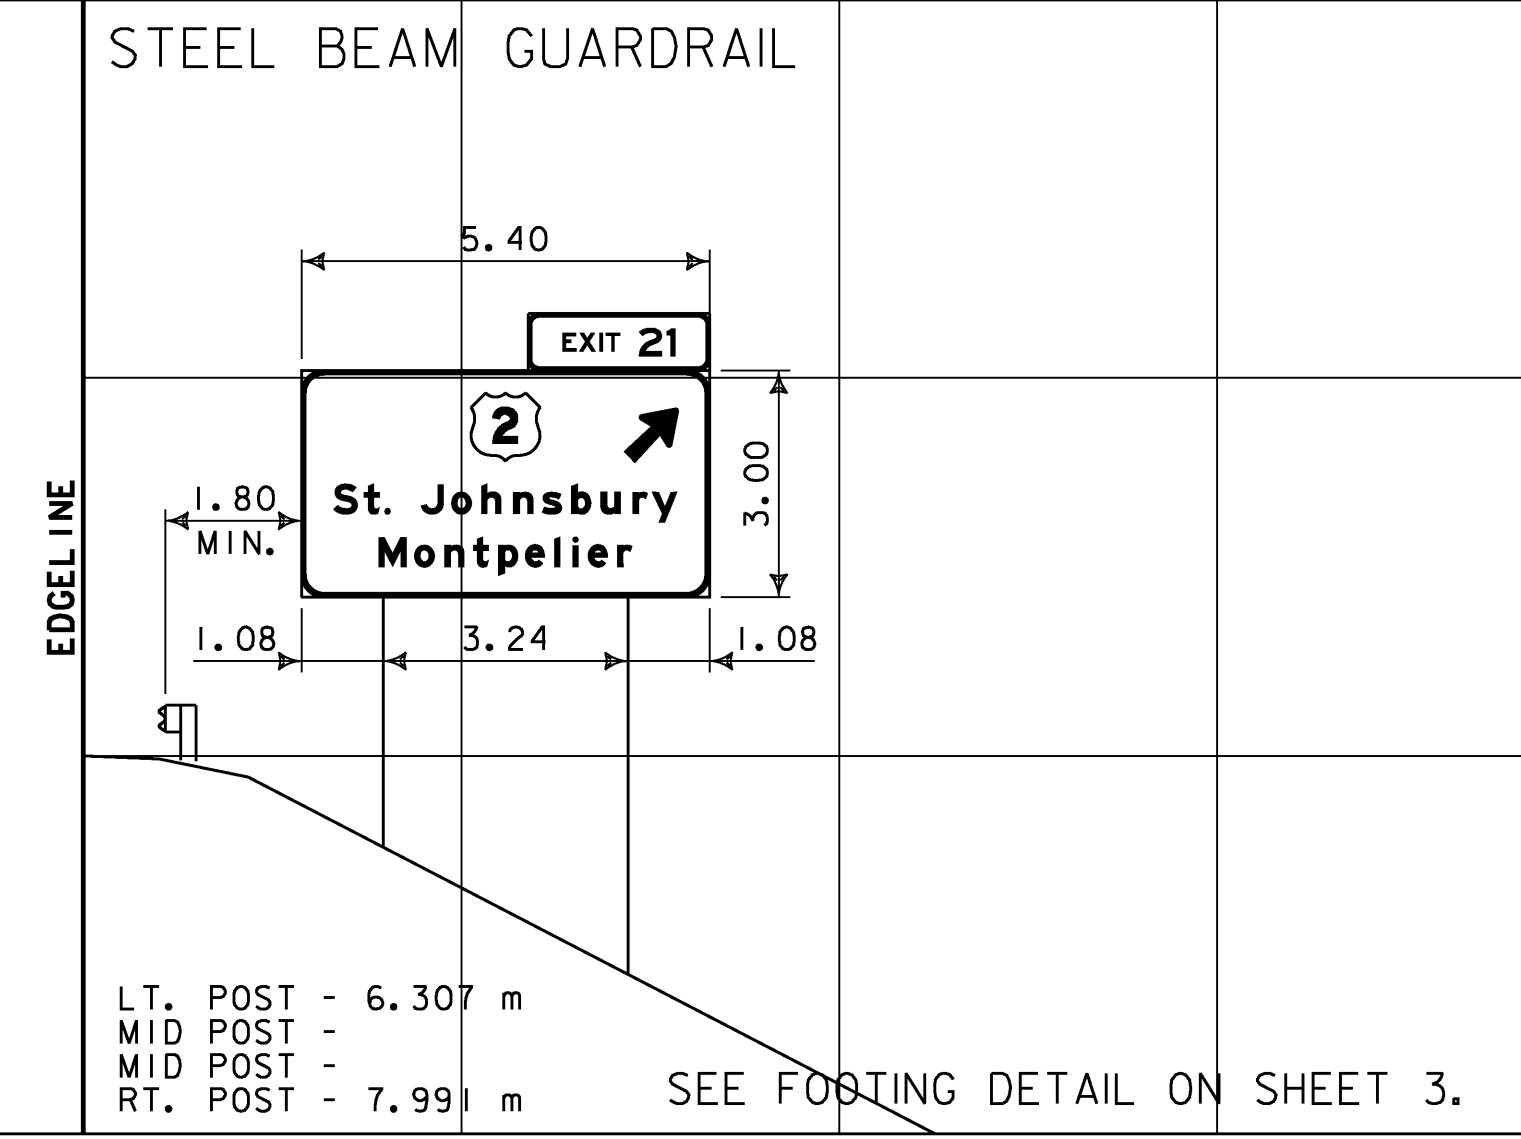


M.M. 131.770 NB

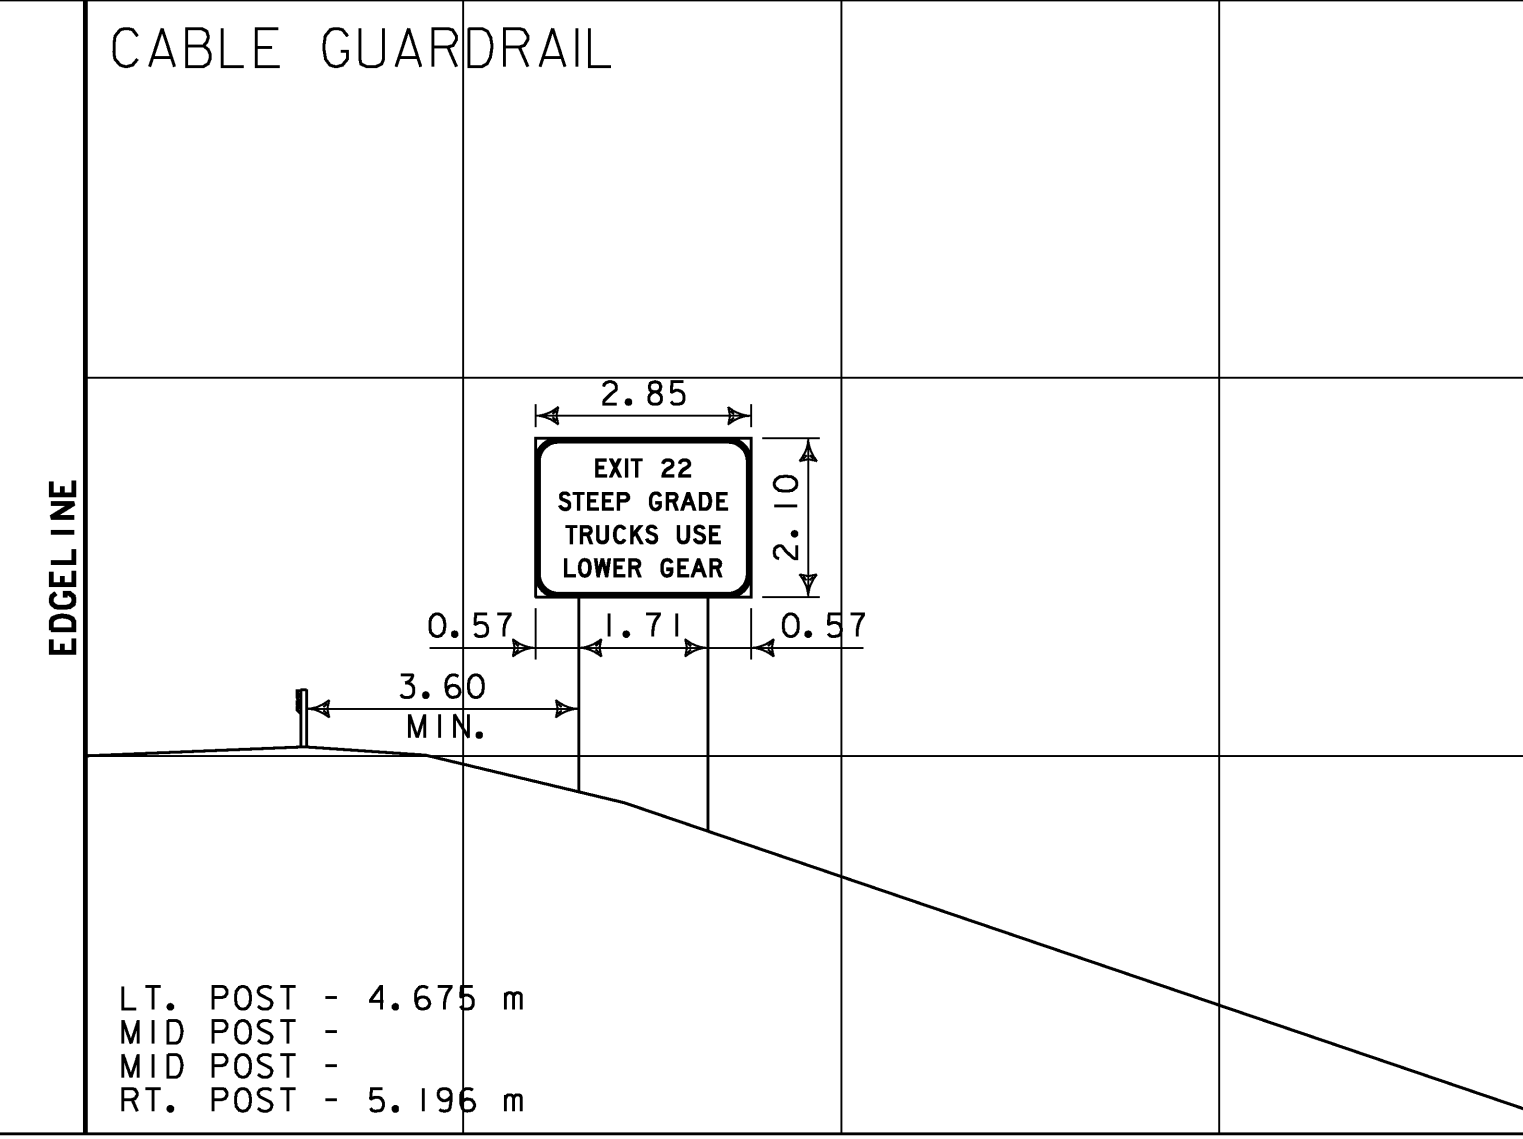


M.M. 129.805 NB

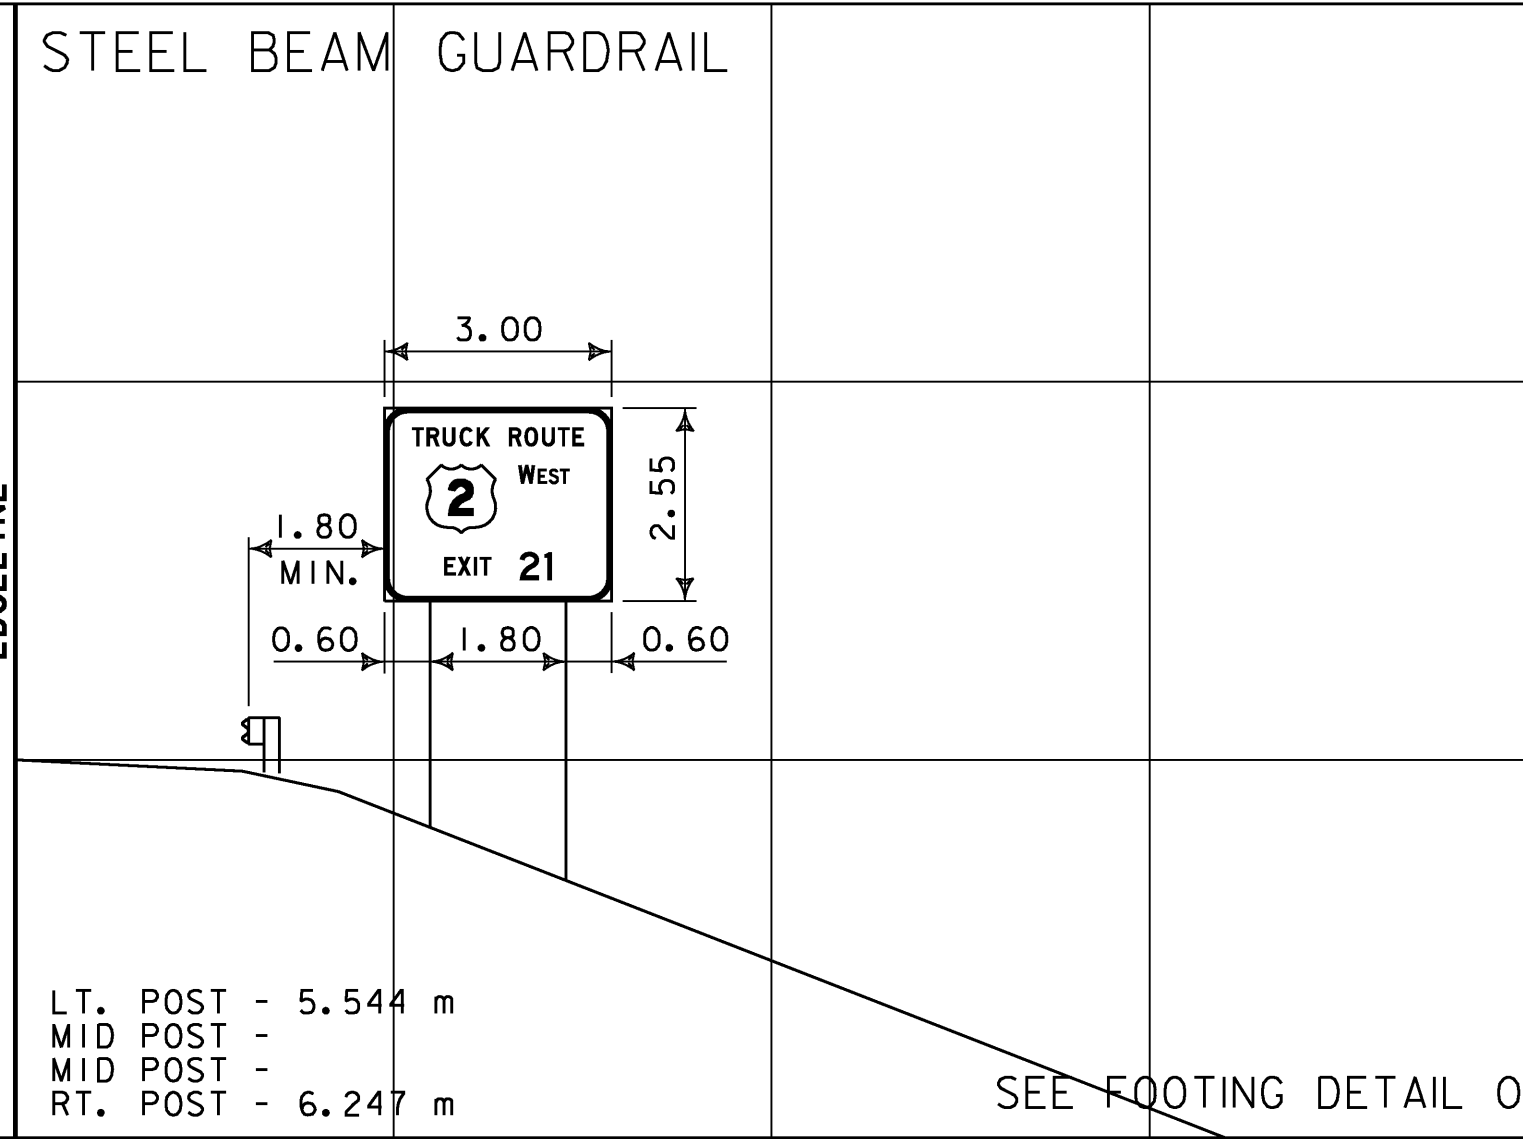


M.M. 130.275 NB

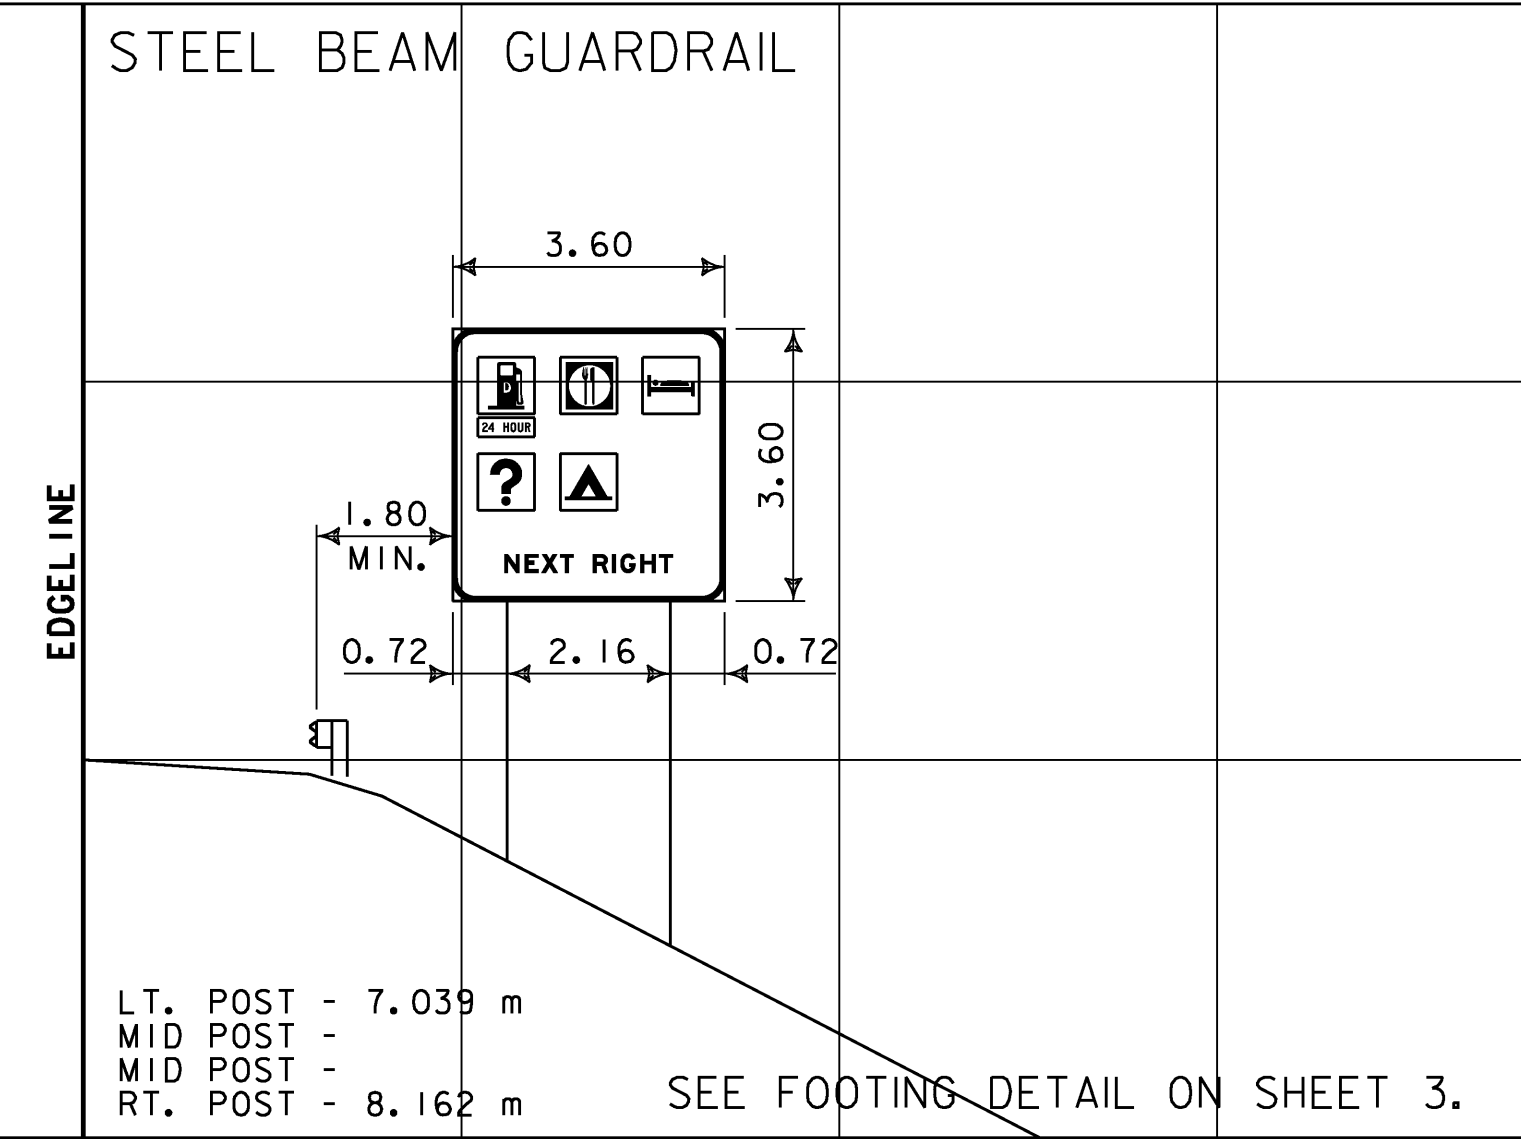



M.M. 131.380 NB

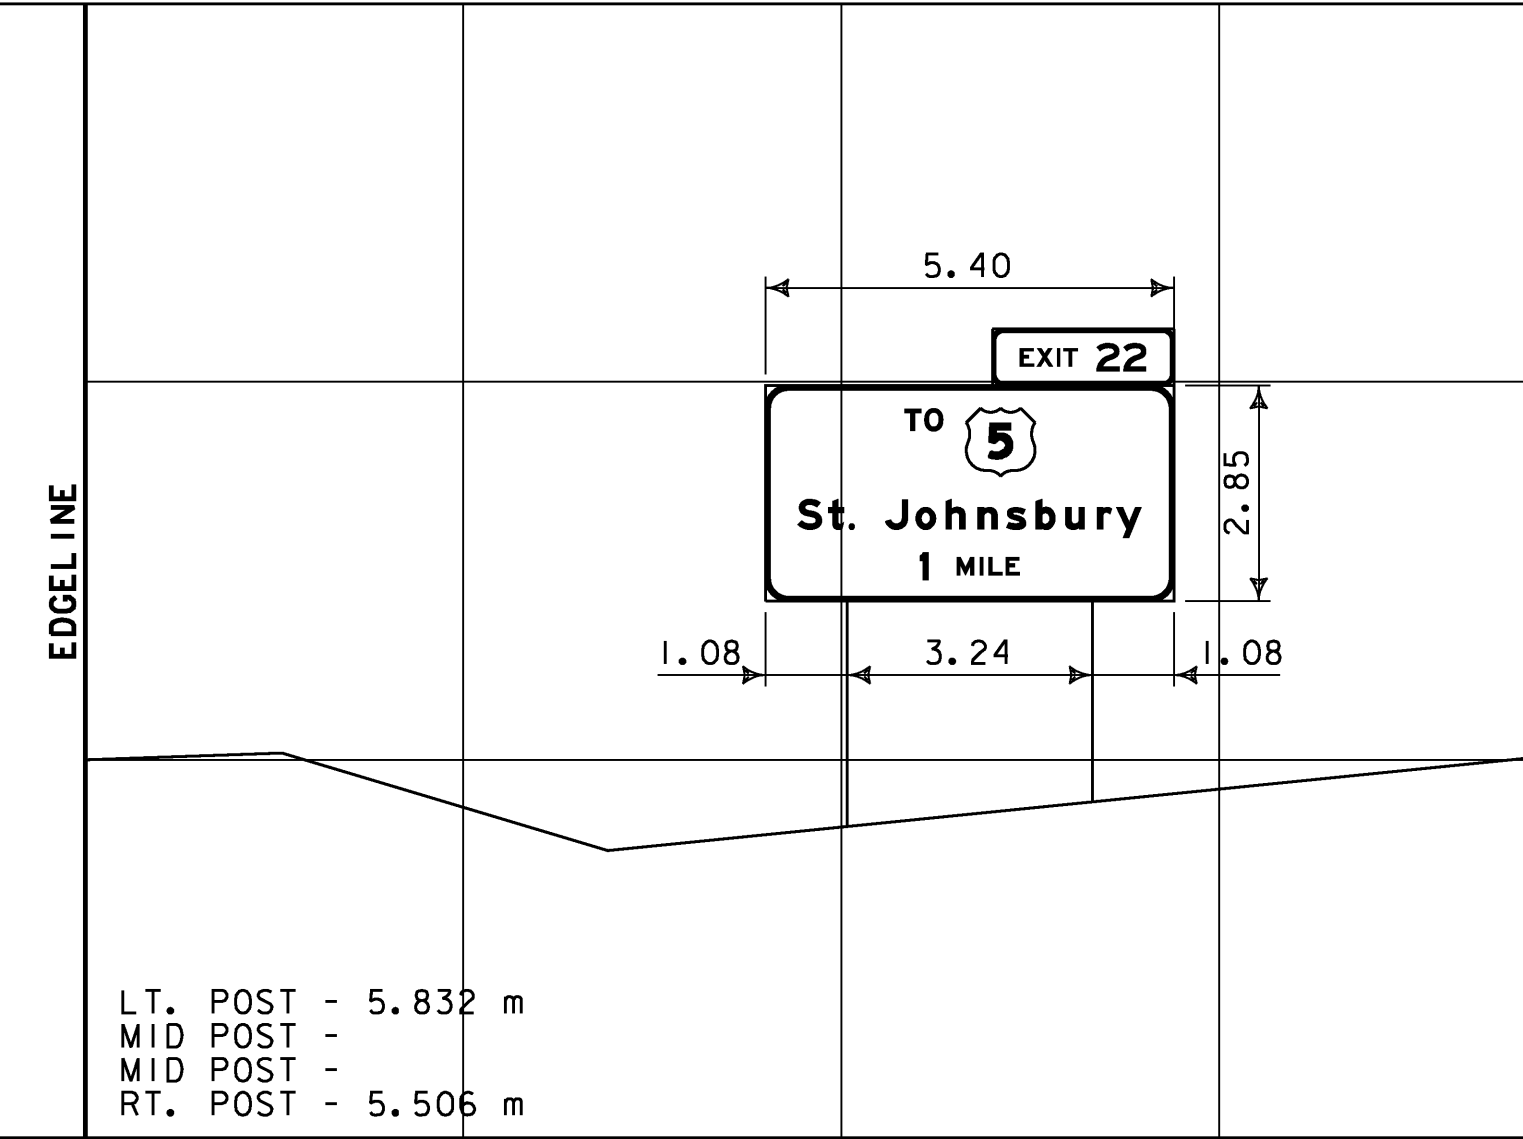

M.M. 129.647 NB

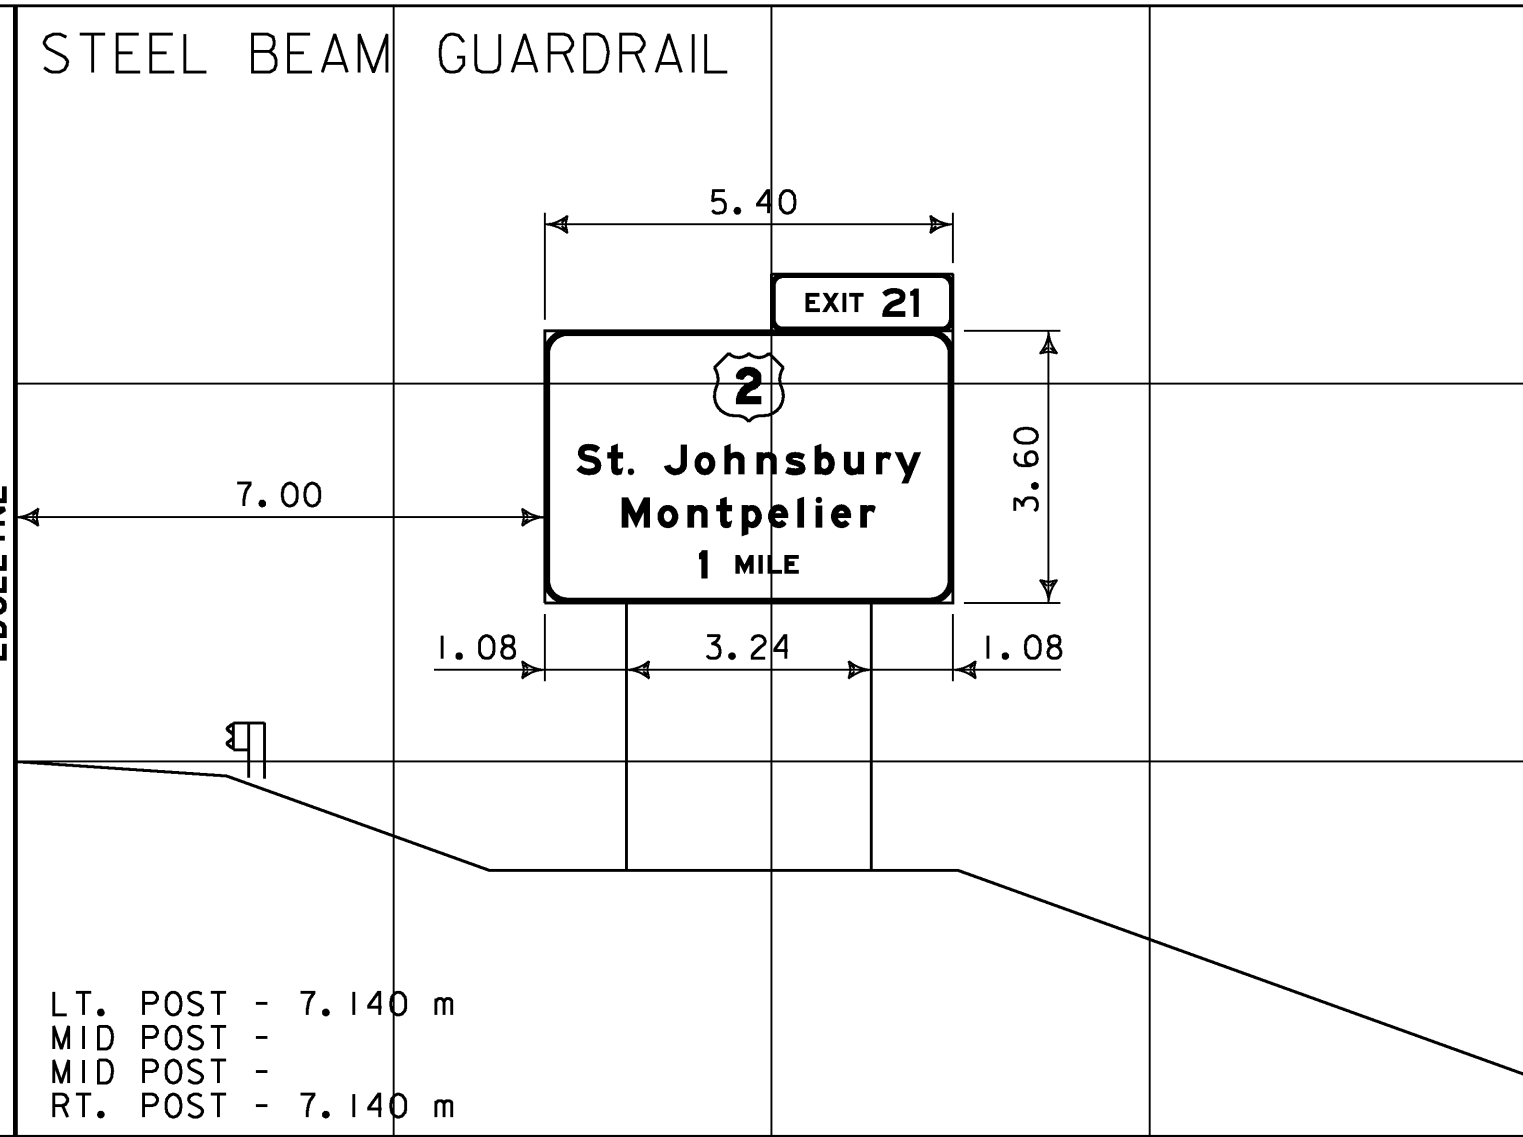

M.M. 130.080 NB

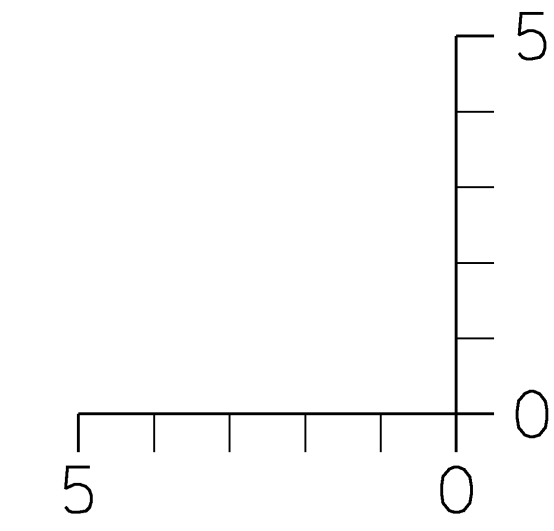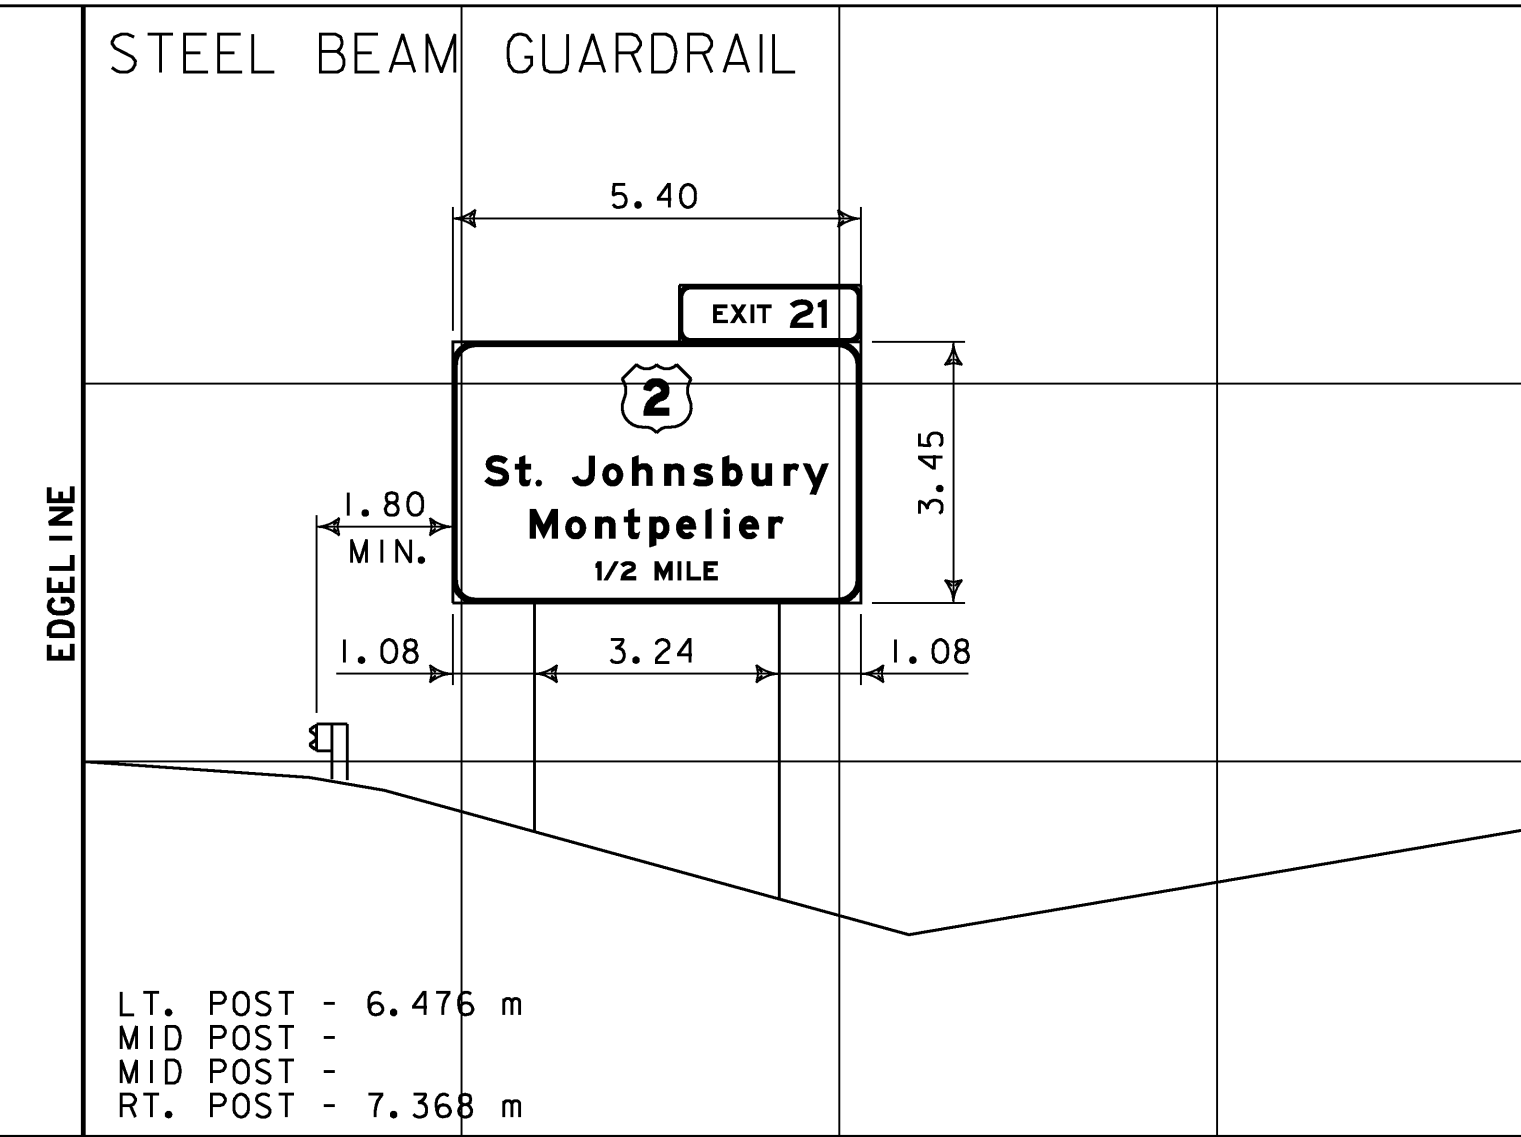

DIMENSIONS FOR CRITICAL OFFSETS OR CLEARANCES SHOWN FOR CONVENIENCE. REFER TO STANDARD SHEETS FOR PLACEMENT GUIDELINES.

SIGN CROSS SECTION SHEET 1

PROJECT NAME:	ST. JOHNSBURY-LYNDON
PROJECT NUMBER:	HES 091-3(42)
FILE NAME:	9721la-xs.dgn
PROJECT LEADER:	CRB
DESIGNED BY:	DAM
CLD REF. NO.:	97-0211
PLOT DATE:	1/4/2007
DRAWN BY:	HJC
CHECKED BY:	DAM
SHEET 71 OF 130	