




M.M. 131.236 SB

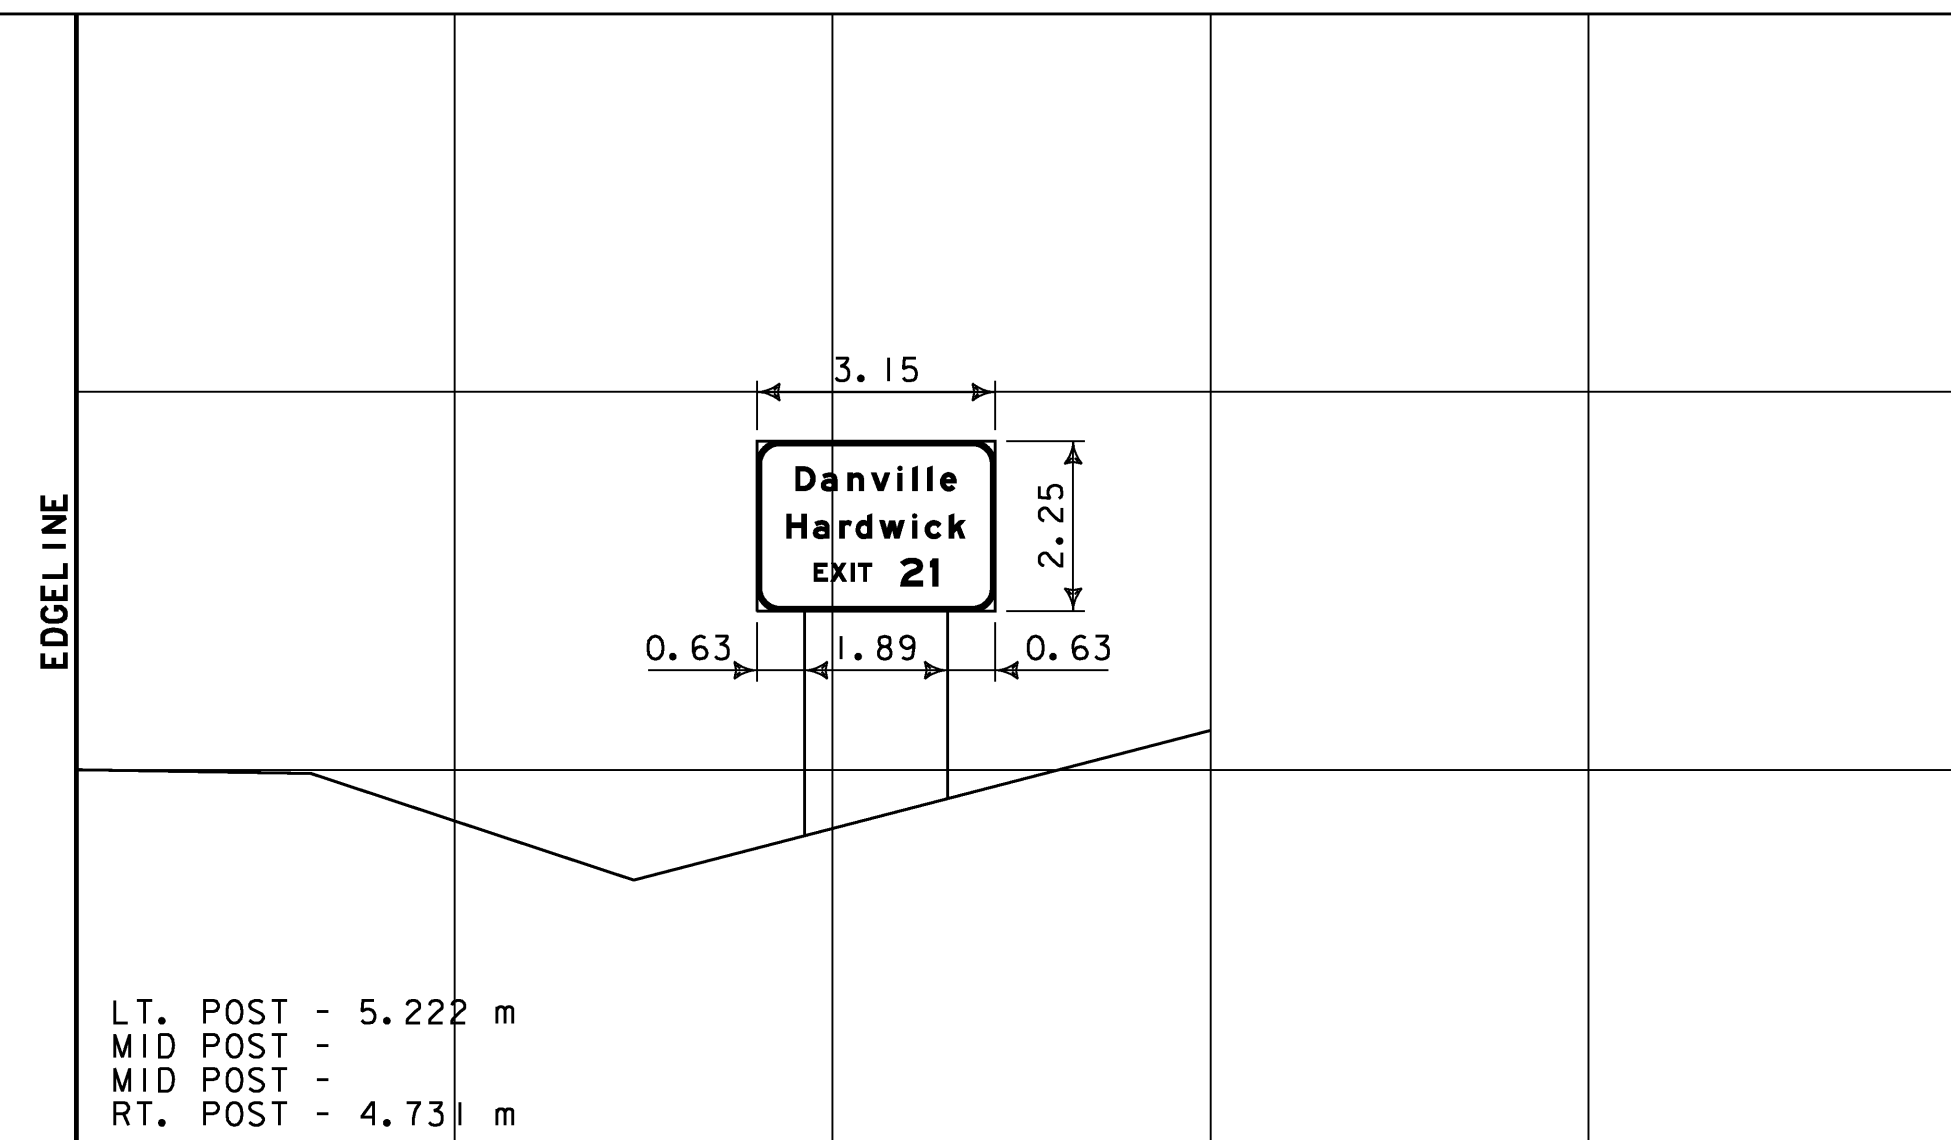


M.M. 133.085 SB

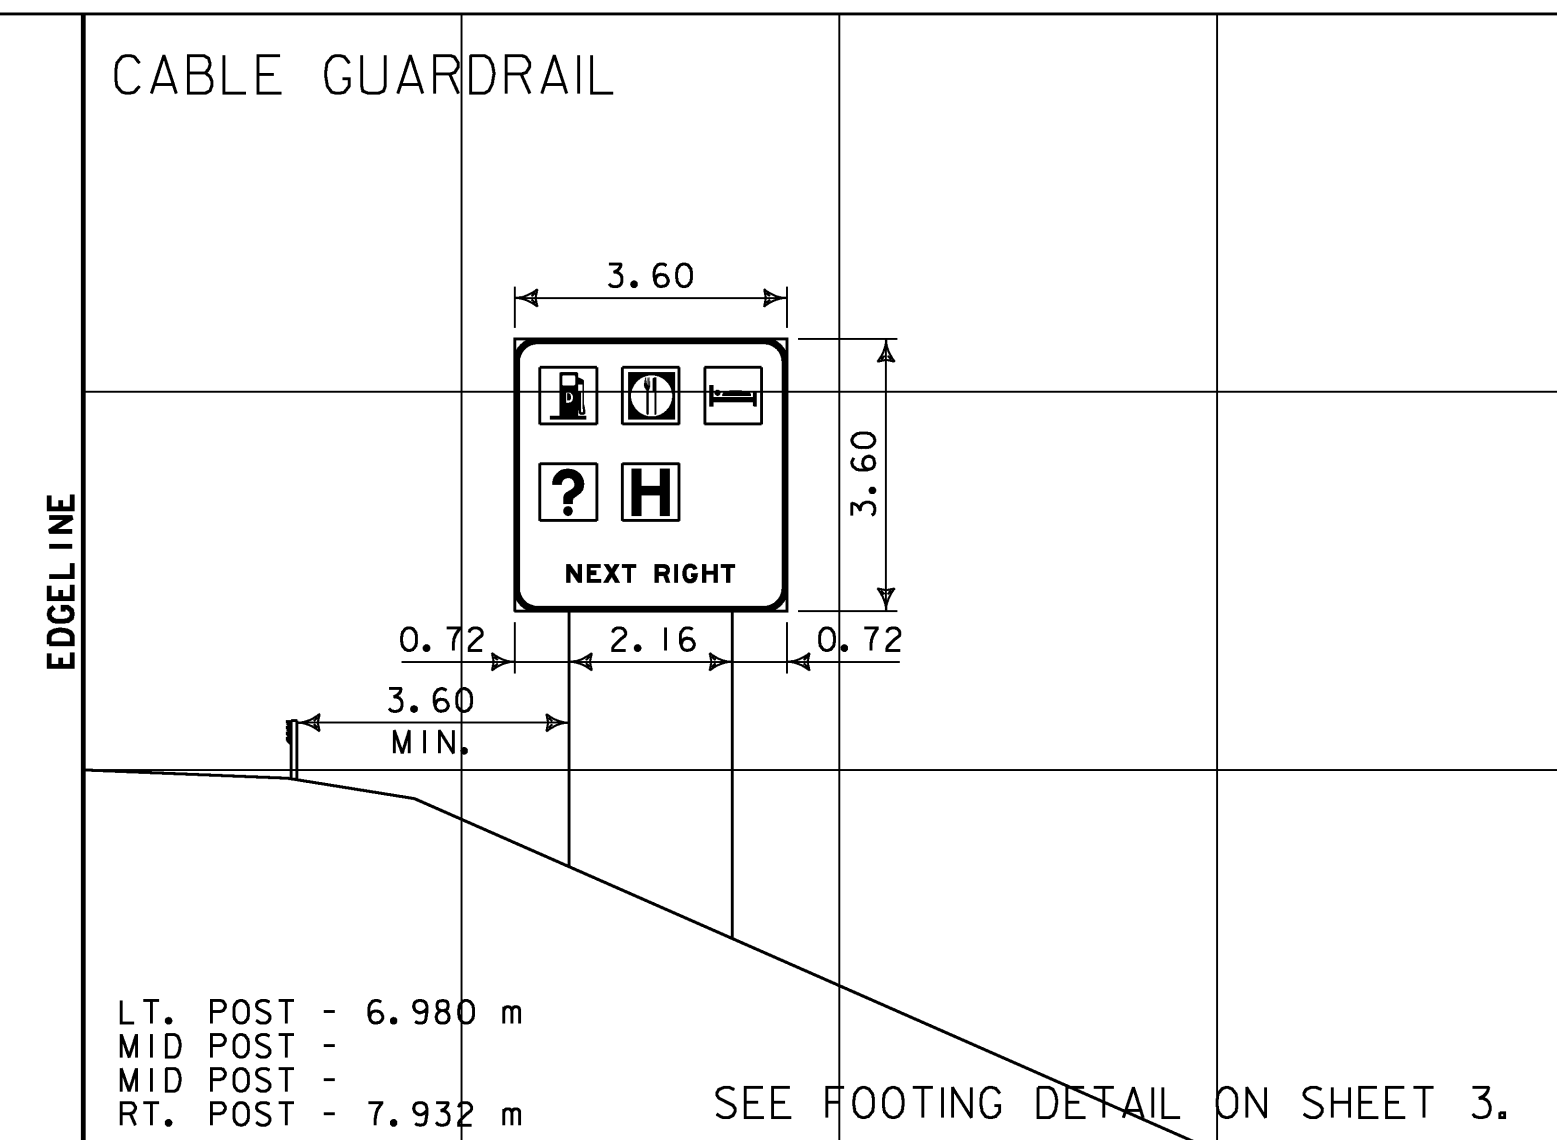


M.M. 133.385 SB

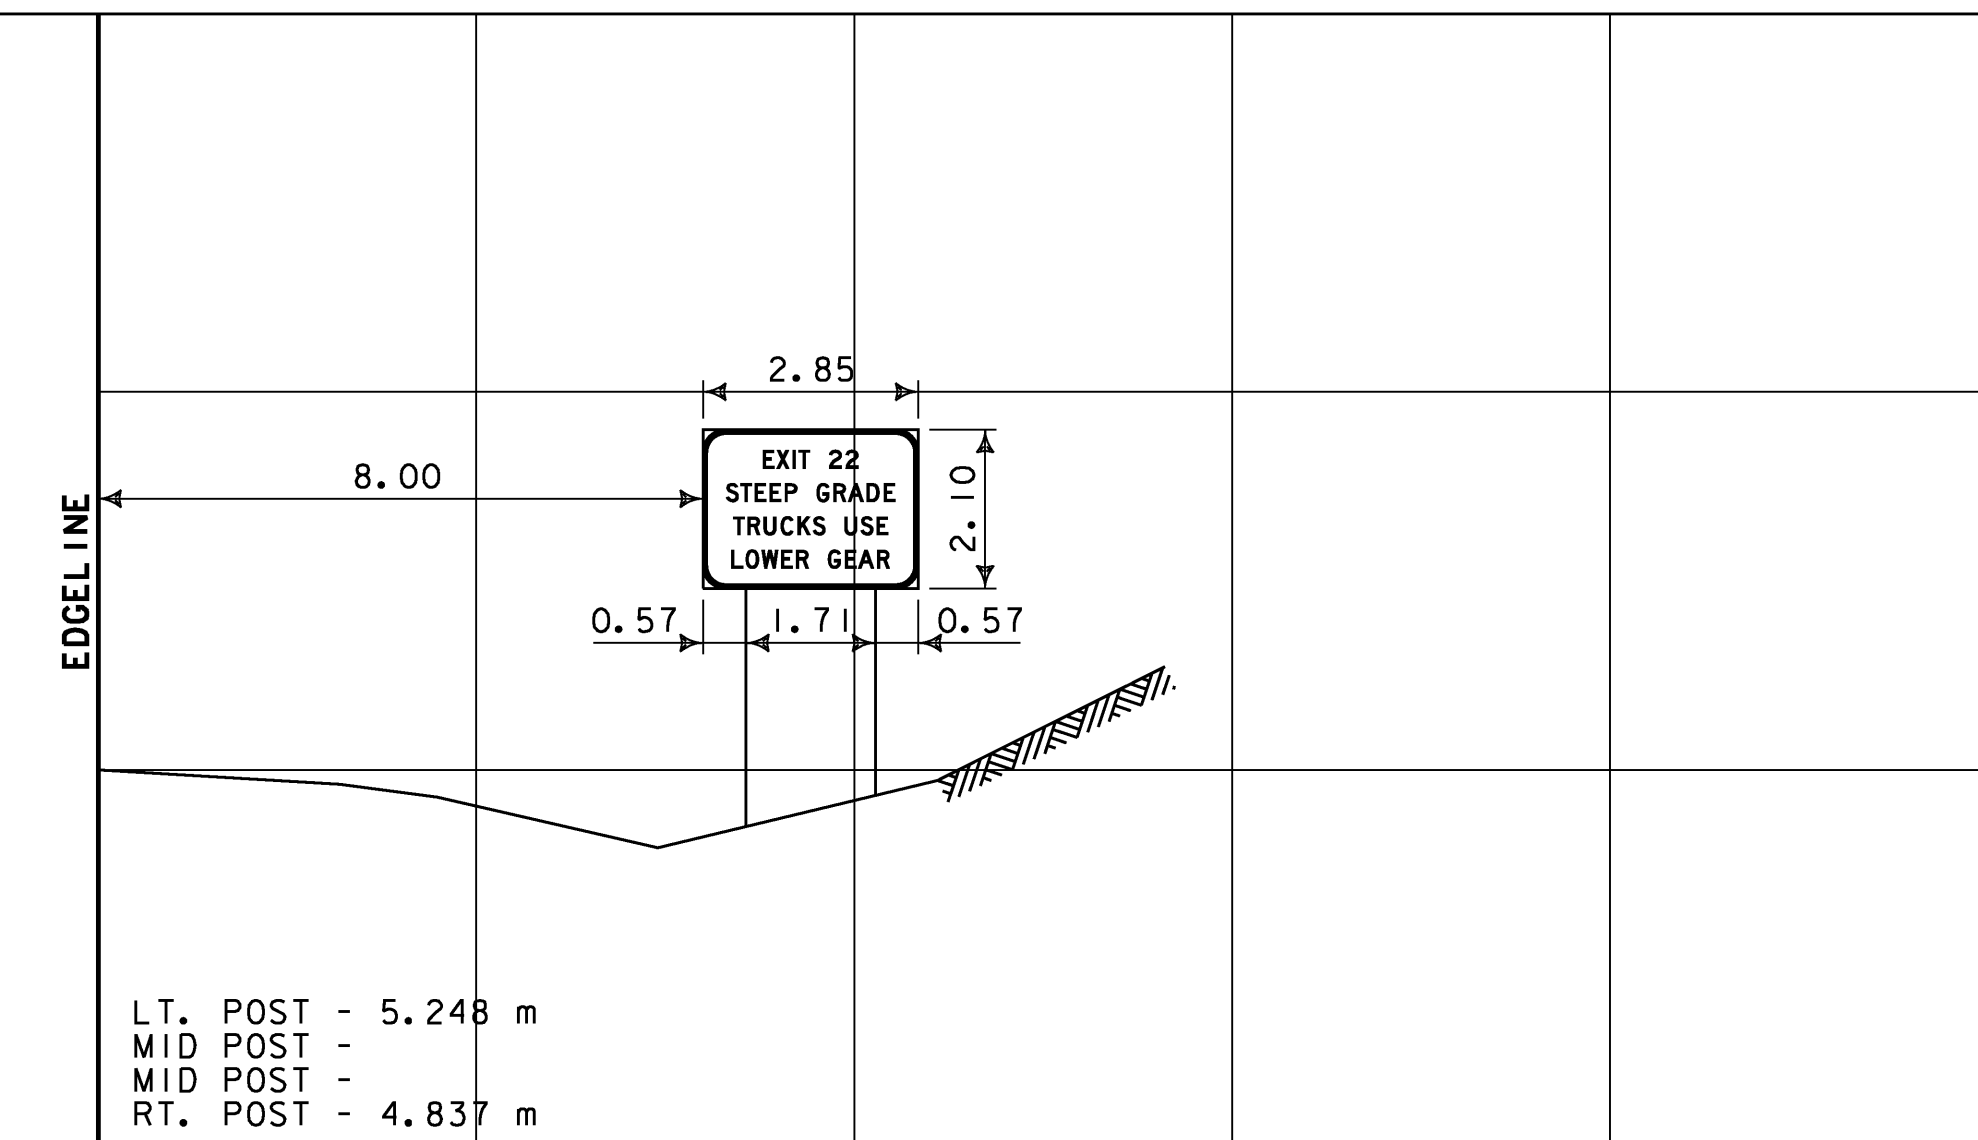


M.M. 131.040 SB

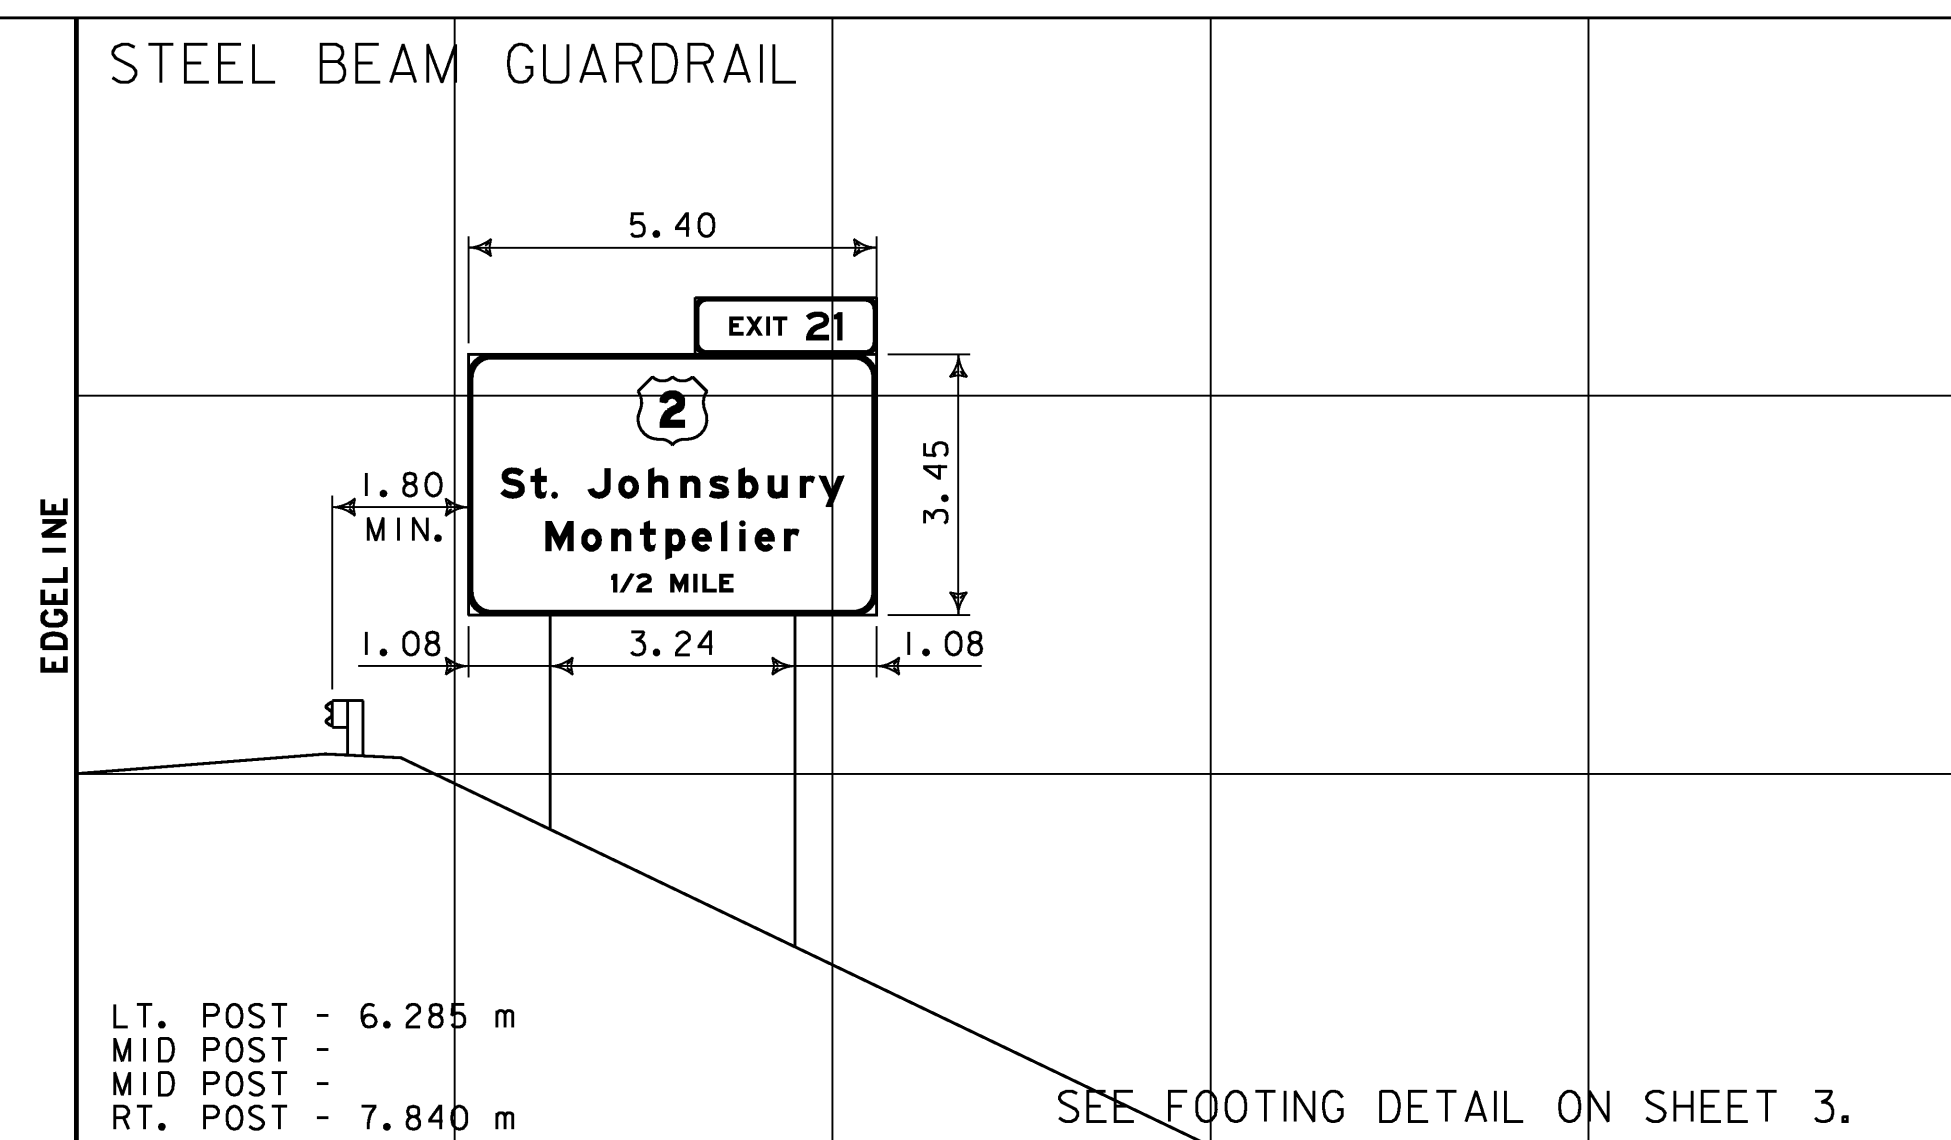


M.M. 132.950 SB

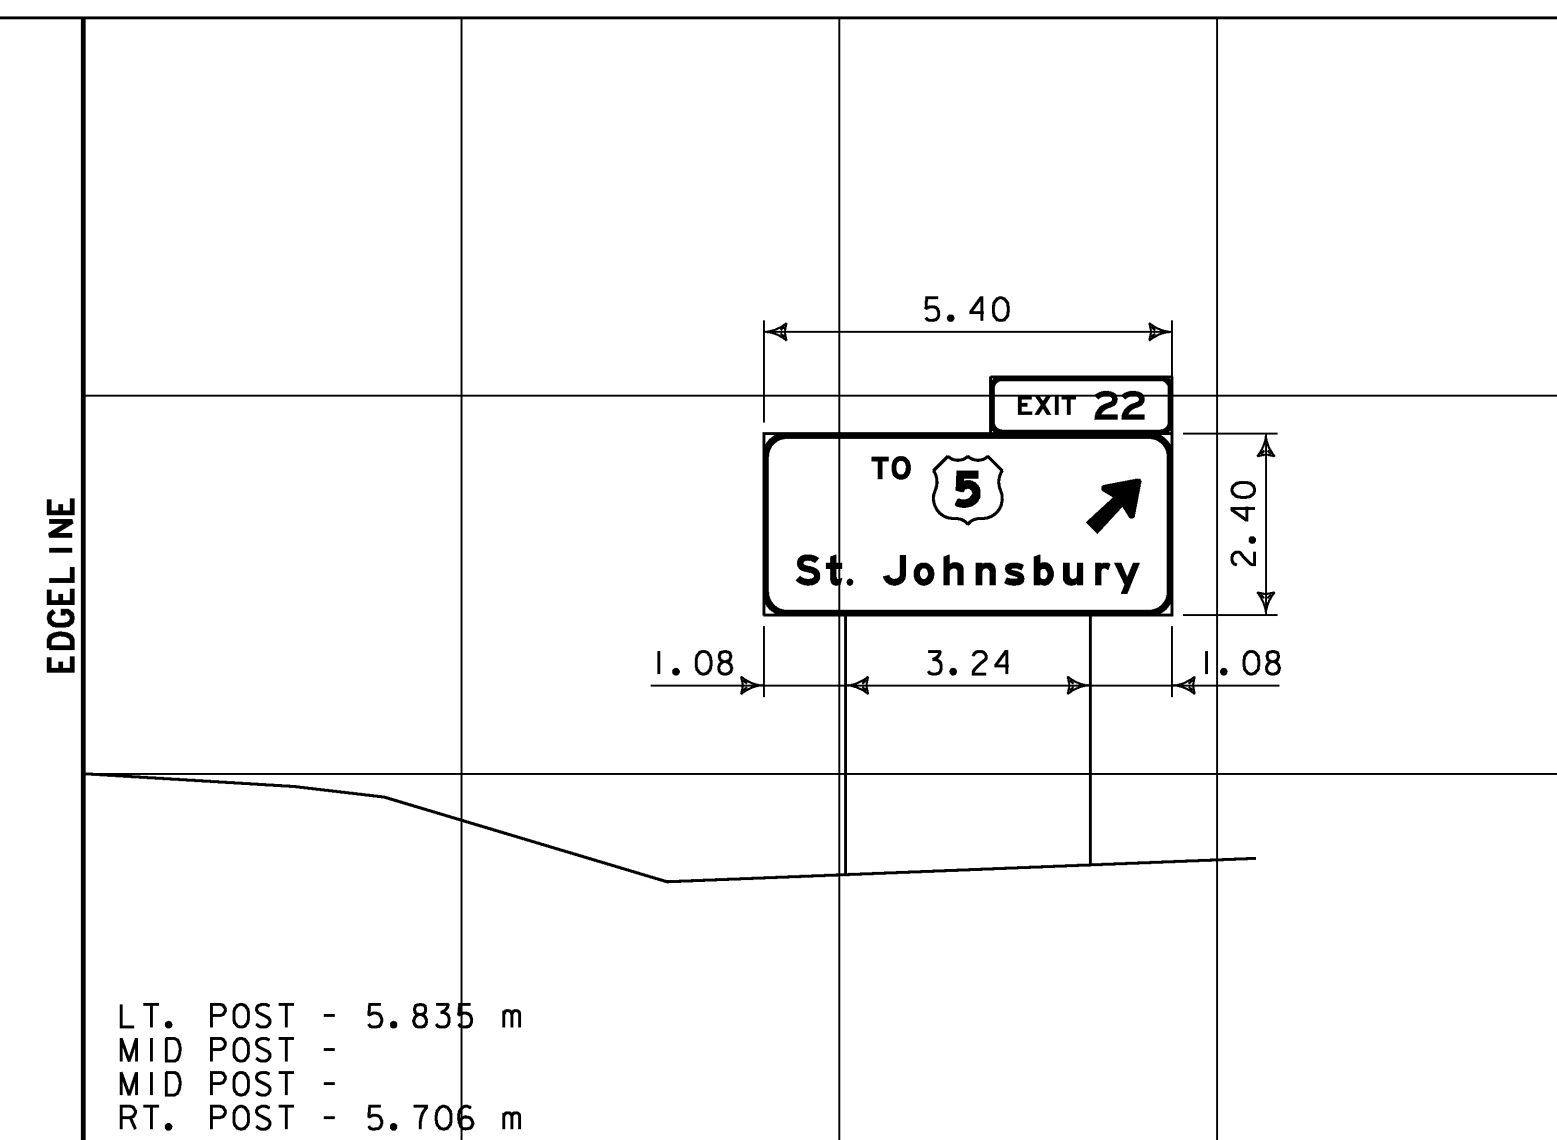



M.M. 133.235 SB

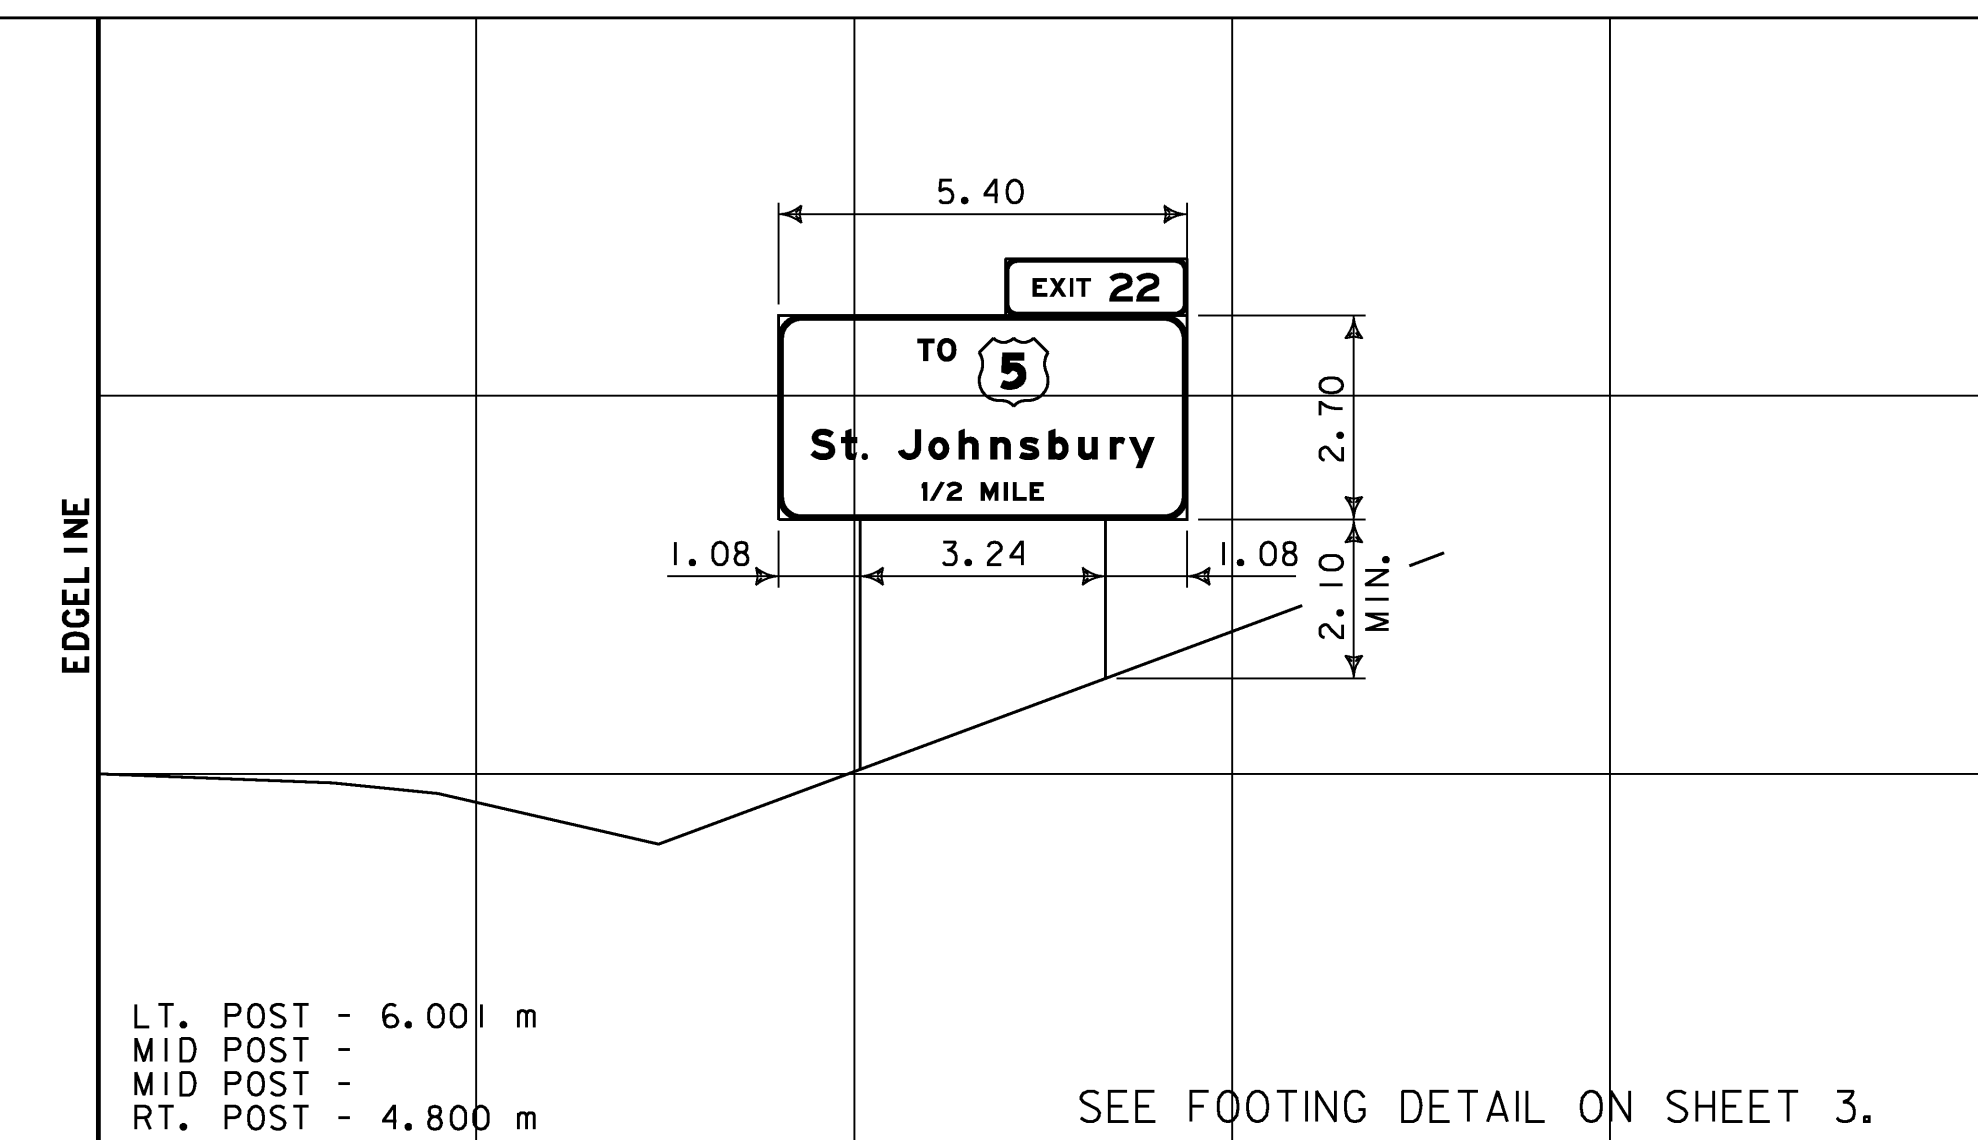

M.M. 130.870 SB

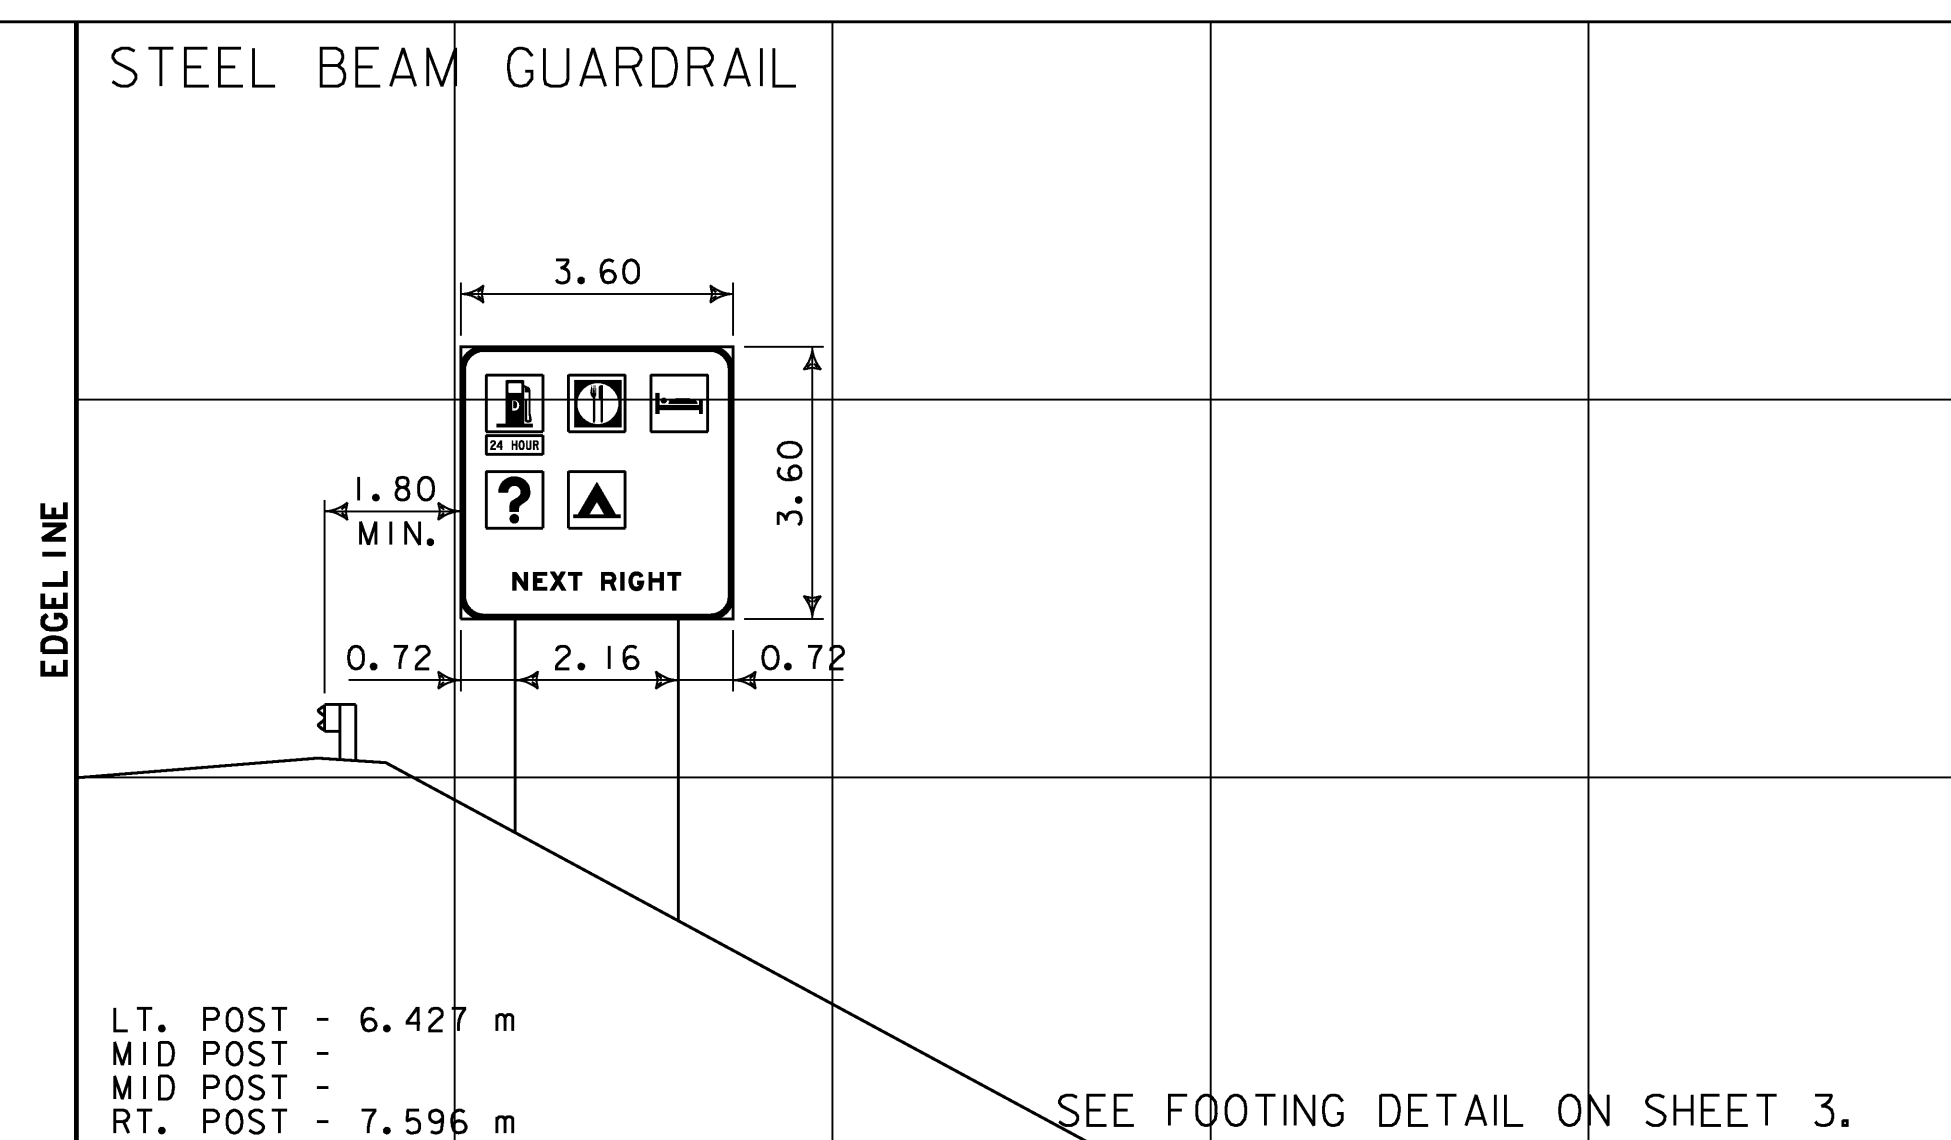

M.M. 131.540 SB

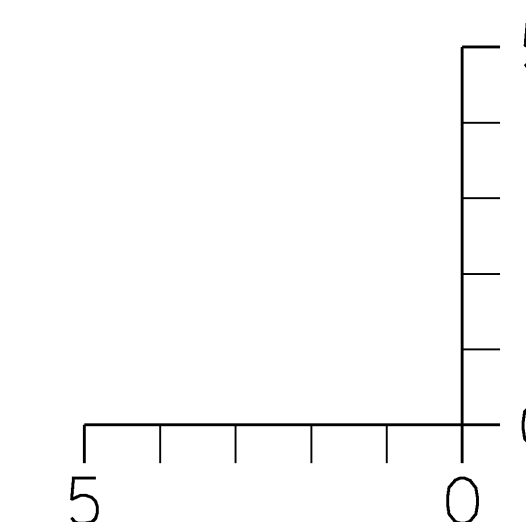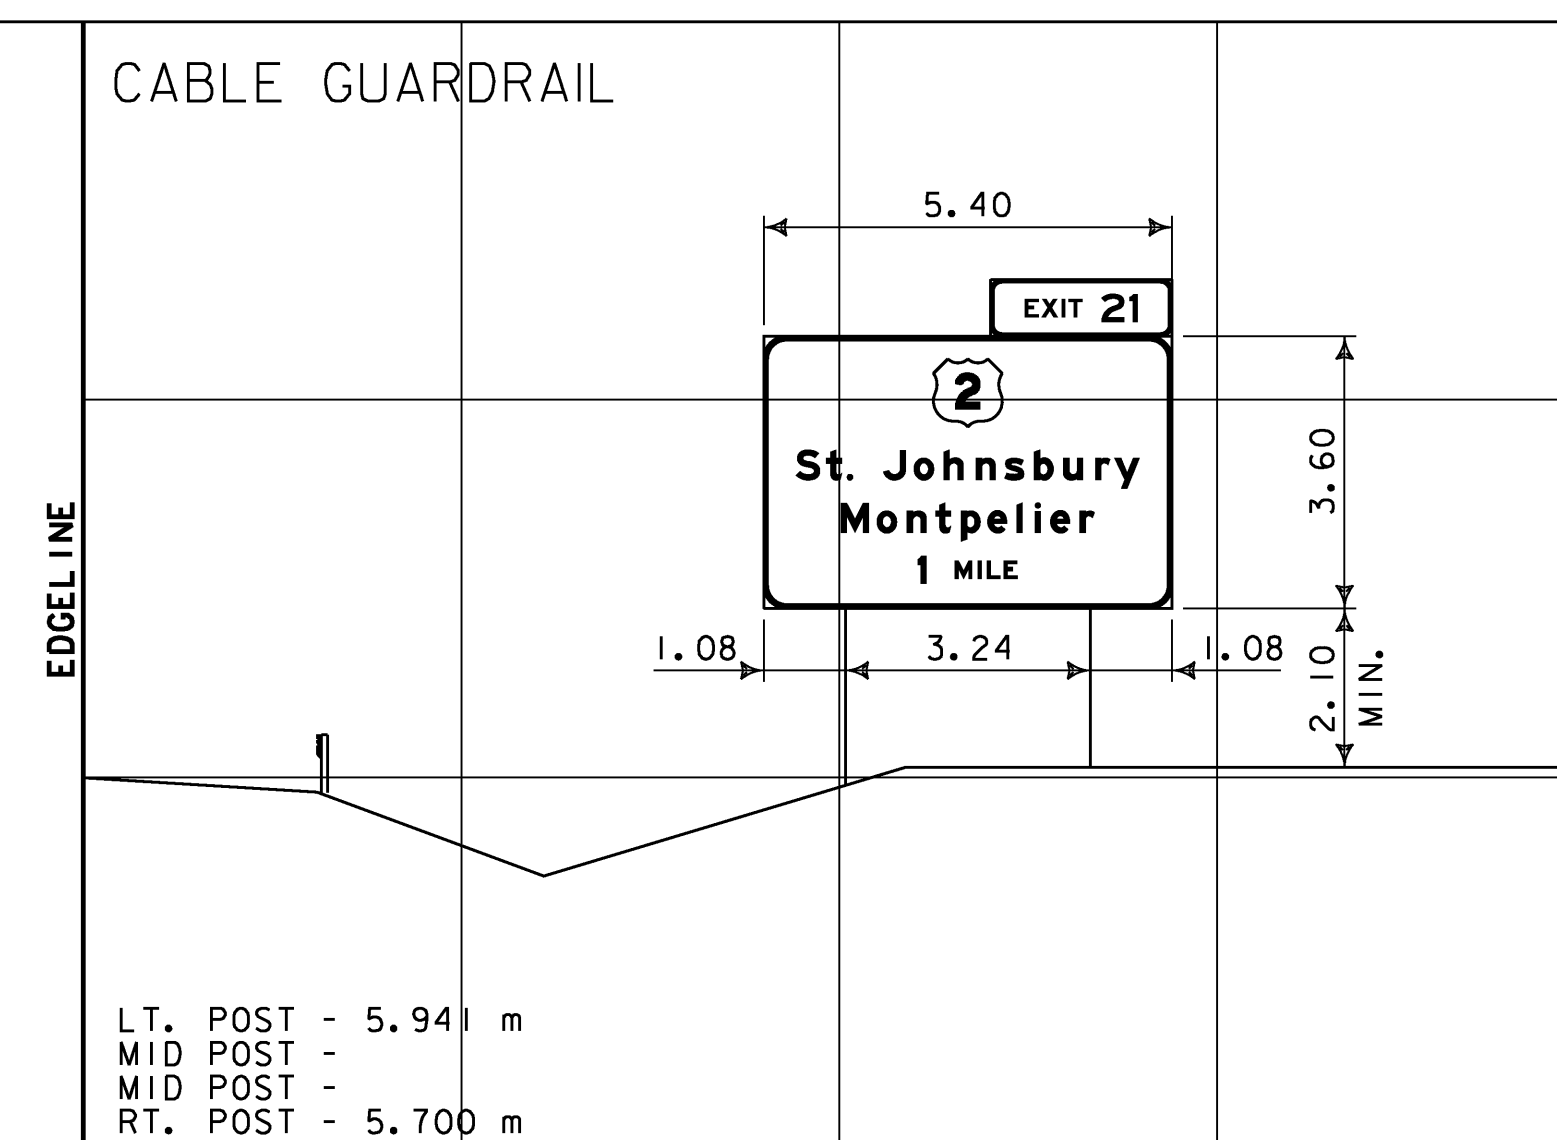

DIMENSIONS FOR CRITICAL OFFSETS OR CLEARANCES SHOWN FOR CONVENIENCE. REFER TO STANDARD SHEETS FOR PLACEMENT GUIDELINES.

SIGN CROSS SECTION SHEET 4

PROJECT NAME:	ST. JOHNSBURY-LYNDON
PROJECT NUMBER:	HES 091-3(42)
FILE NAME:	9721la-xs.dgn
PROJECT LEADER:	CRB
DESIGNED BY:	DAM
CLD REF. NO.:	97-0211
PLOT DATE:	1/4/2007
DRAWN BY:	HJC
CHECKED BY:	DAM
SHEET 74 OF 130	