




M.M. 133.950 SB

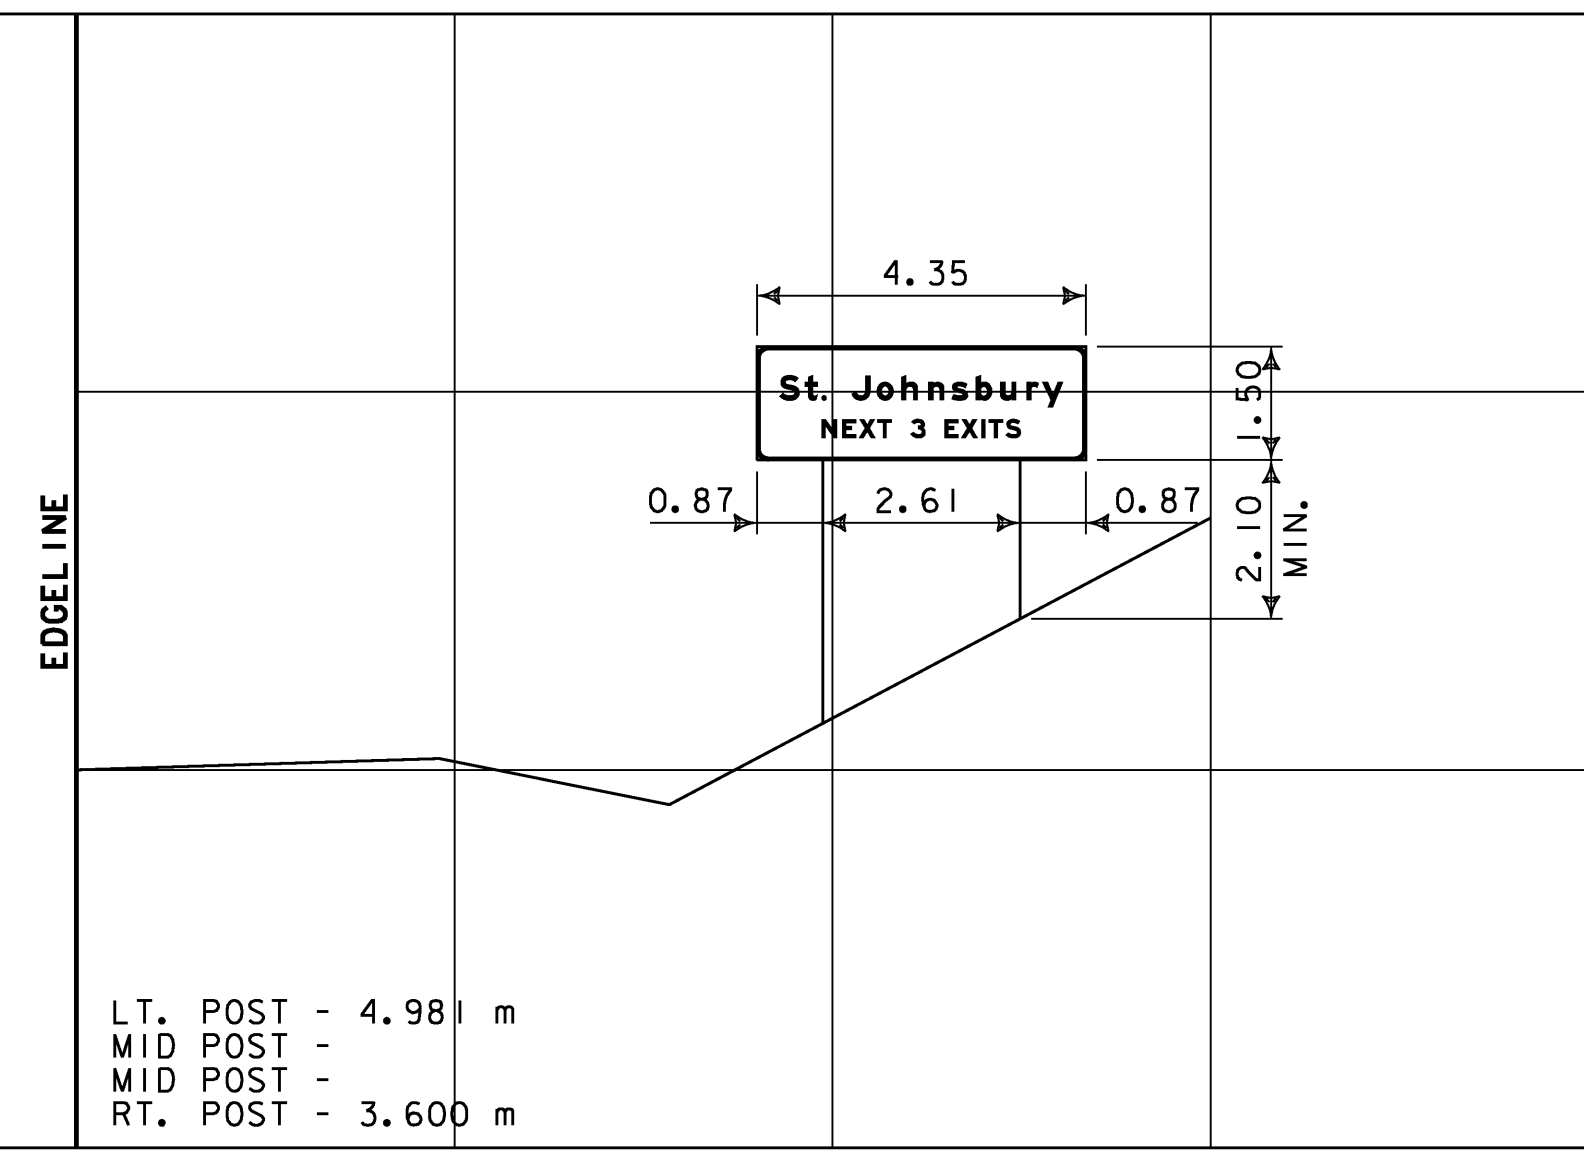


M.M. 137.614 SB

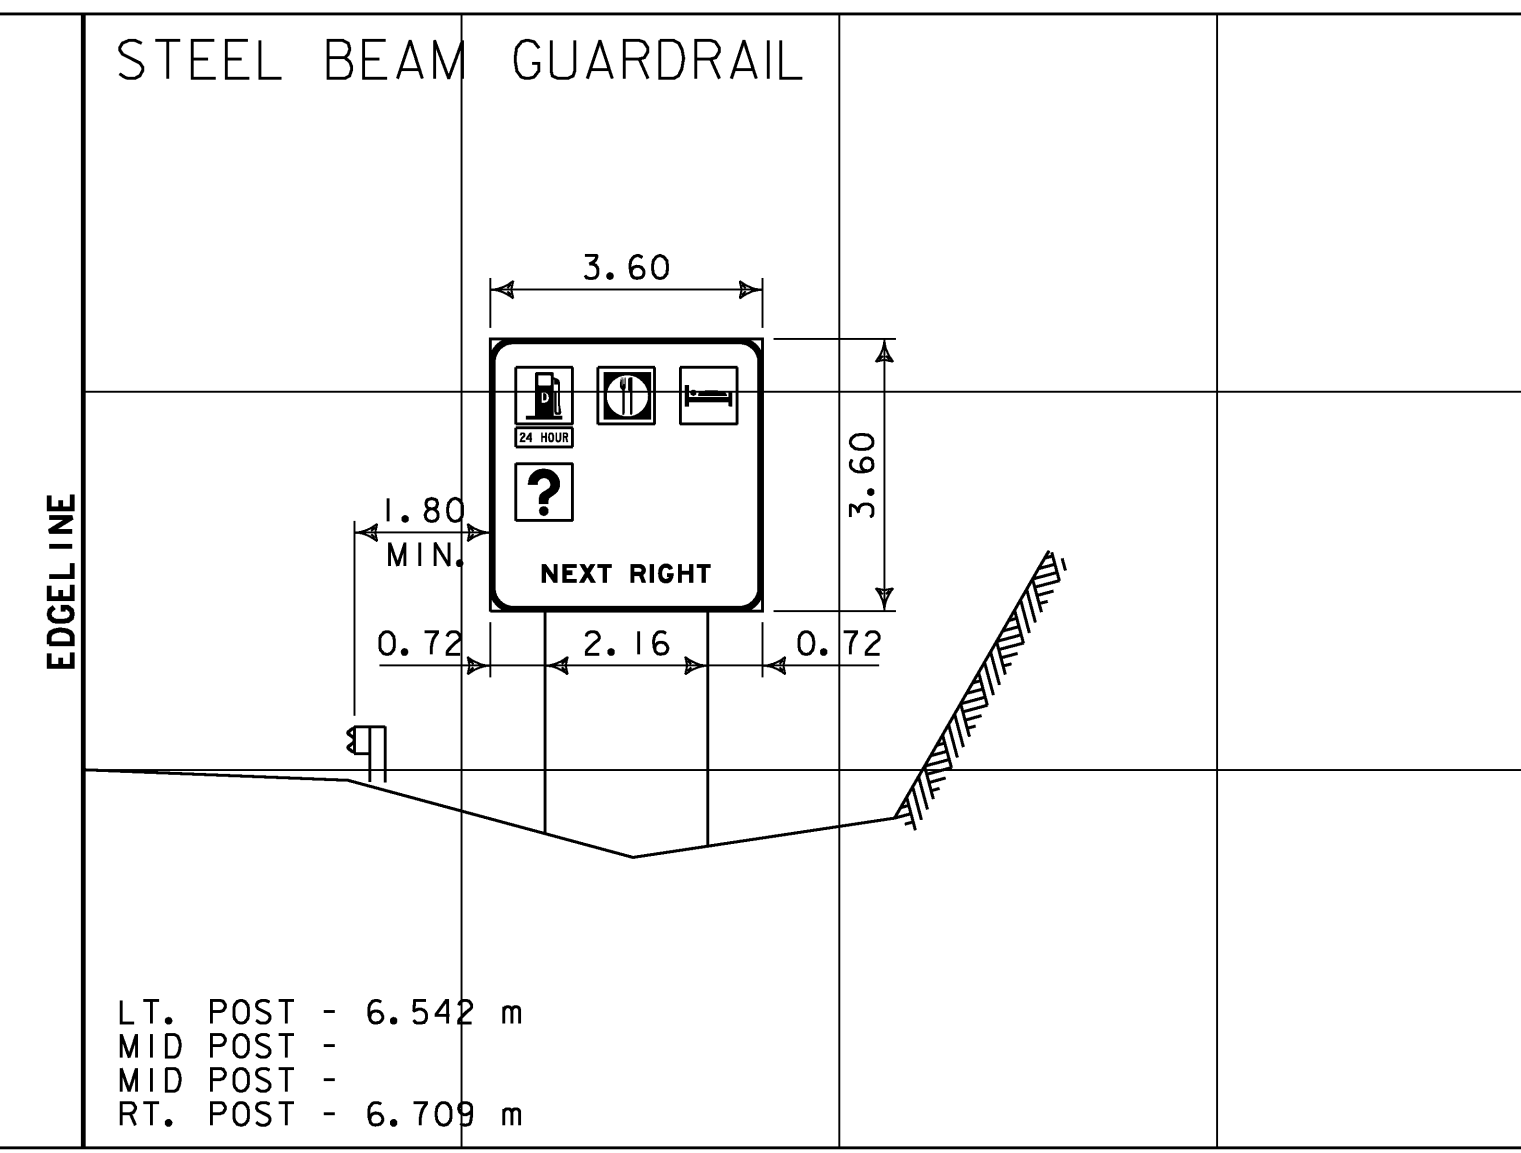


M.M. 138.010 SB

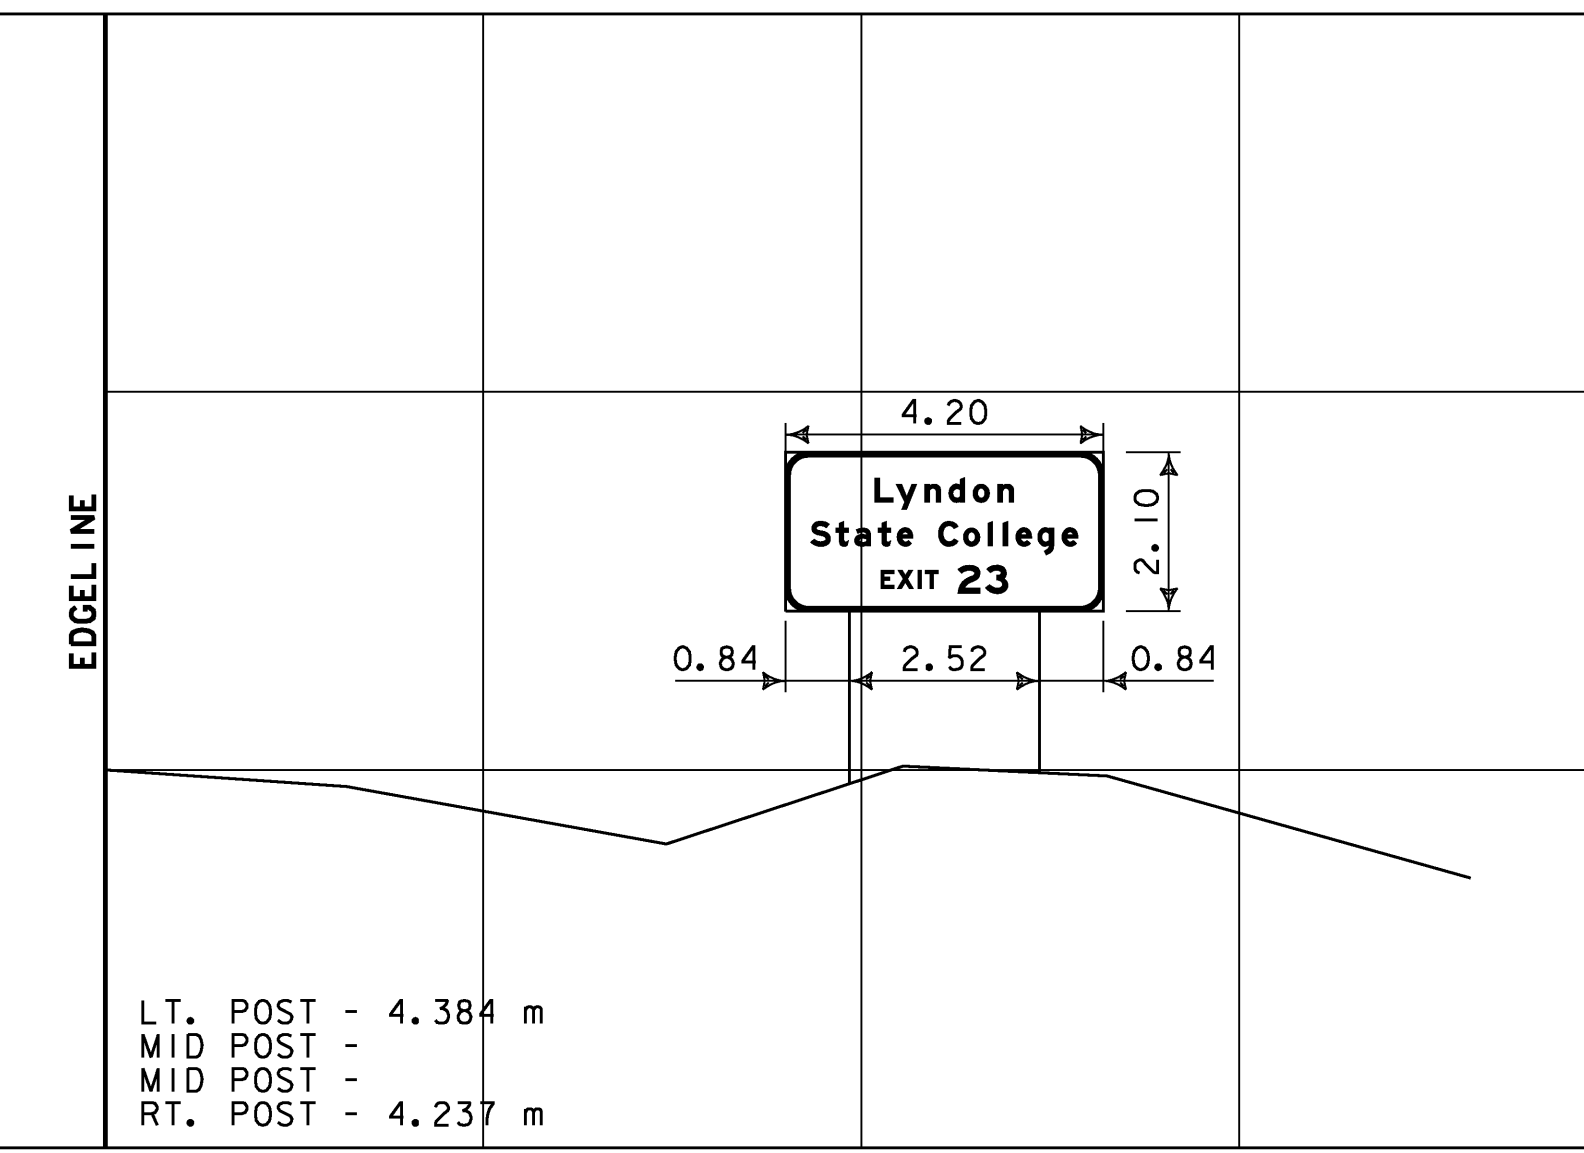


M.M. 133.691 SB

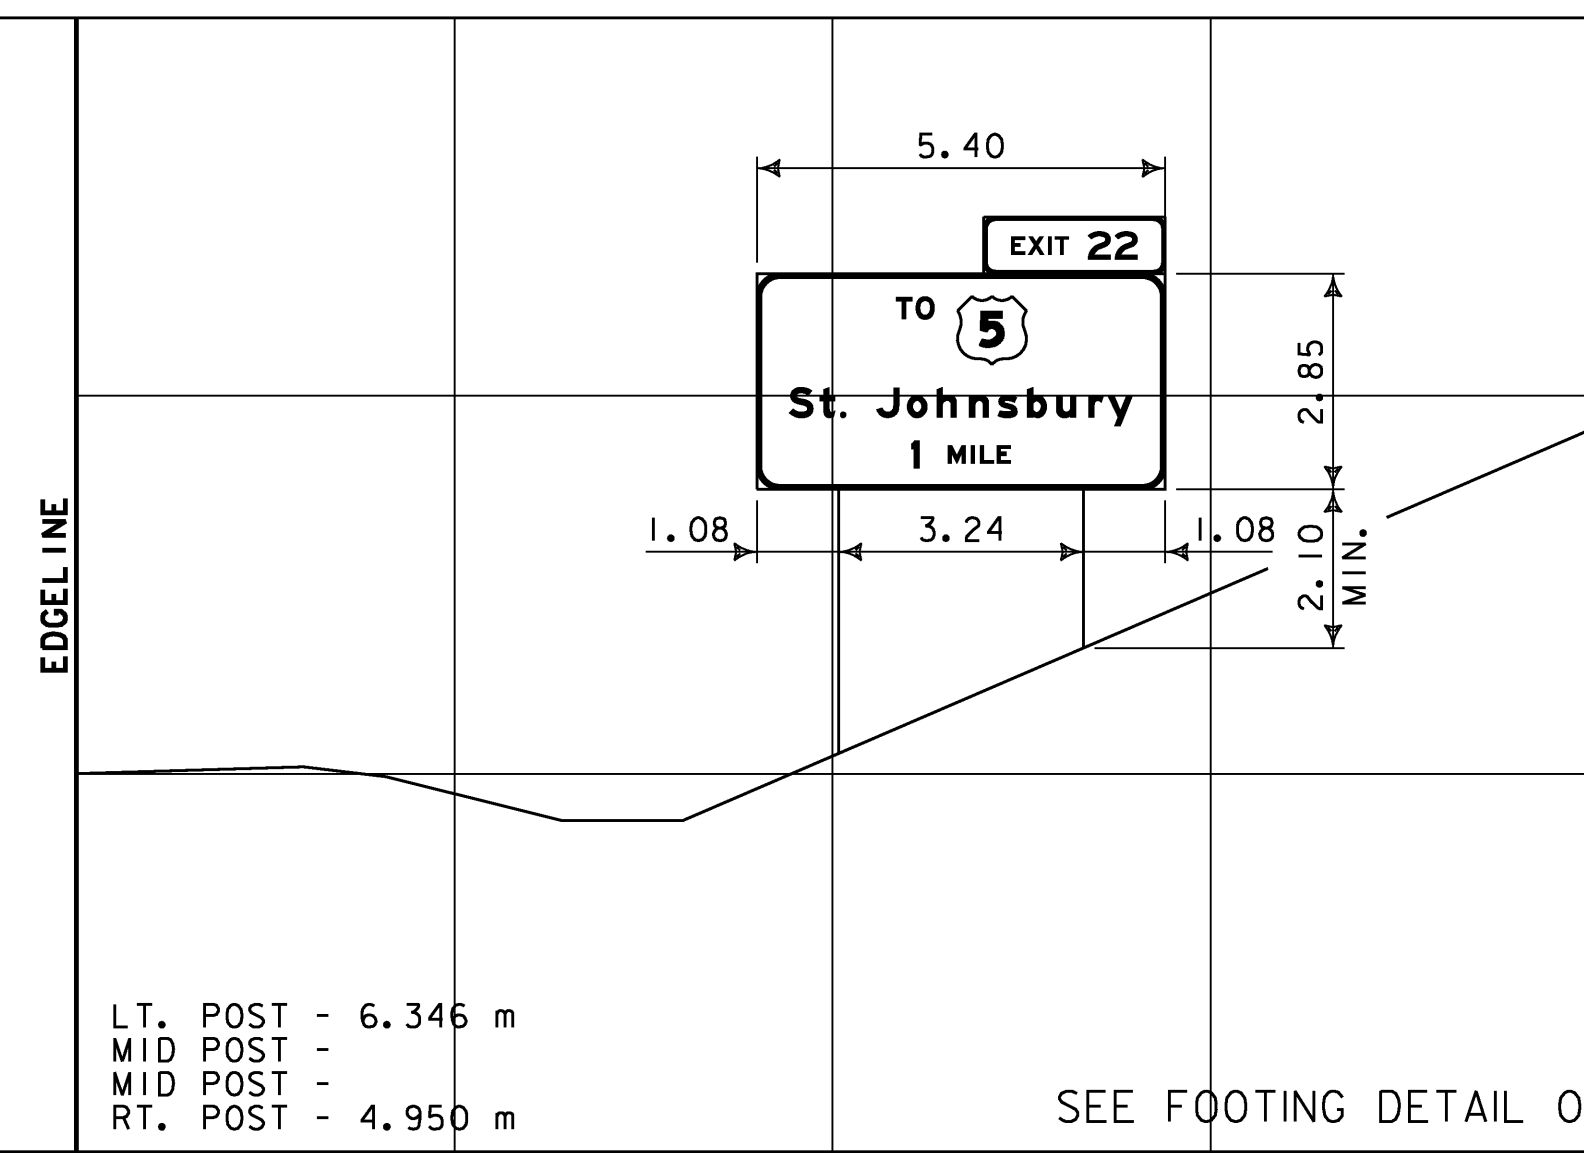


M.M. 137.400 SB

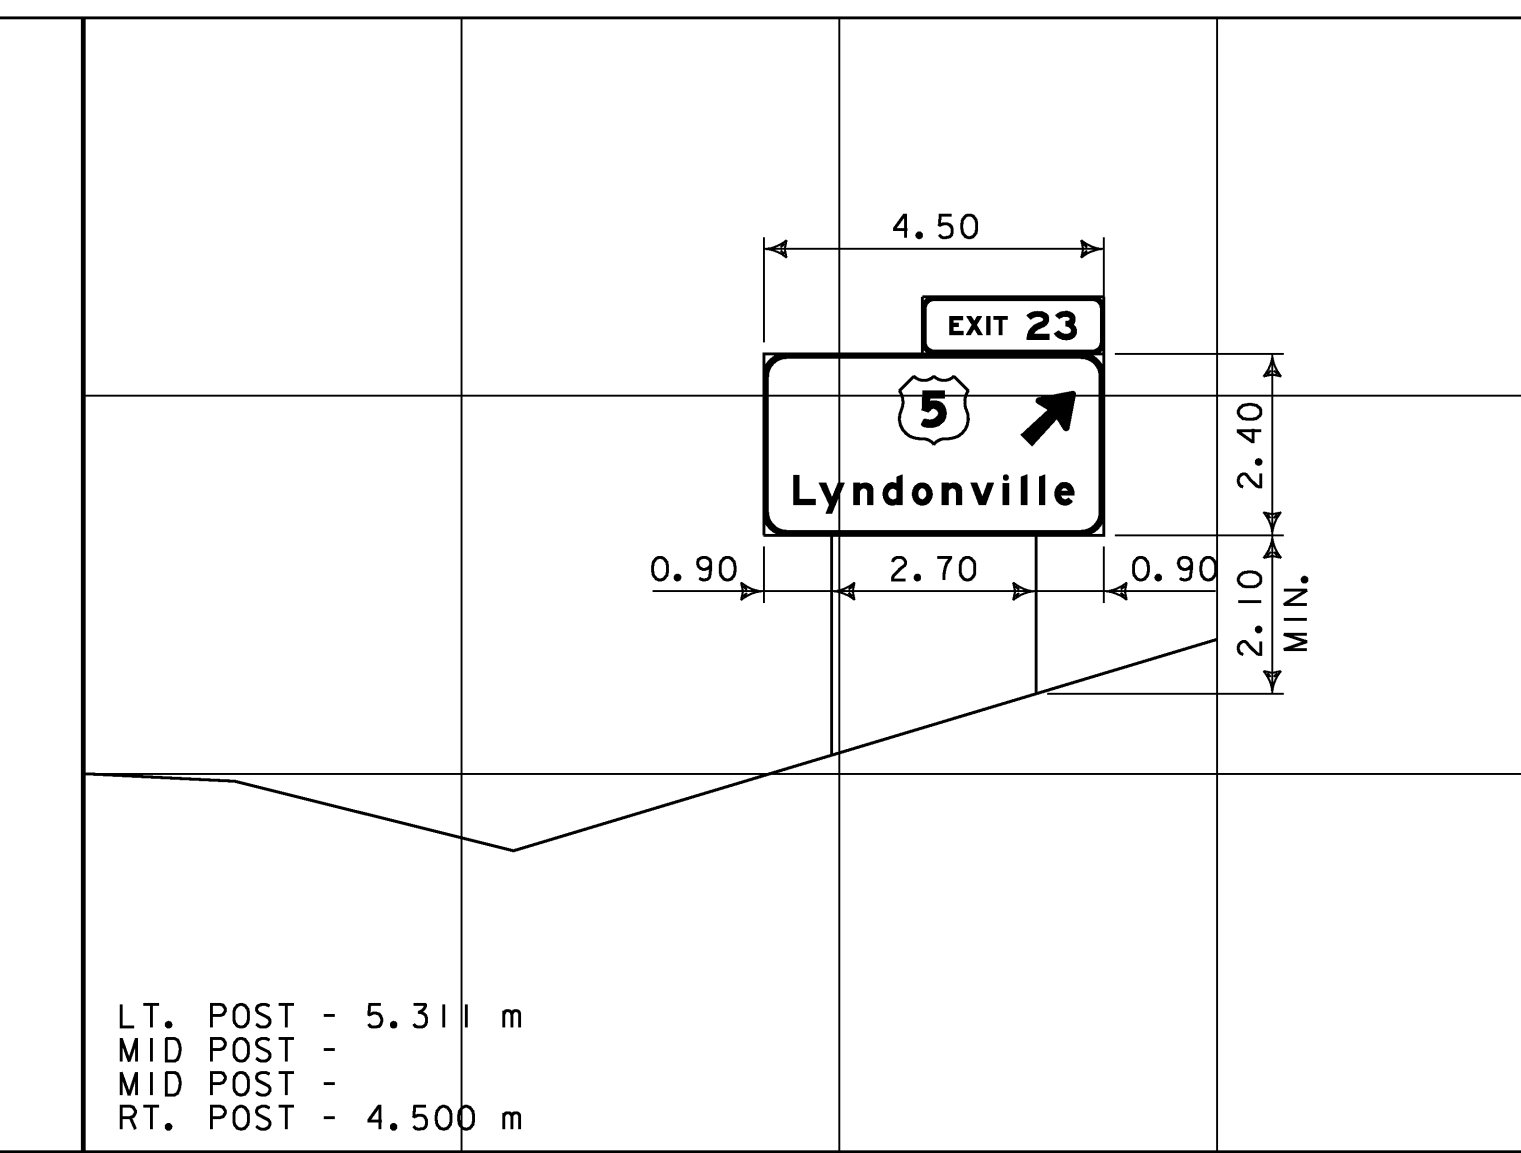



M.M. 137.764 SB

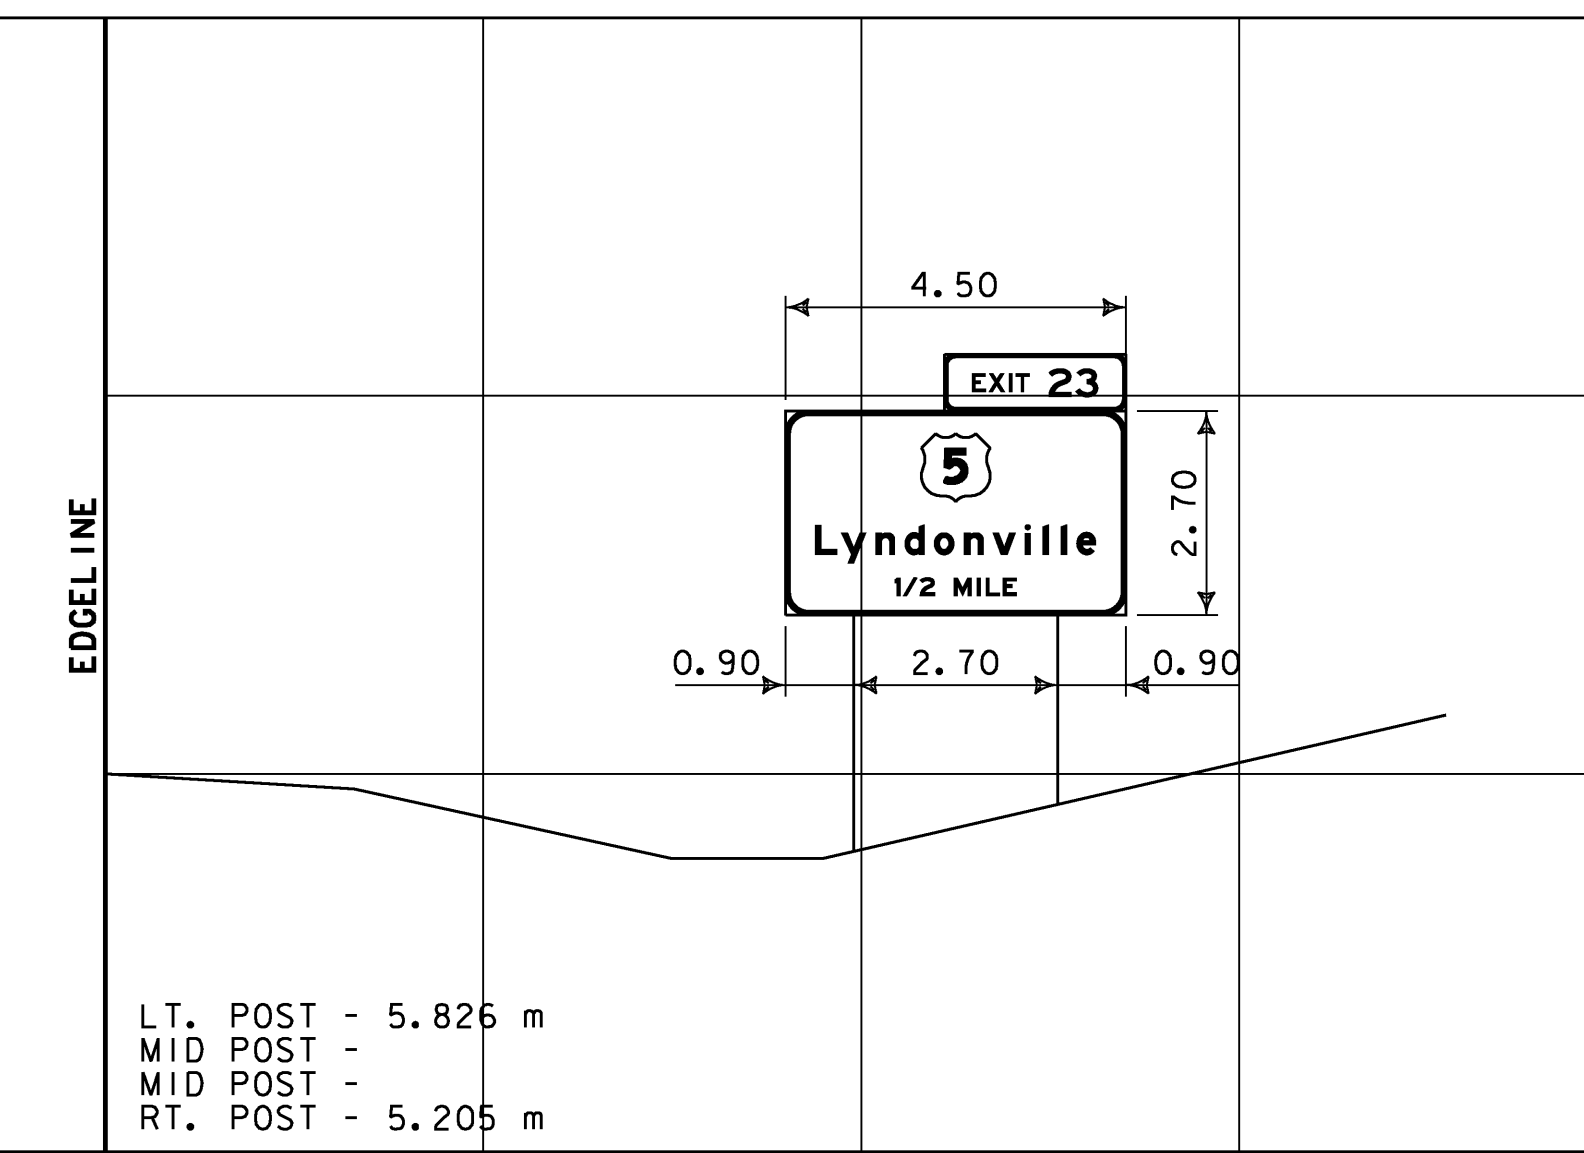

M.M. 133.500 SB

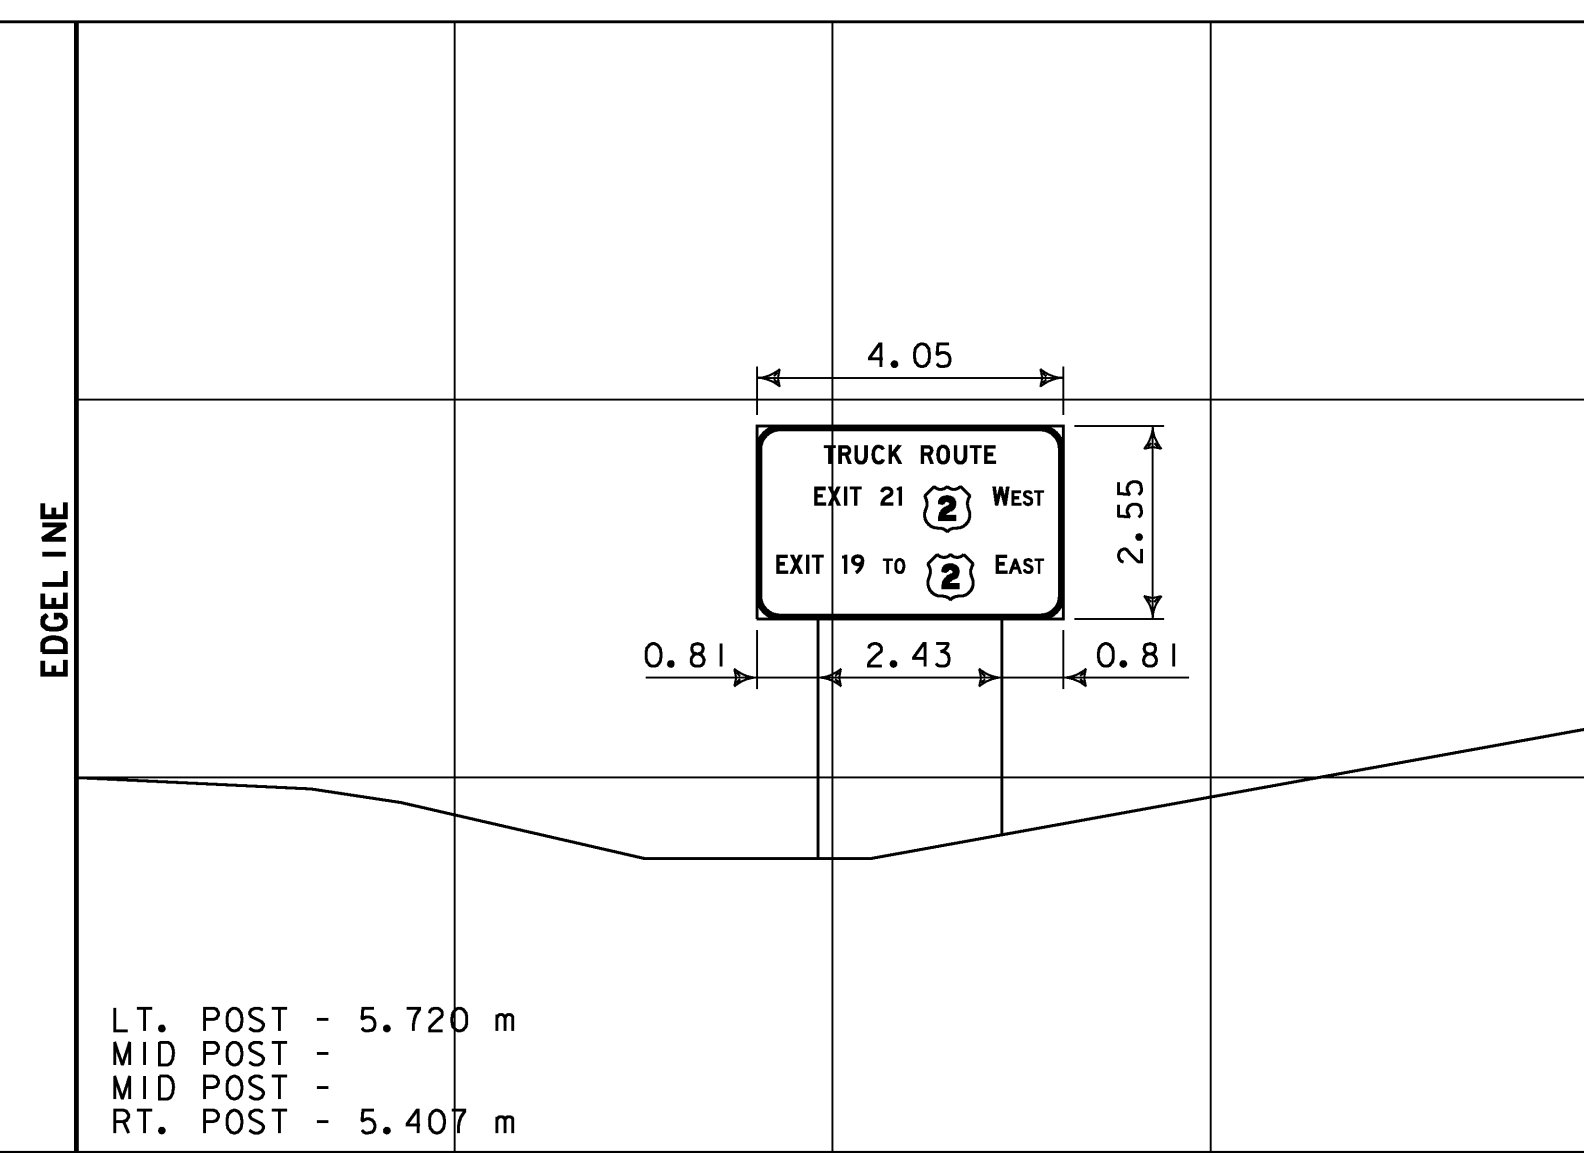

M.M. 136.175 SB

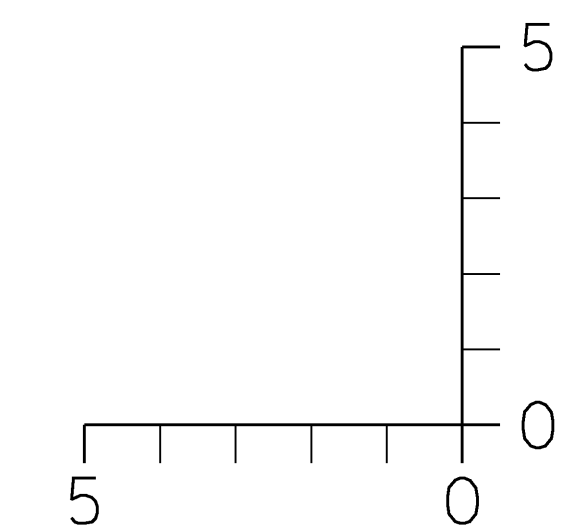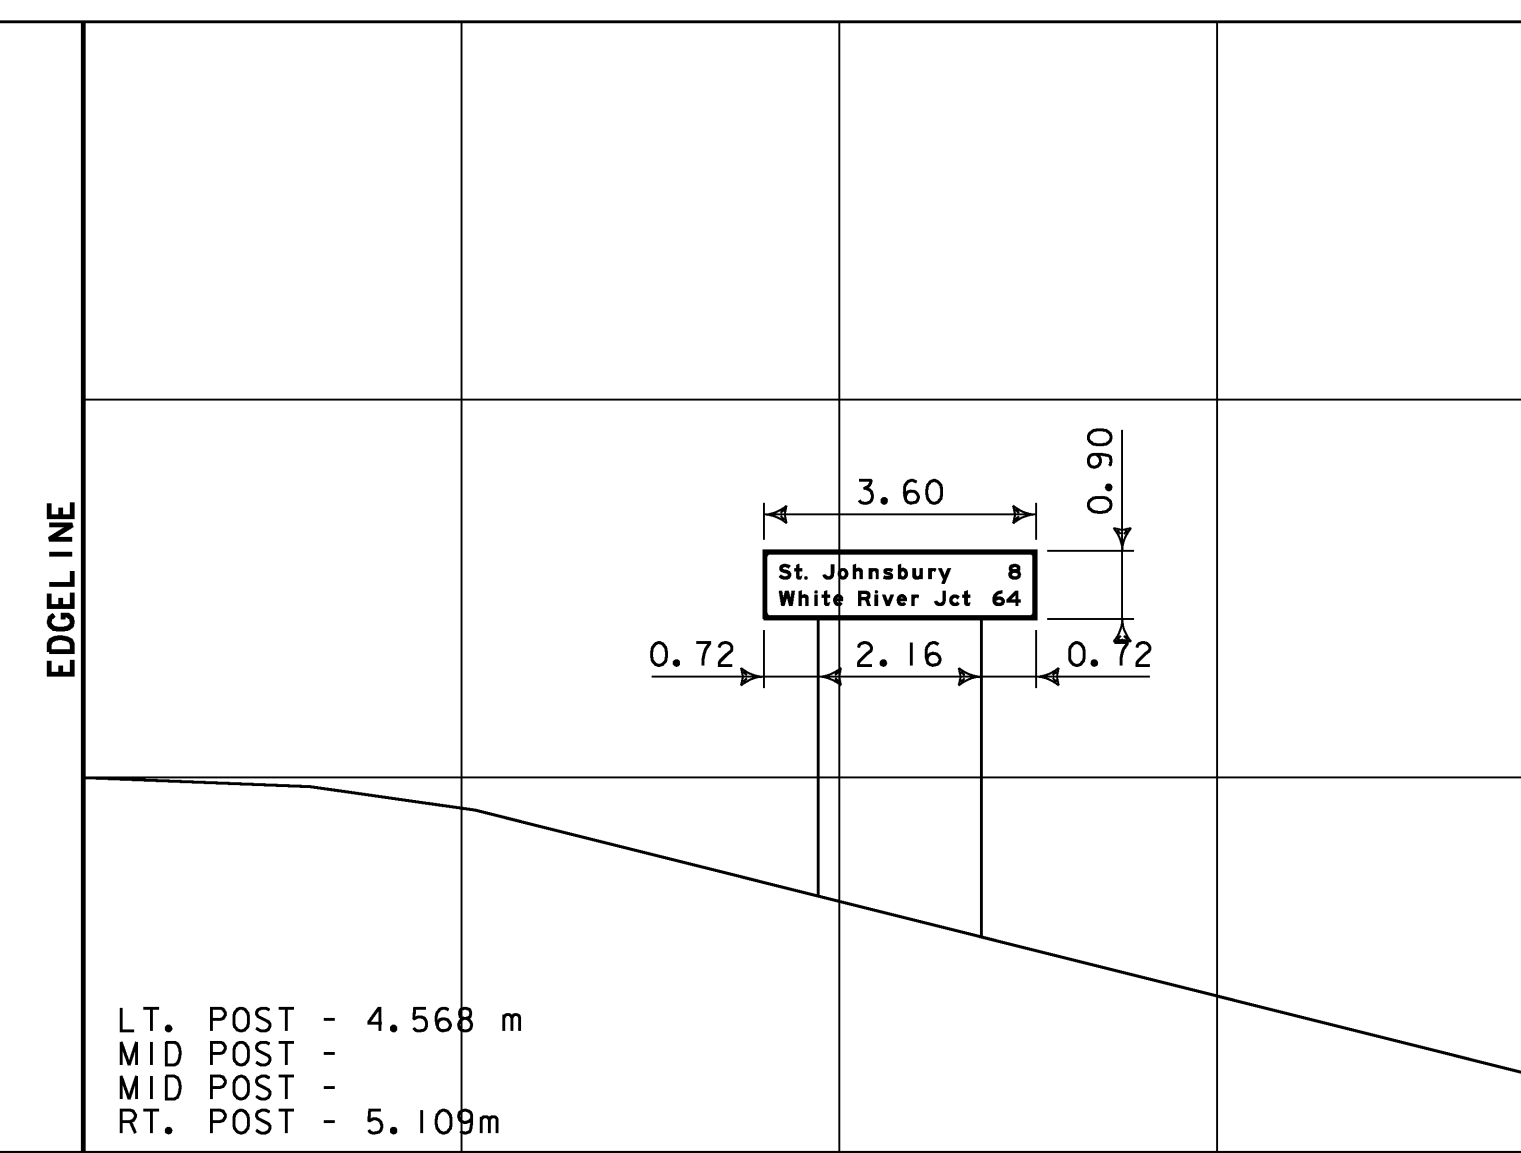

DIMENSIONS FOR CRITICAL OFFSETS OR CLEARANCES SHOWN FOR CONVENIENCE. REFER TO STANDARD SHEETS FOR PLACEMENT GUIDELINES.

SIGN CROSS SECTION SHEET 5

PROJECT NAME:	ST. JOHNSBURY-LYNDON
PROJECT NUMBER:	HES 091-3(42)
FILE NAME:	9721la-xs.dgn
PROJECT LEADER:	CRB
DESIGNED BY:	DAM
CLD REF. NO.:	97-0211
PLOT DATE:	1/4/2007
DRAWN BY:	HJC
CHECKED BY:	DAM
SHEET	75 OF 130