
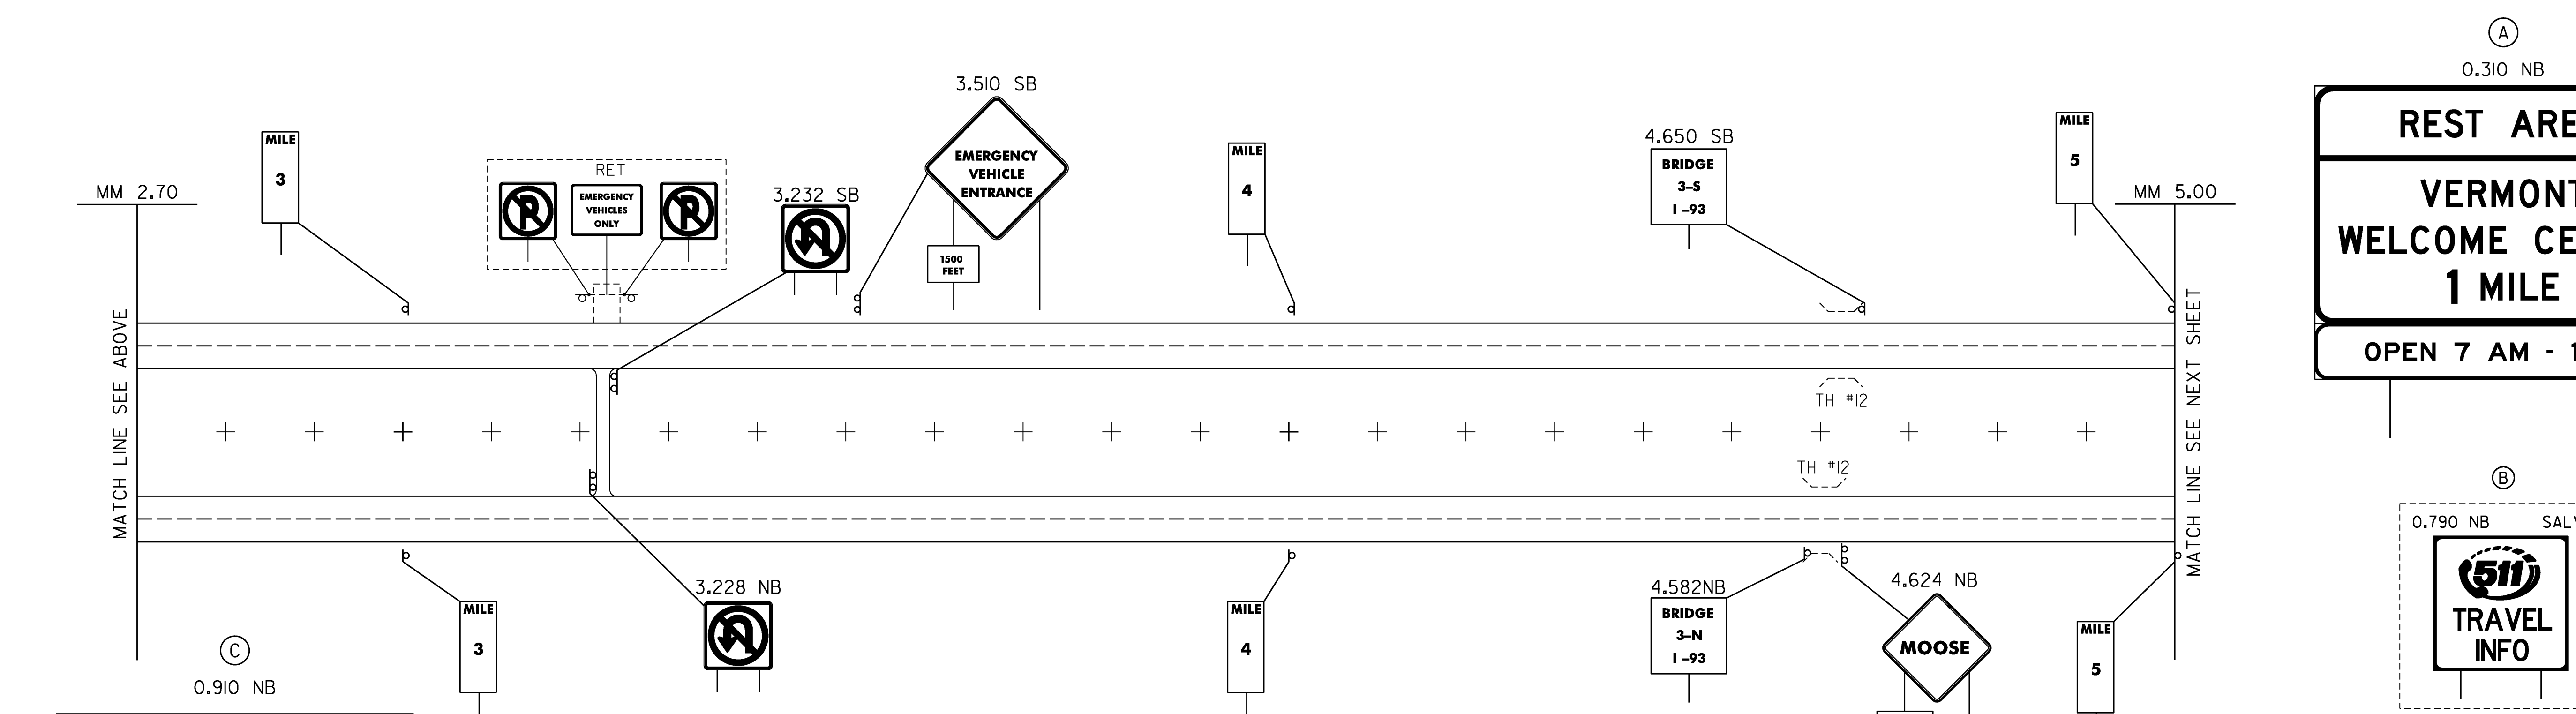


BEGIN PROJECT
HES 093-1(10)
(MM 0.00)

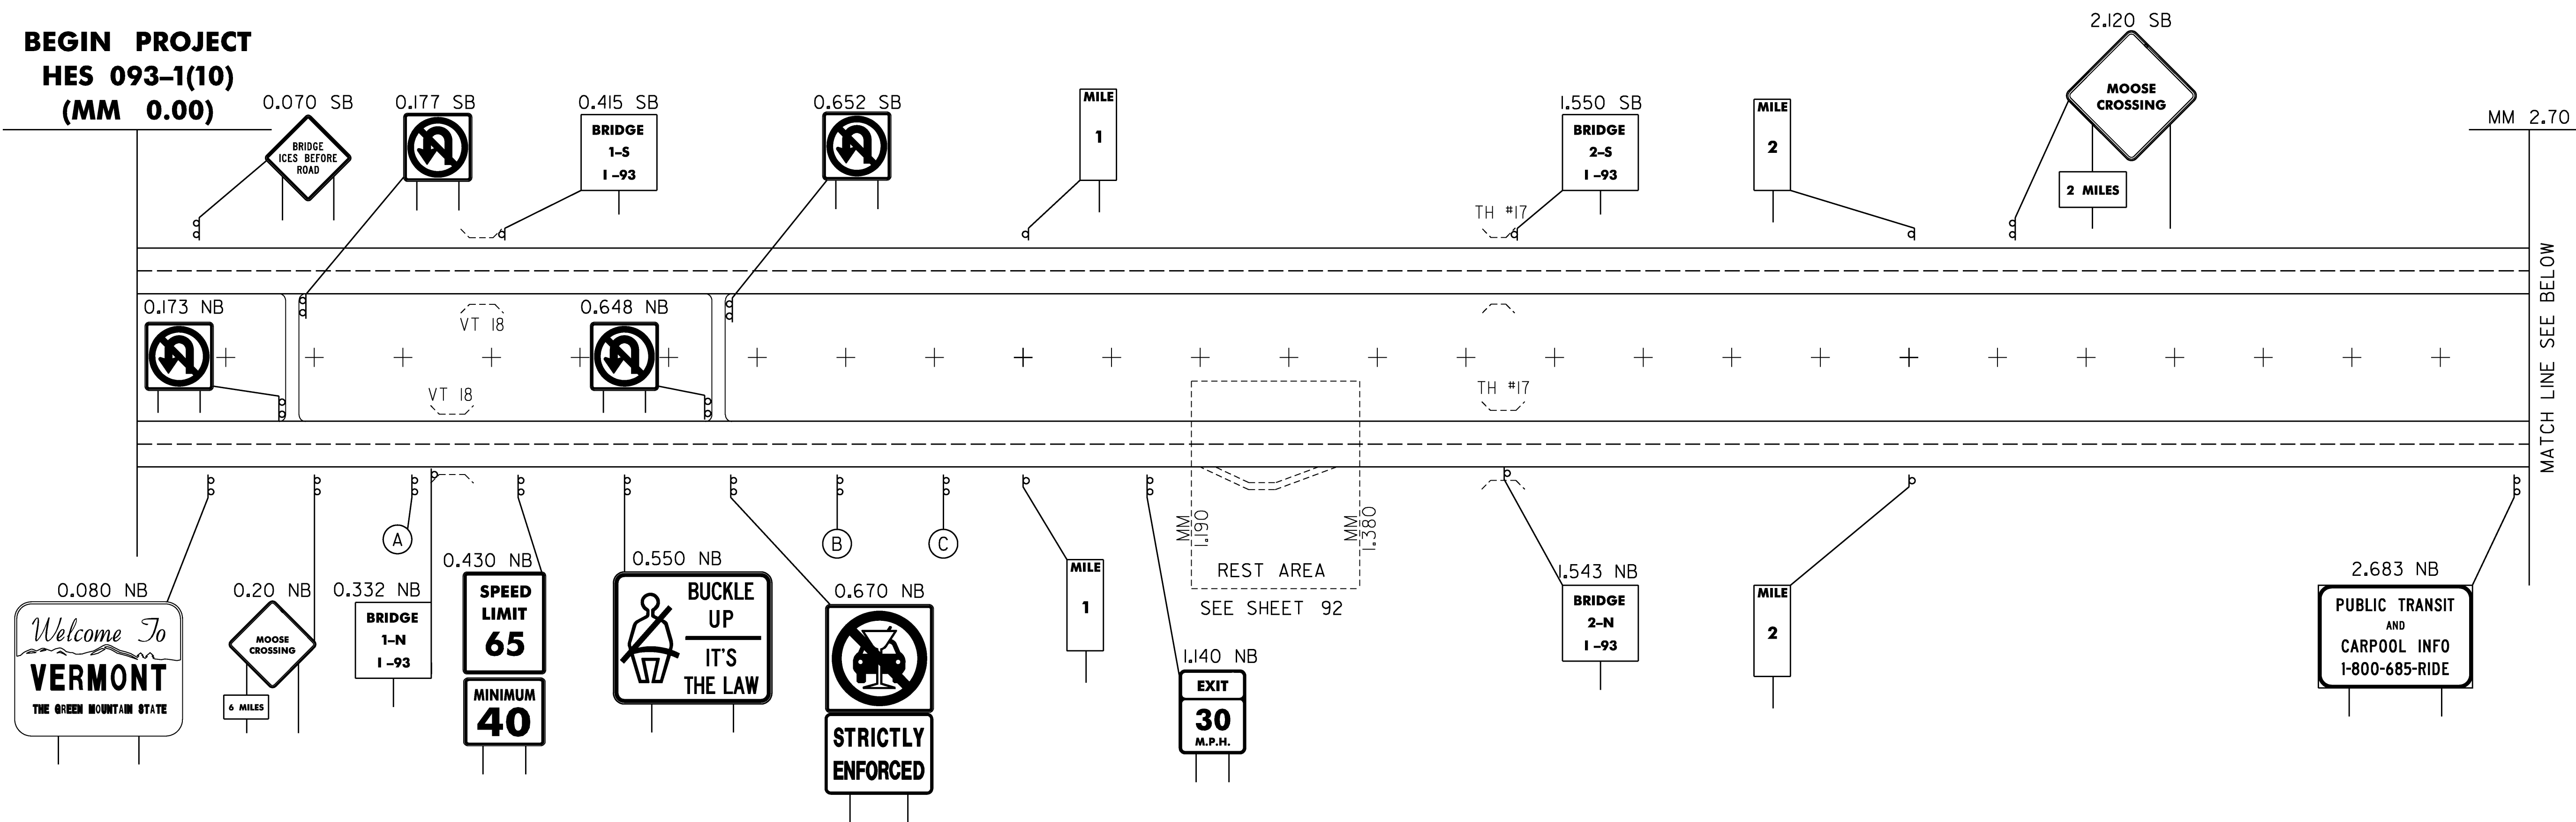

LEGEND
 [Dashed Box] RET - RETAINED
 [Dotted Box] SALV - SALVAGED

ALL SIGNS AND POSTS ARE NEW UNLESS OTHERWISE NOTED

NEW SIGNS	PROJECT NAME: WATERFORD	PLOT DATE: 1/4/2007
	PROJECT NUMBER: HES 093-1(10)	DRAWN BY: HJC
	FILE NAME: 9721b-ml.dgn	CHECKED BY: DAM
	PROJECT LEADER: CRB	SHEET 89 OF 130
	DESIGNED BY: DAM	
	CLD REF. NO.: 97-0211	

REST AREA
VERMONT WELCOME CENTER
NEXT RIGHT

REST AREA
VERMONT WELCOME CENTER
1 MILE
OPEN 7 AM - 11 PM

511 TRAVEL INFO