


DURABLE 200 mm WHITE LINE (SOLID)  
 10.970 NB C/L TO 11.100 NB C/L (209 m)  
 11.100 NB C/L TO 0.057 EXIT 19 RAMP C (Theoretical Gore) (92 m)

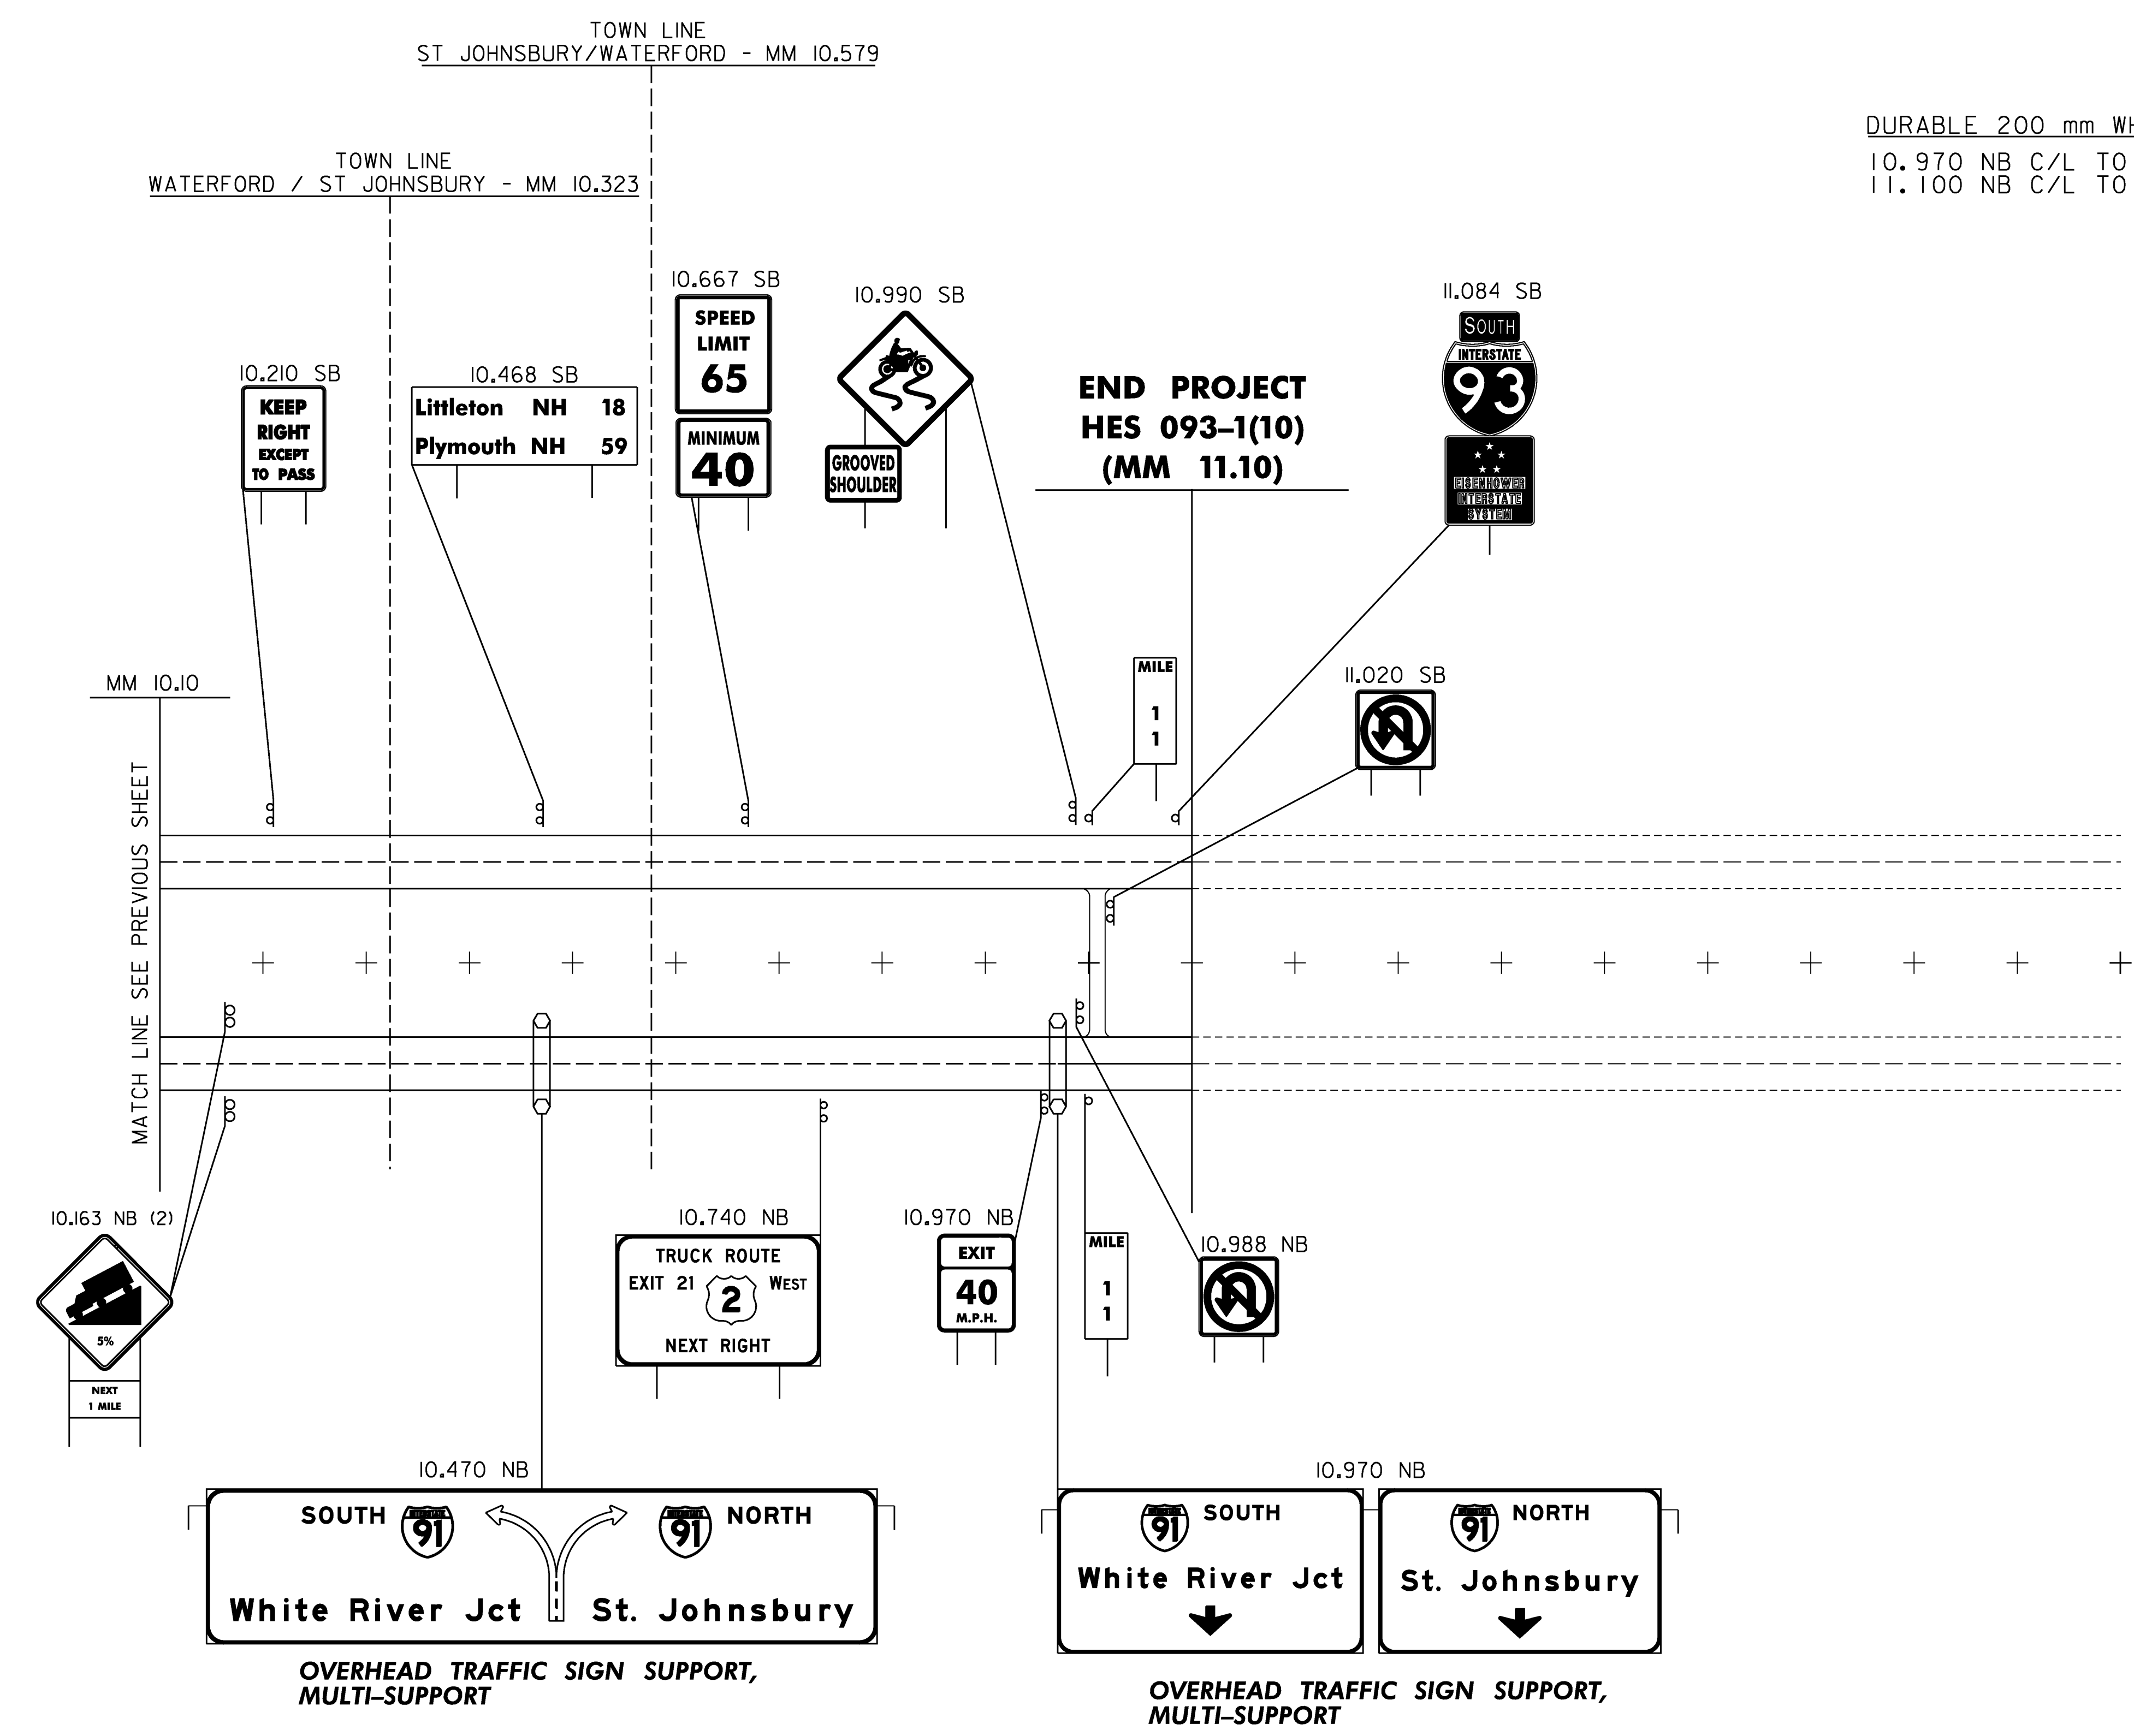

**ALL SIGNS AND POSTS ARE NEW UNLESS OTHERWISE NOTED**

**NEW SIGNS**

PROJECT NAME:	WATERFORD
PROJECT NUMBER:	HES 093-1(10)
FILE NAME:	9721b-m1.dgn
PROJECT LEADER:	CRB
DESIGNED BY:	DAM
CLD REF. NO.:	97-0211
PLOT DATE:	1/4/2007
DRAWN BY:	HJC
CHECKED BY:	DAM
SHEET	91 OF 130