




M.M. 8.214 SB

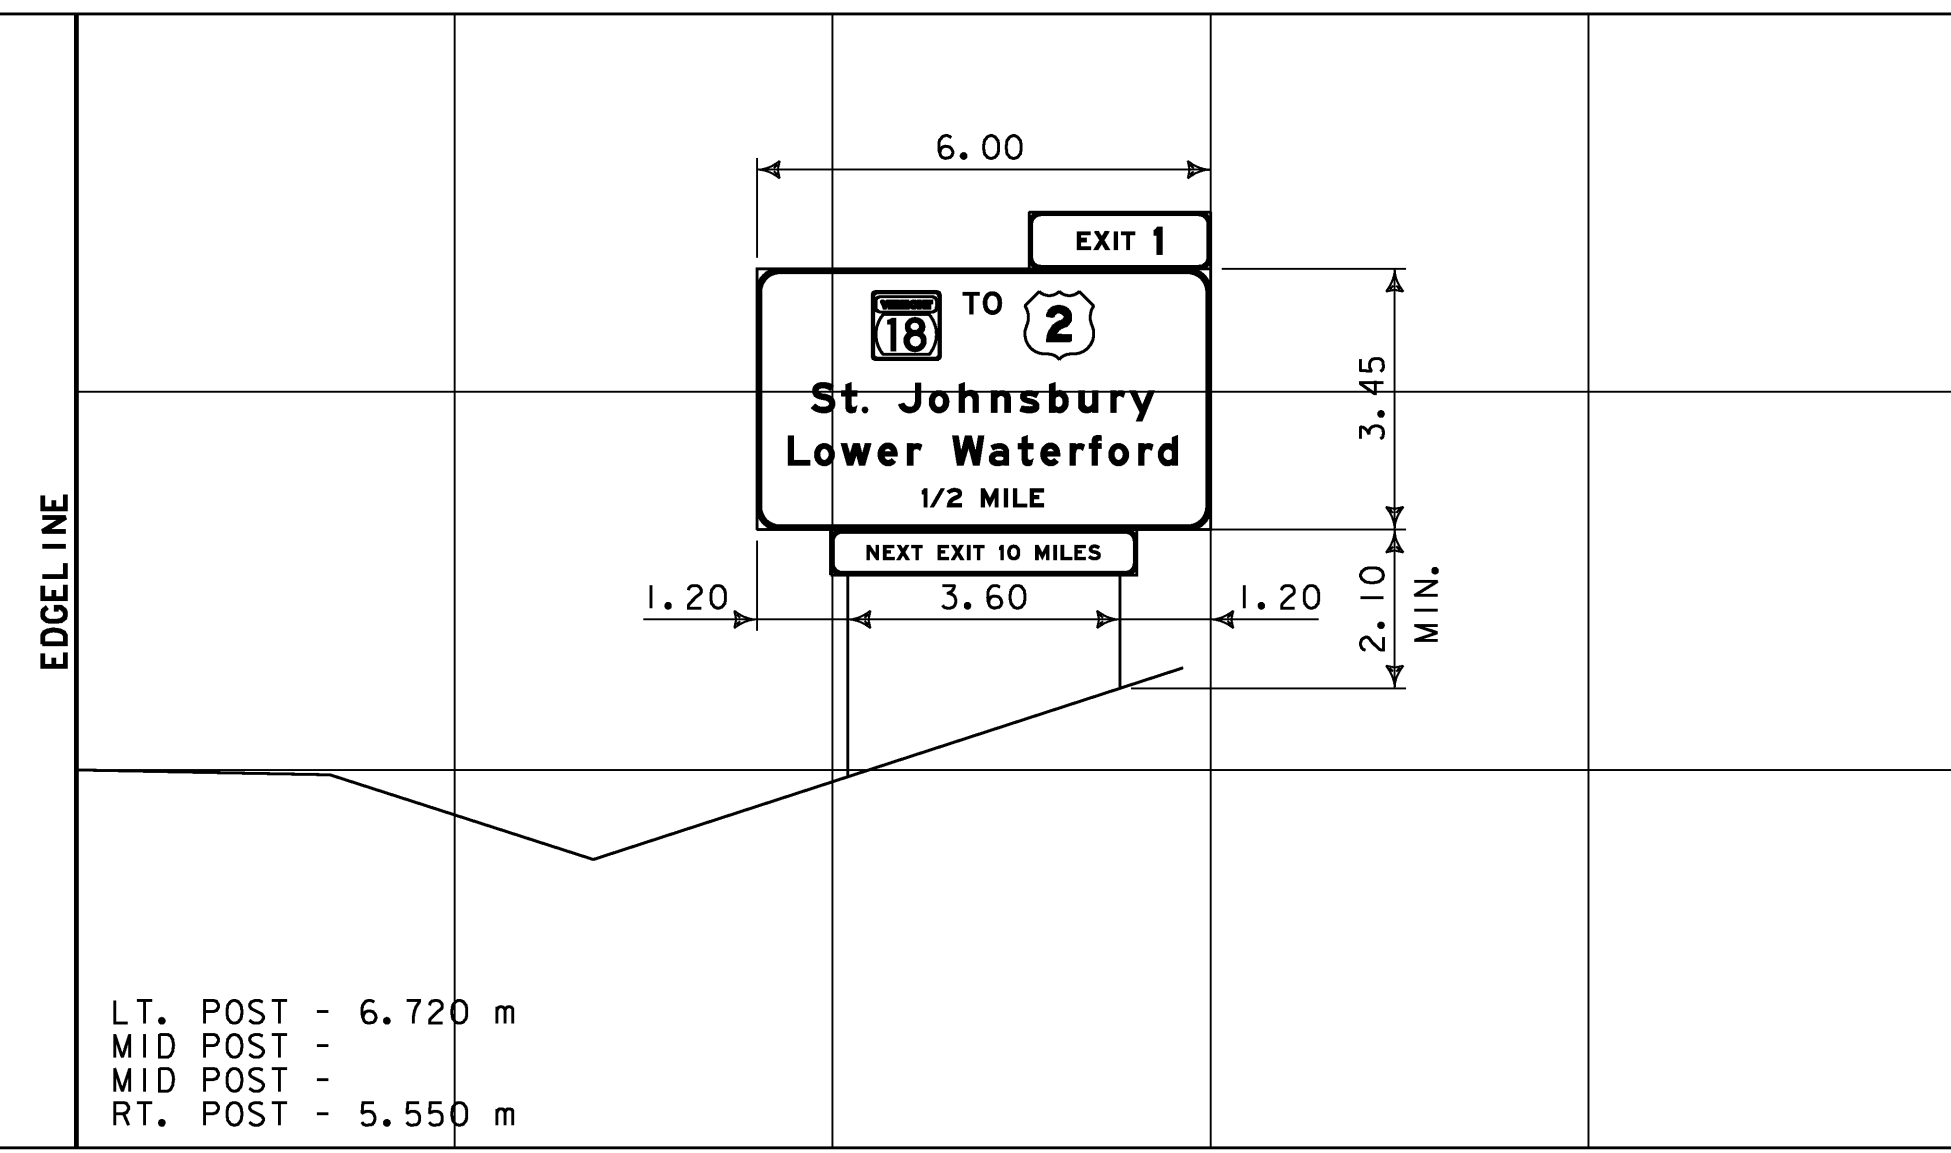


M.M. 8.782 SB

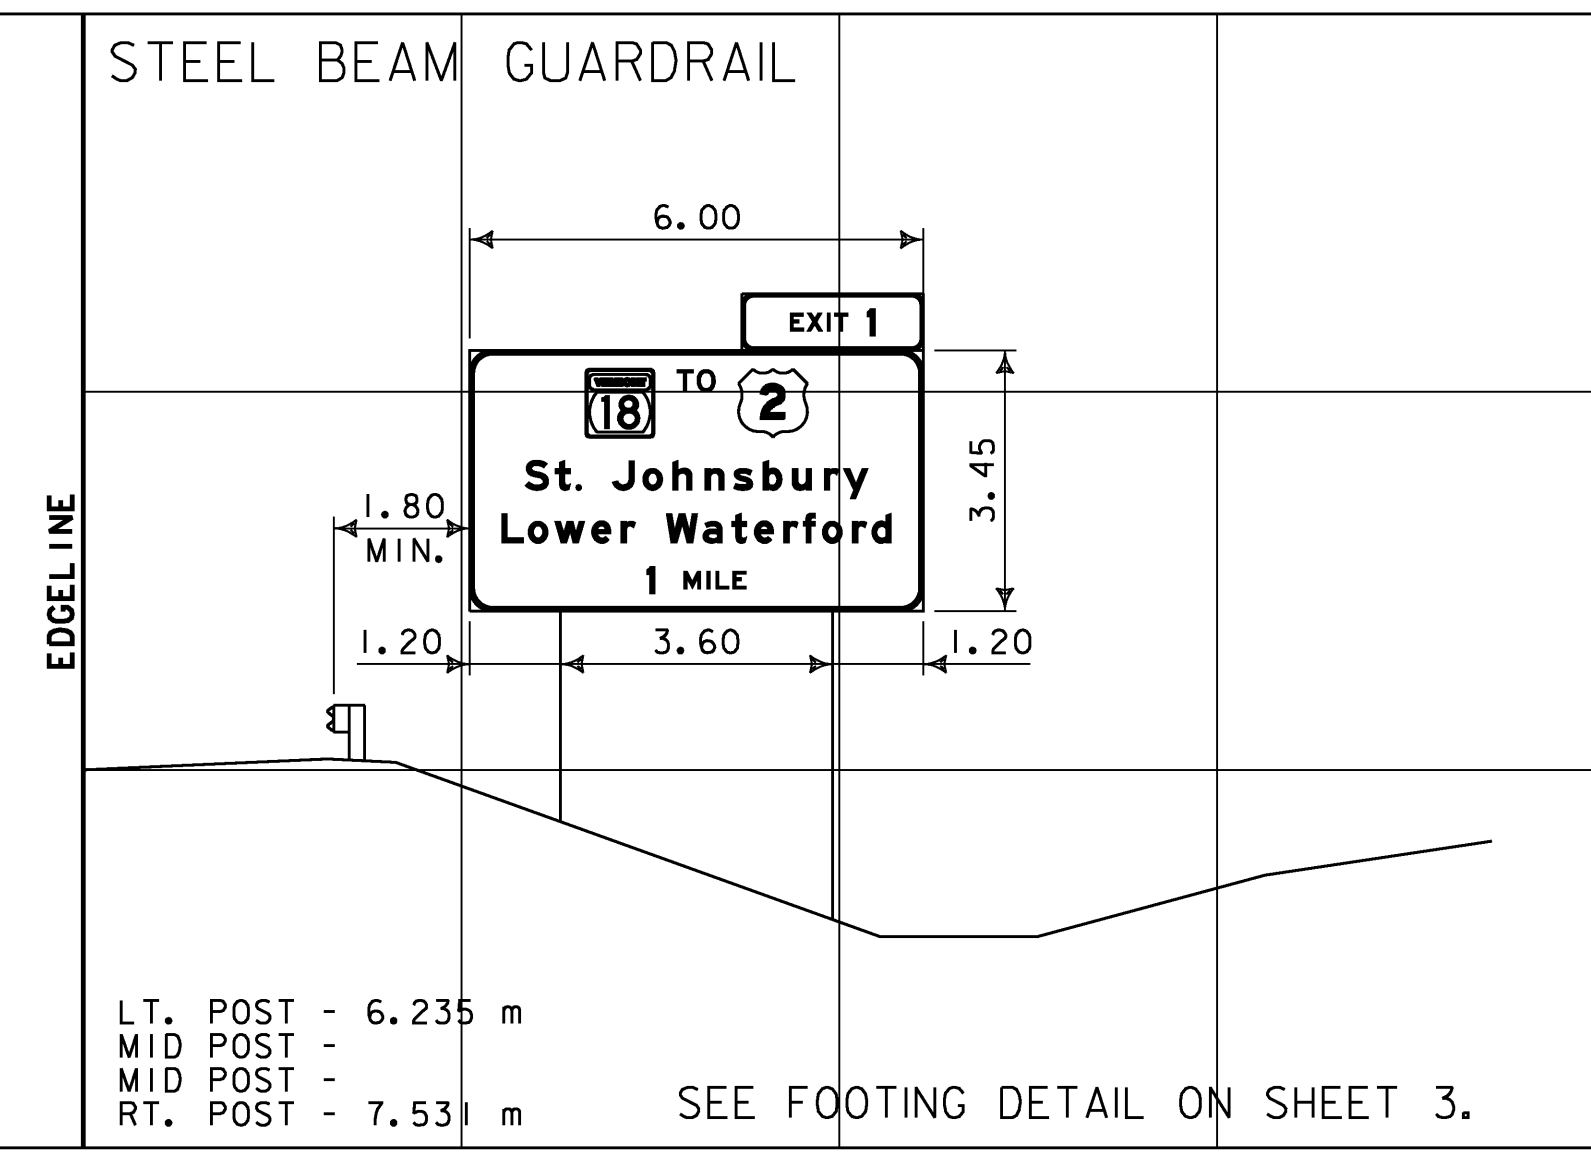


**INTERCHANGE 1
ROUTE 18
M.M. 7.311 RT**

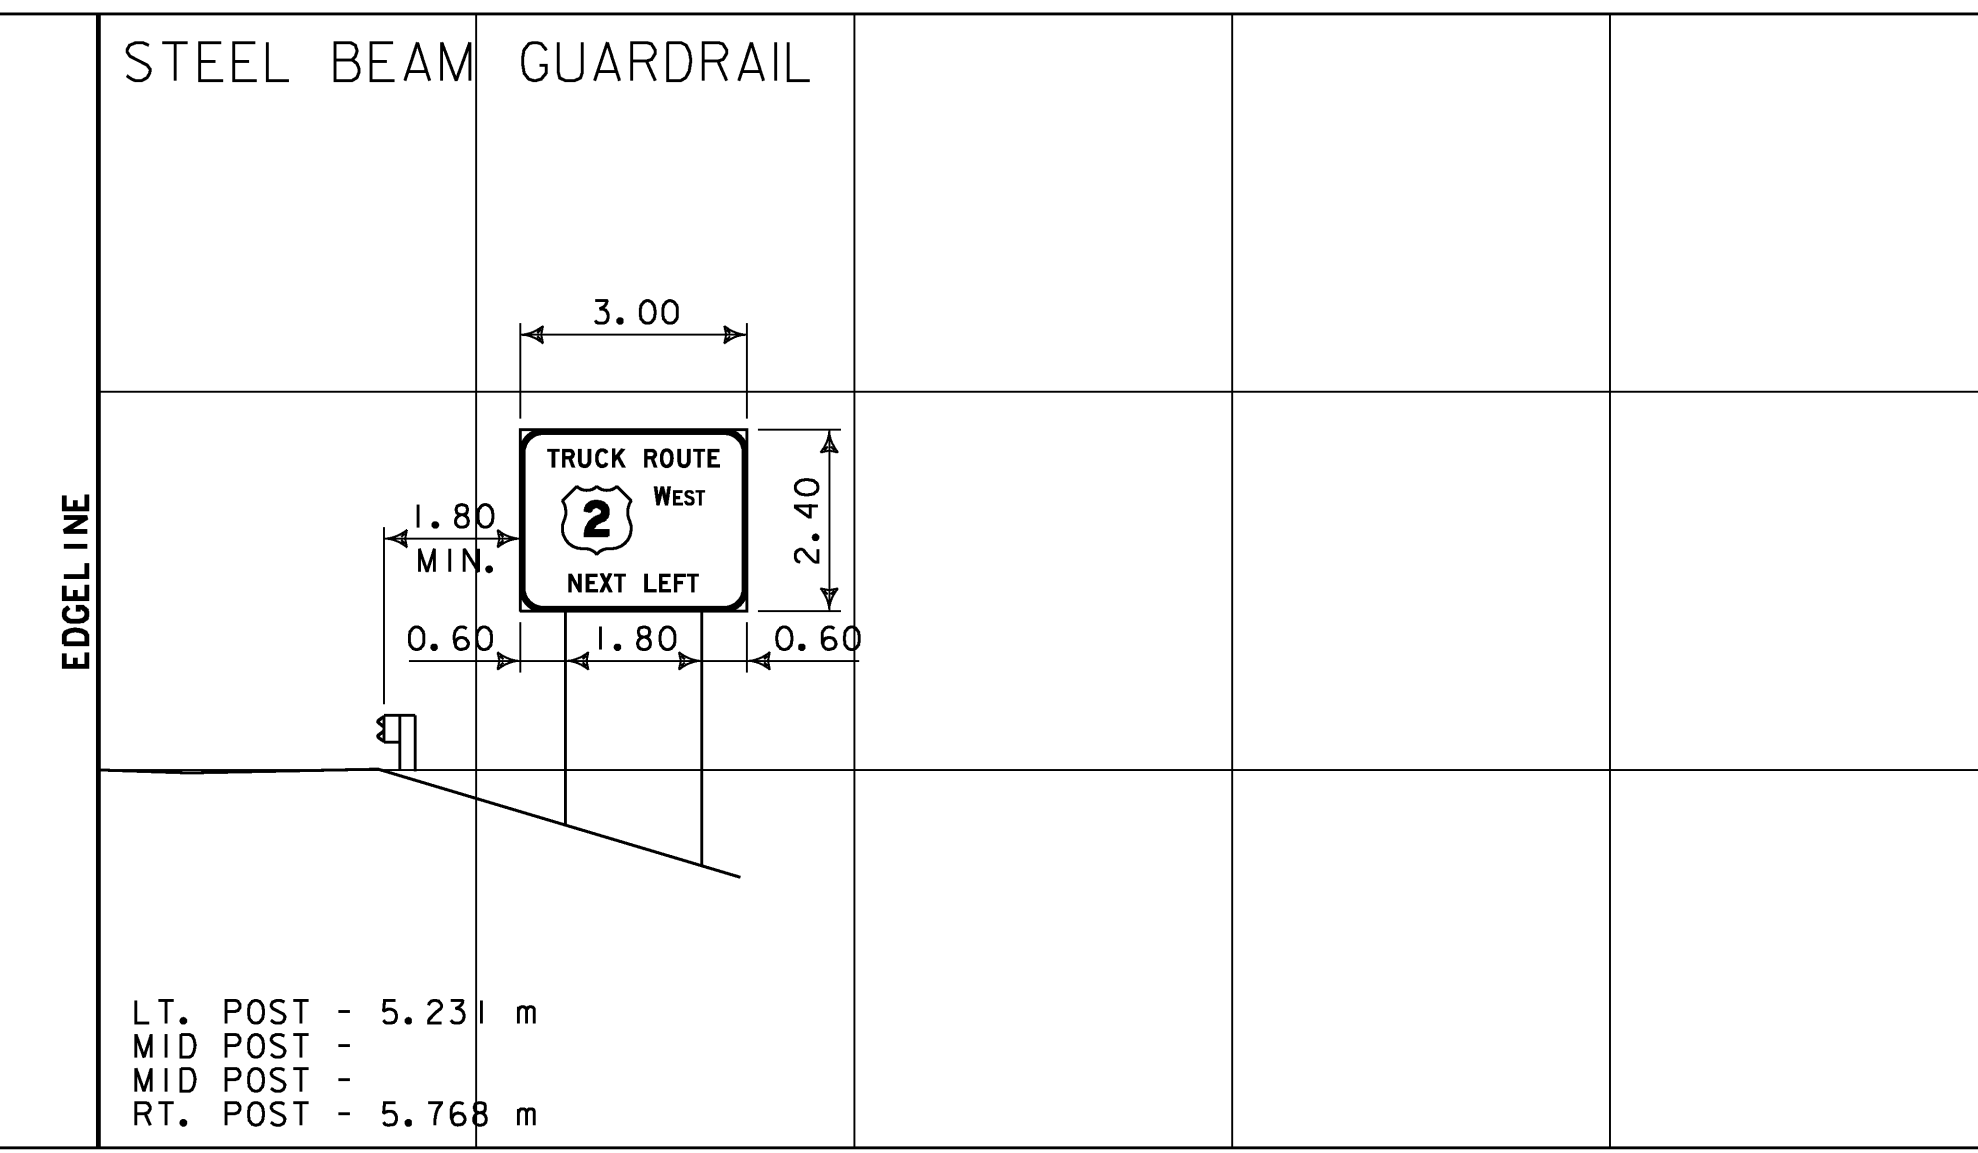


M.M. 8.040 SB

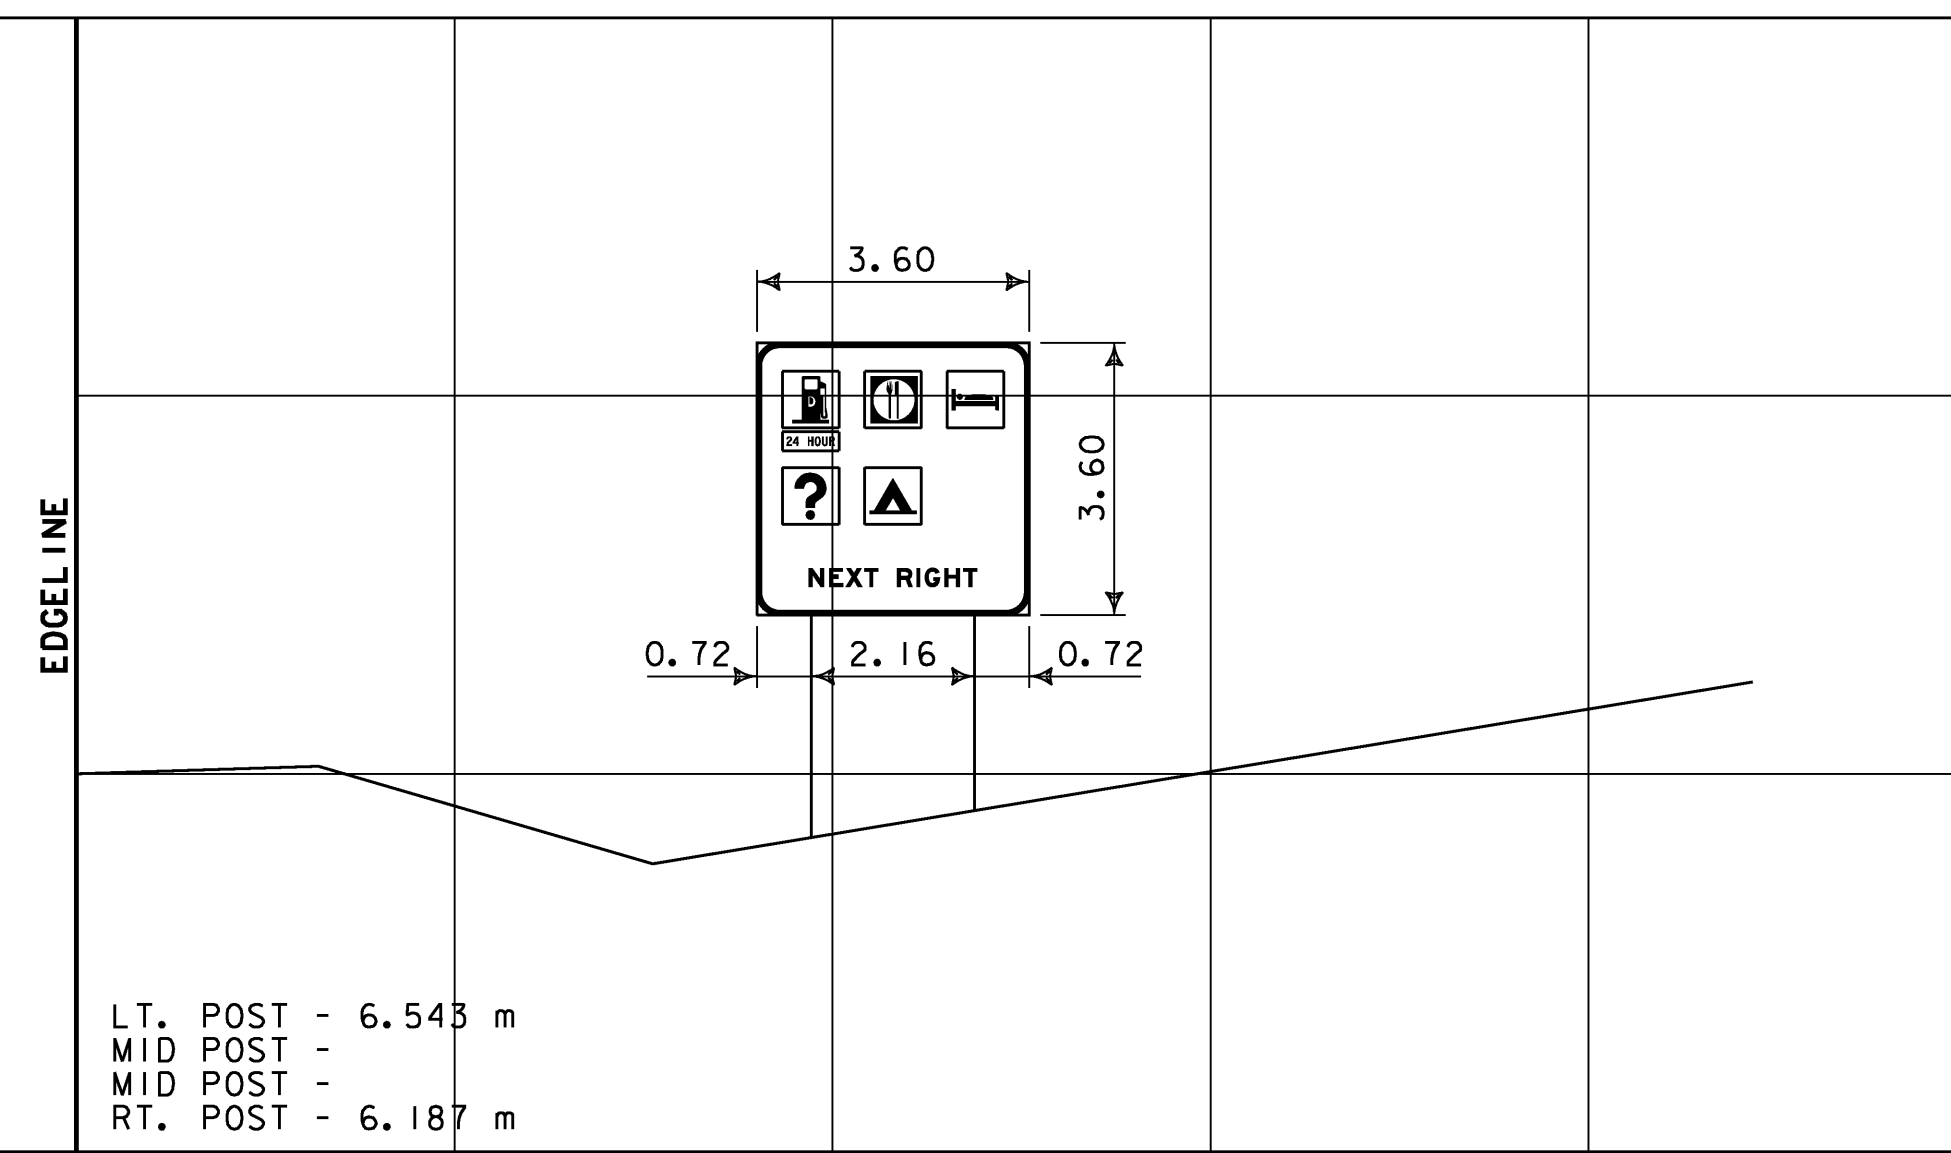


M.M. 8.610 SB

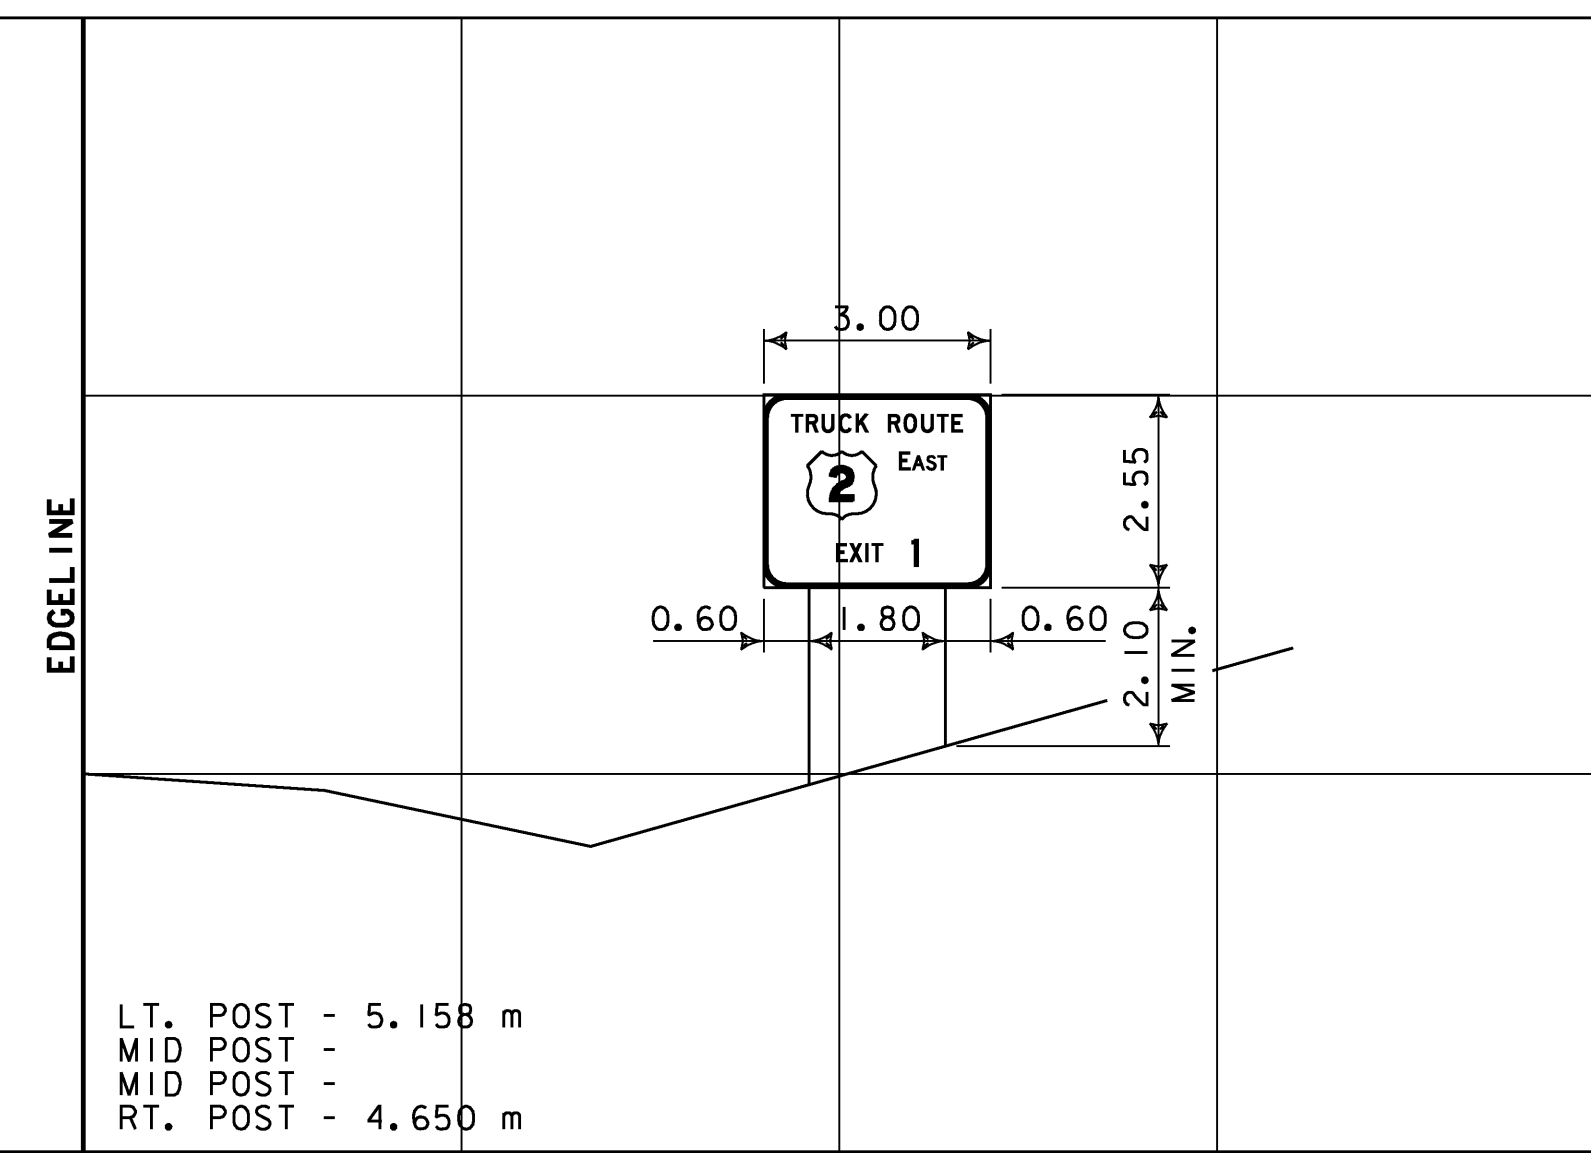



M.M. 10.468 SB

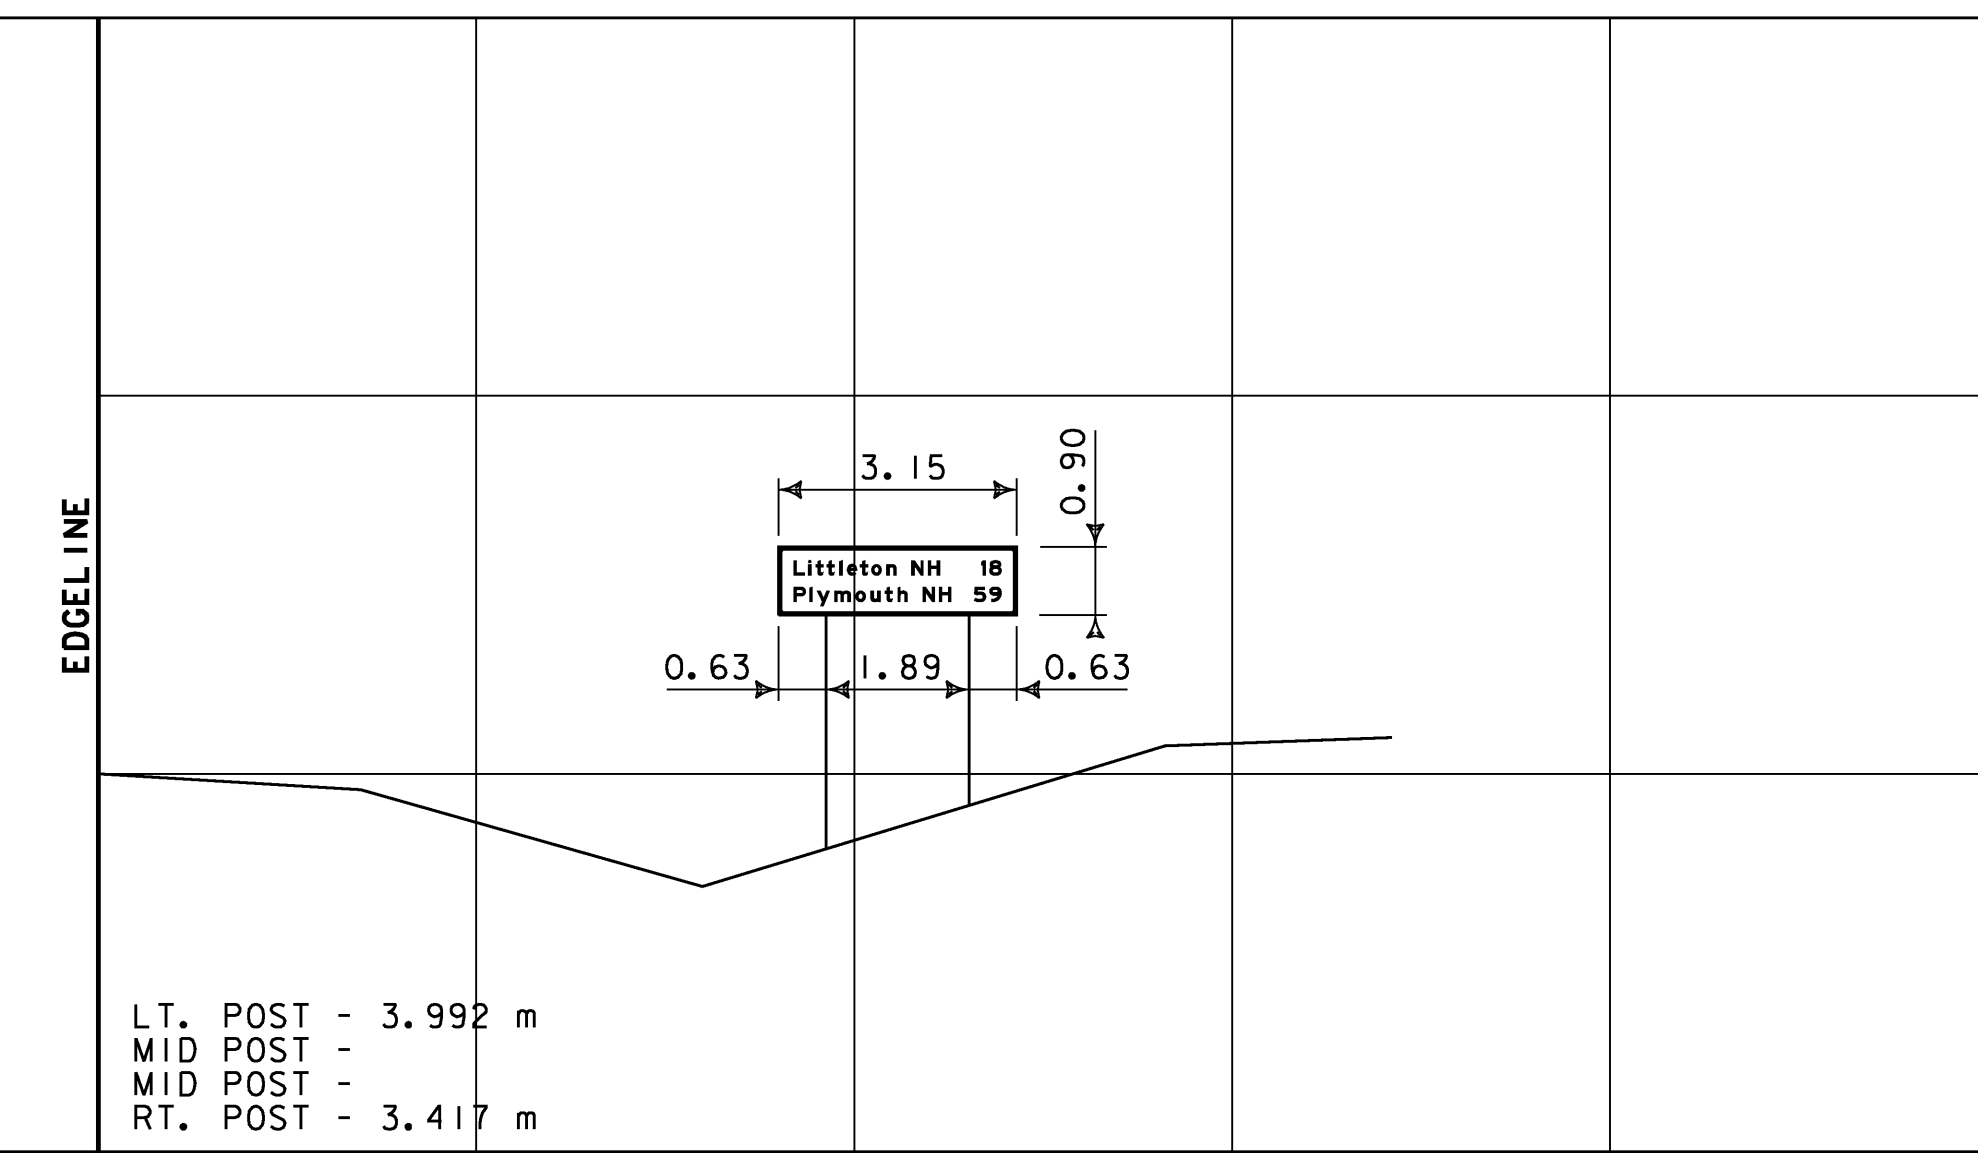

M.M. 7.750 SB

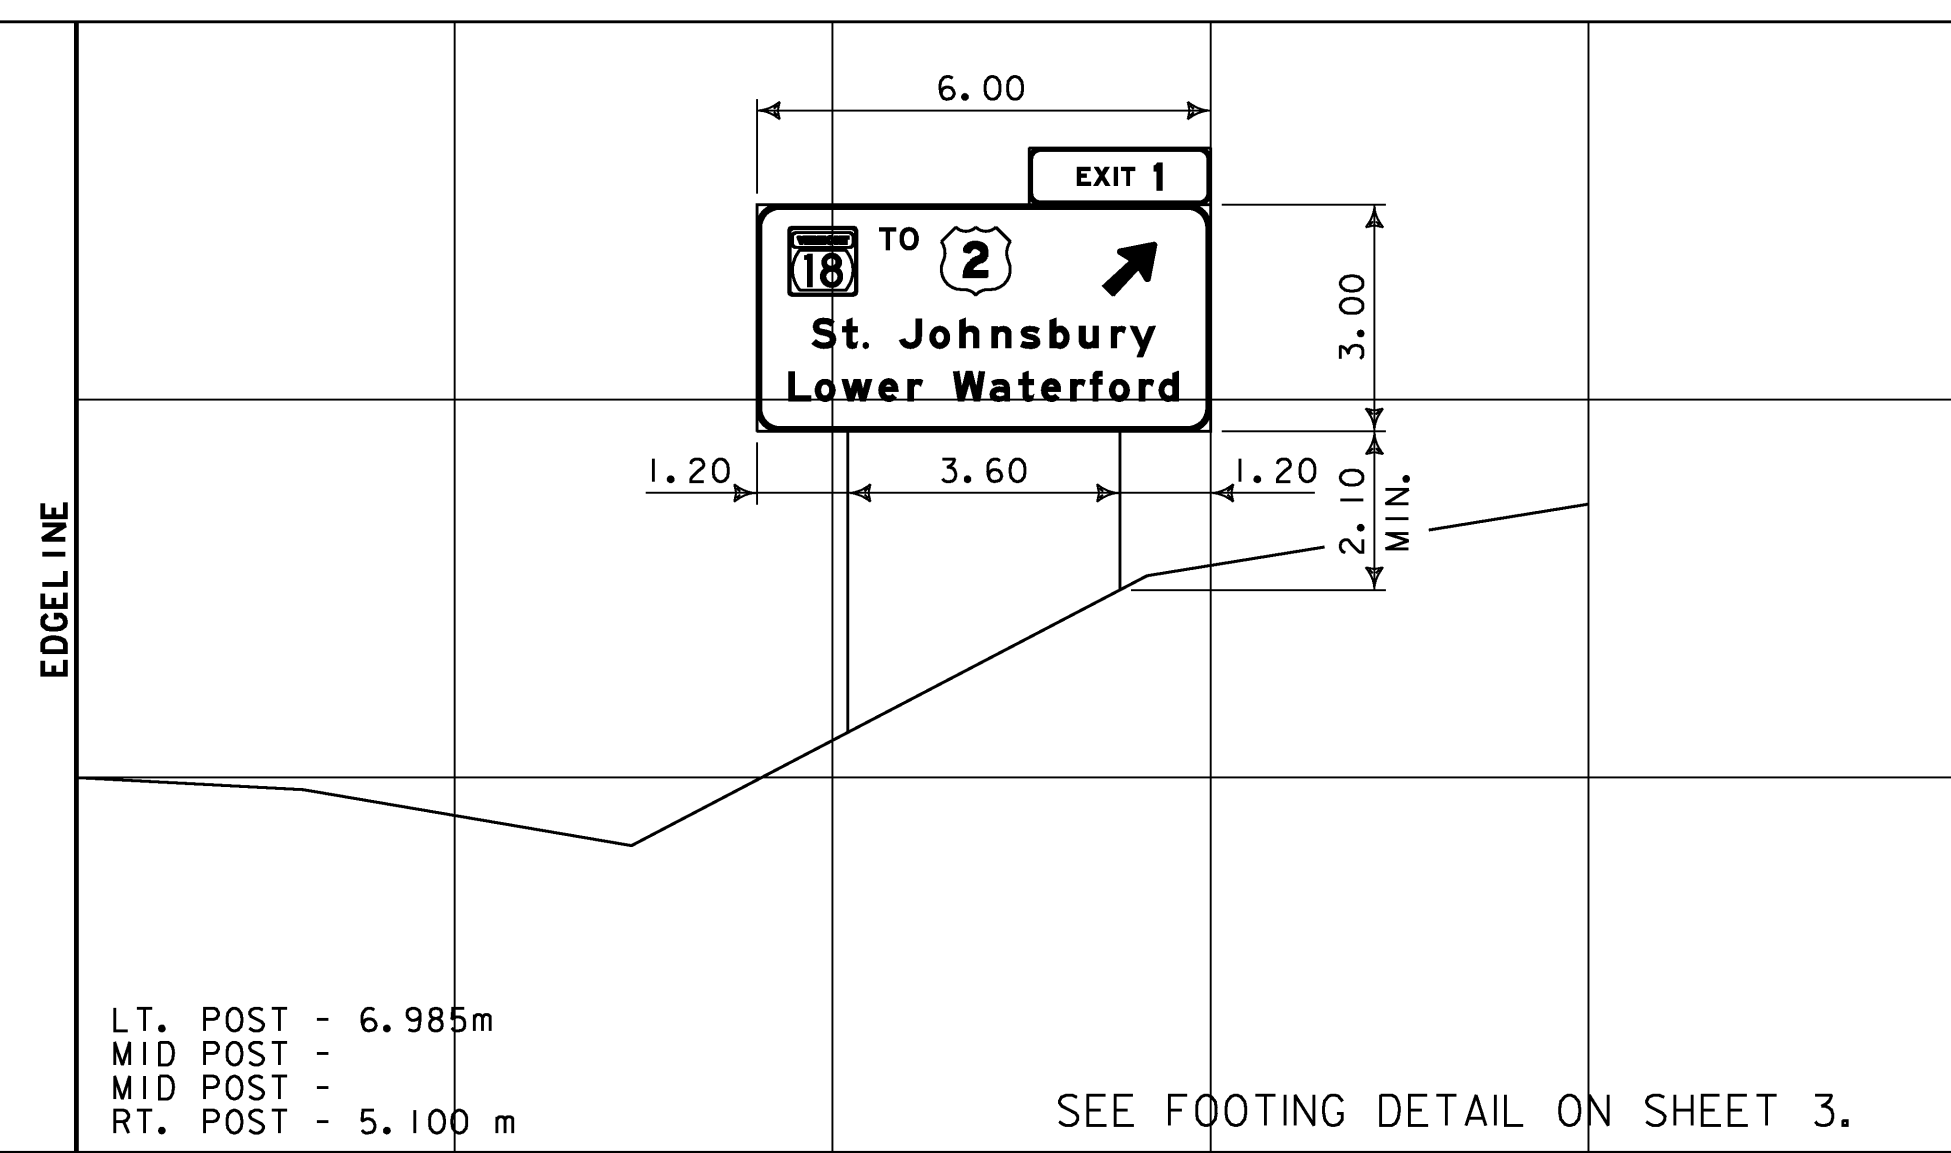

M.M. 8.450 SB

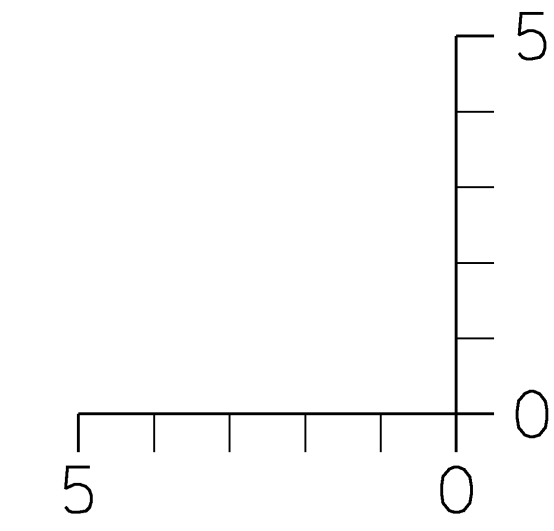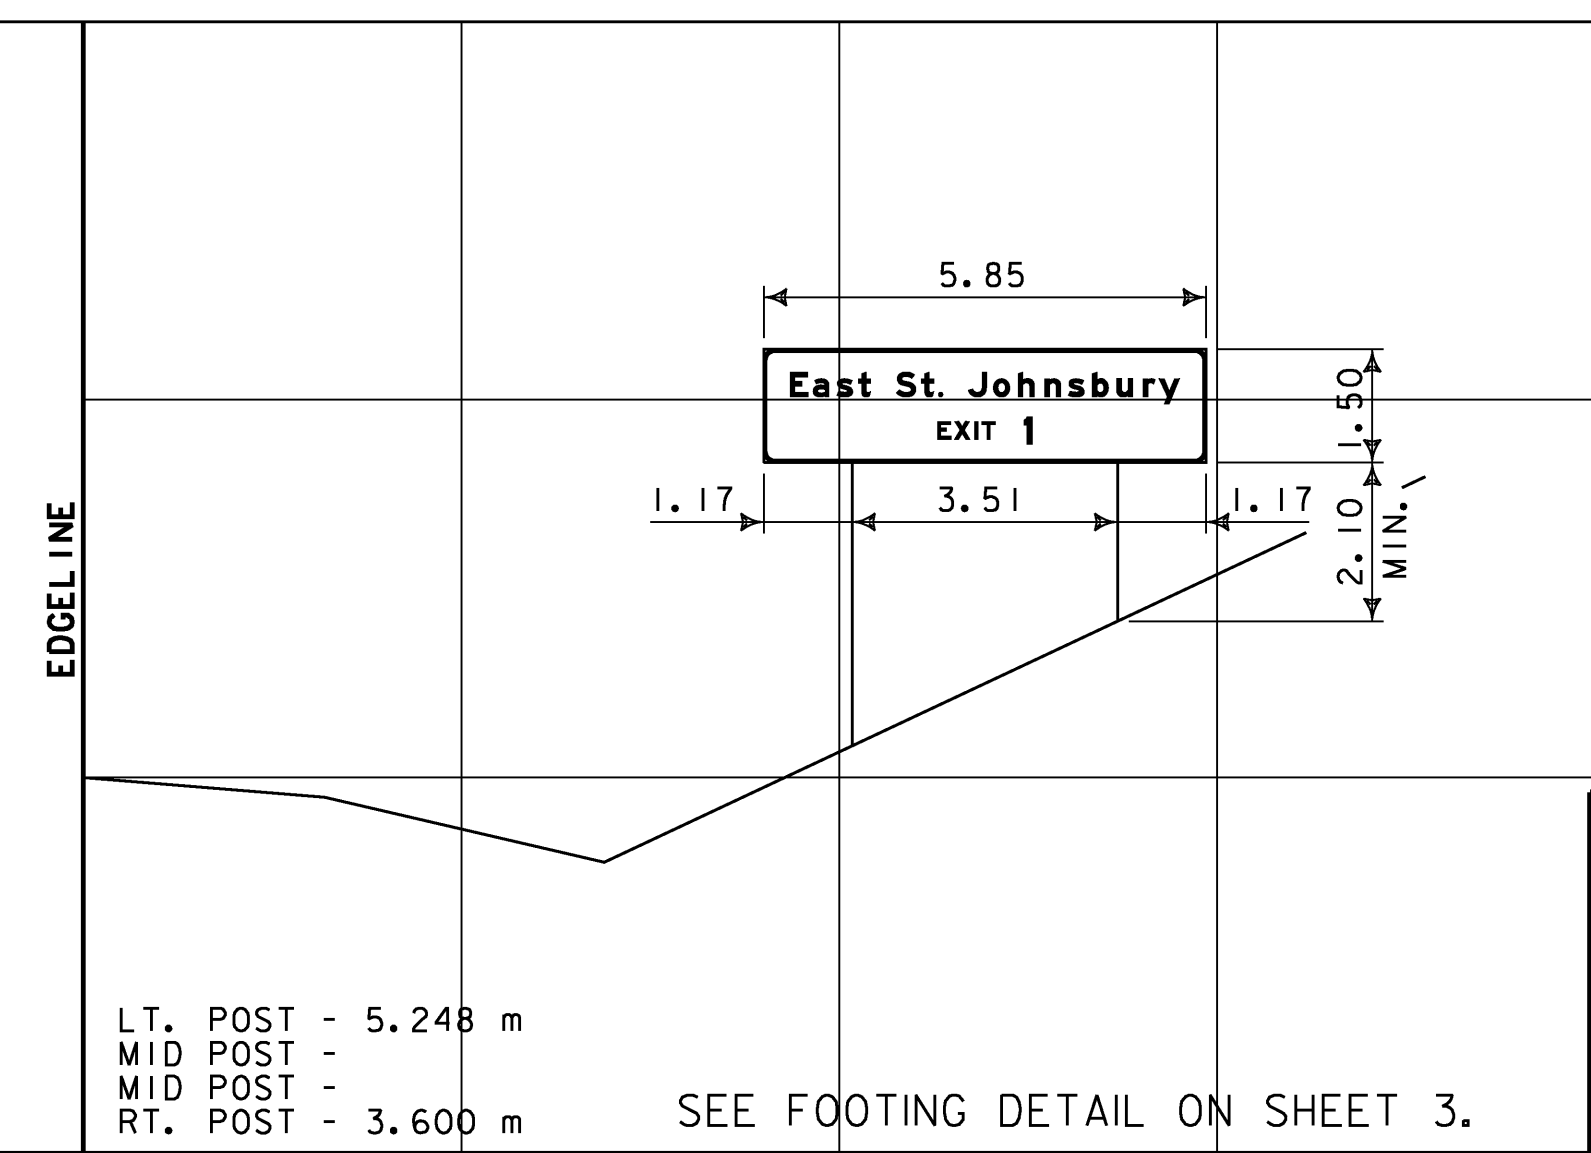

DIMENSIONS FOR CRITICAL OFFSETS OR CLEARANCES SHOWN FOR CONVENIENCE. REFER TO STANDARD SHEETS FOR PLACEMENT GUIDELINES.

**SIGN
CROSS SECTION
SHEET 3**

PROJECT NAME:	WATERFORD	PLOT DATE:	1/4/2007
PROJECT NUMBER:	HES 093-1(10)	DRAWN BY:	HJC
FILE NAME:	9721lb-xs.dgn	CHECKED BY:	DAM
PROJECT LEADER:	CRB	CLD REF. NO.:	97-0211
DESIGNED BY:	DAM	SHEET	124 OF 130