


TRUSS 1

ALL DIMENSIONS SHOWN ARE IN MILLIMETERS (mm) UNLESS OTHERWISE NOTED. ENGLISH CONVERSION SHOWN IN [] FOR REFERENCE ONLY.

RECEIVED
 OK'D BY: *GC* OK'D BY: _____
 JUL 27 2007
 RESUBMIT: _____ APPROVED: X
 BY: _____ DATE: 08/07/07

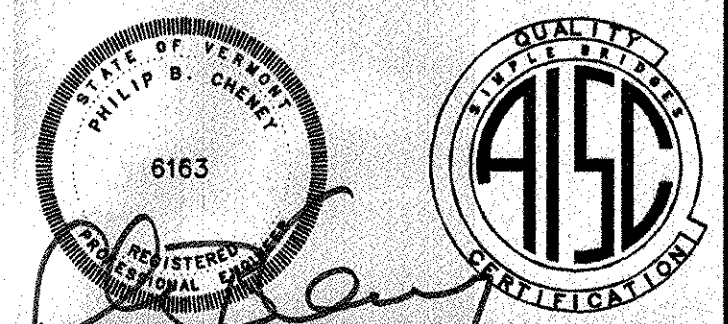

REVISIONS		
No.	Remarks	Date
0	Initial submittal	

HIGHWAY SAFETY CORP.
 GLASTONBURY, CT

TRI-CHORD SIGN STRUCTURE
 STATE OF VERMONT
 COUNTY OF CALEDONIA
 MM 10.470 NB
 PROJECT No. HES 091-3(42)
 HES 093-1(10)

DRAWN: MHM
 CHECKED: P Radice
 DATE: 5/23/07
 SCALE: NTS
 HSC REFERENCE NO.: 1587f
 GENERAL CONTRACTOR: _____
 SUB CONTRACTOR: F.R. LAFAYETTE

SIZE: D REVISION: 0
 SHEET NO.: 2 of 8