


MK-sv7

REVISIONS		
No.	Remarks	Date
0	Initial submittal	

RECEIVED
 CND BY *EW* OK'D BY _____
 JUL 27 2007
 RESUBMIT _____ APPROVED *AS NOTED*
 BY _____ DATE *04/07/07*

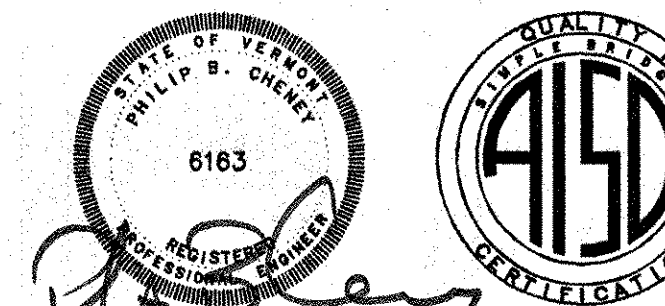

HIGHWAY SAFETY CORP.
 GLASTONBURY, CT

TRI-CHORD SIGN STRUCTURE
 STATE OF VERMONT
 COUNTY OF CALEDONIA
 MM 10.470 NB
 PROJECT No. HES 091-3(42)
 HES 093-1(10)

DRAWN: MHM
 CHECKED: *P Radice*
 DATE: 5/23/07
 SCALE: NTS
 HSC REFERENCE NO.: 1587f
 GENERAL CONTRACTOR: _____
 SUB CONTRACTOR: F.R. LAFAYETTE

SHEET NO. 6 of 8