


RECEIVED
 OK'D BY *gvc* OK'D BY _____
 JUL 27 2007
 RESUBMIT _____ APPROVED *X*
 BY _____ DATE *08/08/07*

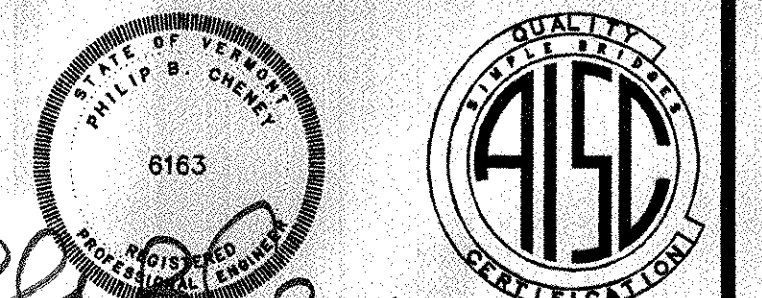

ALL DIMENSIONS SHOWN ARE IN MILLIMETERS (mm) UNLESS OTHERWISE NOTED. ENGLISH CONVERSION SHOWN IN [] FOR REFERENCE ONLY.

TRUSS 1

REVISIONS		
No.	Remarks	Date
0	Initial submittal	

HIGHWAY SAFETY CORP.
 GLASTONBURY, CT

TRI-CHORD SIGN STRUCTURE
 STATE OF VERMONT
 COUNTY OF CALEDONIA
 MM 10.970 NB
 PROJECT No. HES 091-3(42)
 HES 093-1(10)

DRAWN: MHM
 CHECKED: *P. Radice*
 DATE: 5/23/07
 SCALE: NTS
 HSC REFERENCE NO.: 1587g
 SIZE: D REVISION: 0
 SHEET NO.: 2 of 8

GENERAL CONTRACTOR: _____
 SUB CONTRACTOR: F.R. LAFAYETTE