


MK-vp

MK-ubb

MK-su1


MK-stp2

MK-be2

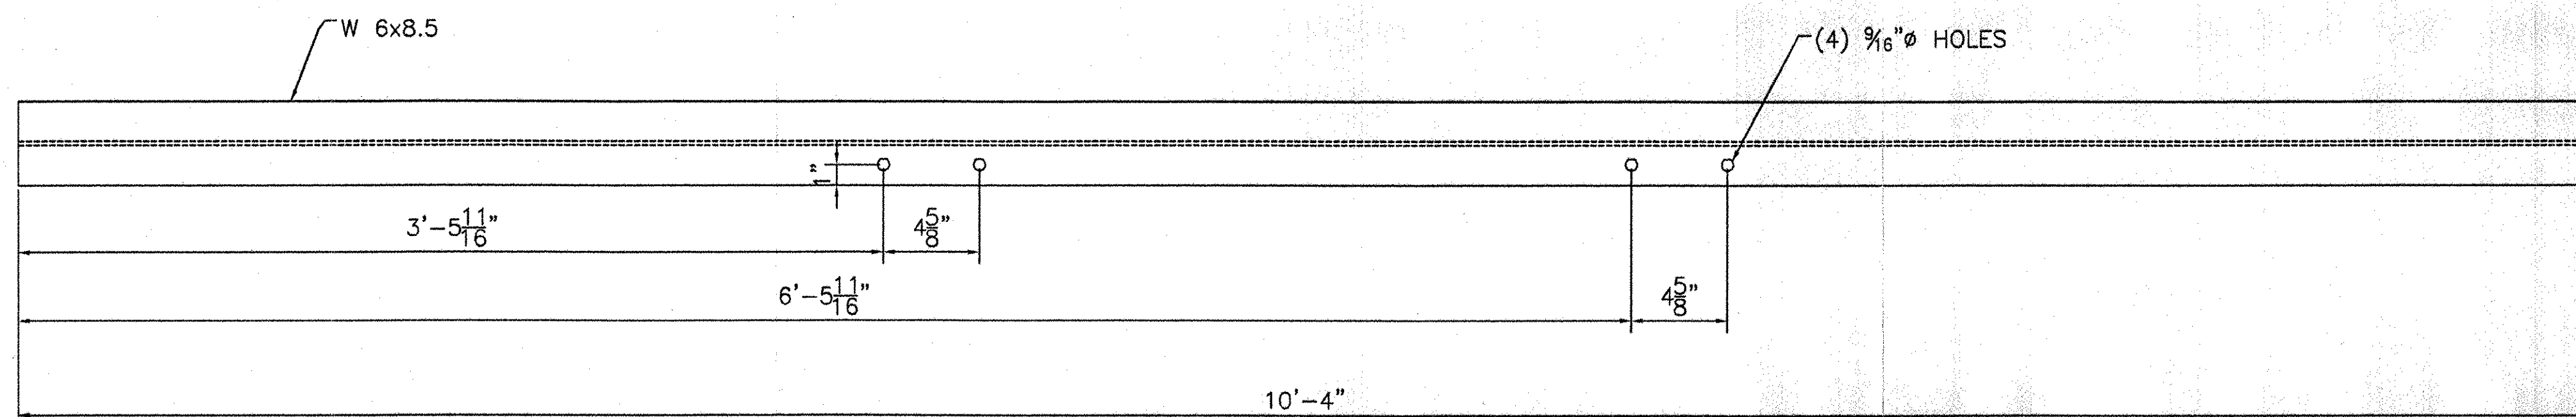

MK-sv8

RECEIVED
 CK'D BY *guc* CK'D BY _____
 JUL 27 2007
 RESUBMIT _____ APPROVED *AS NOTED*
 BY _____ DATE 08/08/07

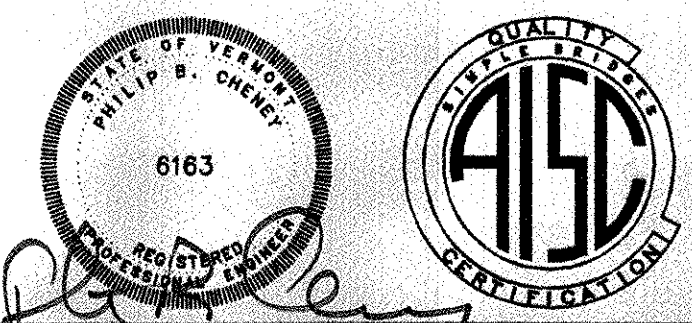

HIGHWAY SAFETY CORP.
 GLASTONBURY, CT

TRI-CHORD SIGN STRUCTURE
 STATE OF VERMONT
 COUNTY OF CALEDONIA
 MM 10.970 NB
 PROJECT No. HES 091-3(42)
 HES 093-1(10)

DRAWN: MHM
 CHECKED: *P. Radice*
 DATE: 5/23/07
 SCALE: NTS
 HSC REFERENCE NO.: 1587g
 SIZE: D REVISION: 0
 SHEET NO.: 6 of 8

REVISIONS		
No.	Remarks	Date
0	Initial submittal	

251-51649