



INTERSTATE 89
 CURVE #1
 PI STA = 227+18.52
 N = 716827.78
 E = 1461373.82
 $\Delta = 13^{\circ}18'53.5''$ RT
 R = 5729.58
 T = 668.75'
 L = 1331.48'
 E = 38.90'

STA 207+00.00
 BEGIN APPROACH
 MATCH EXISTING PAVEMENT
 MARKINGS

NOTES:
 1. SEE MISCELLANEOUS DETAIL SHEET 4
 FOR PAVEMENT TRANSITION DETAILS.

DATUM
 VERTICAL: NAVD 88
 HORIZONTAL: NAD83 (96)

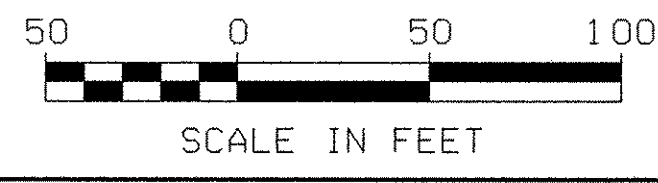

 M^o FARLAND- JOHNSON, INC	PROJECT NAME: SOUTH BURLINGTON	PLOT DATE: 21-SEP-2007
	PROJECT NUMBER: AC IM CULV (9)	DRAWN BY: MAL
FILE NAME: p001.dgn	DESIGNED BY: MRP	CHECKED BY: DMB
PROJECT LEADER: LANDRY	LAYOUT AND STRIPING SHEET	SHEET 11 OF 63