


I-89 NORTHBOUND

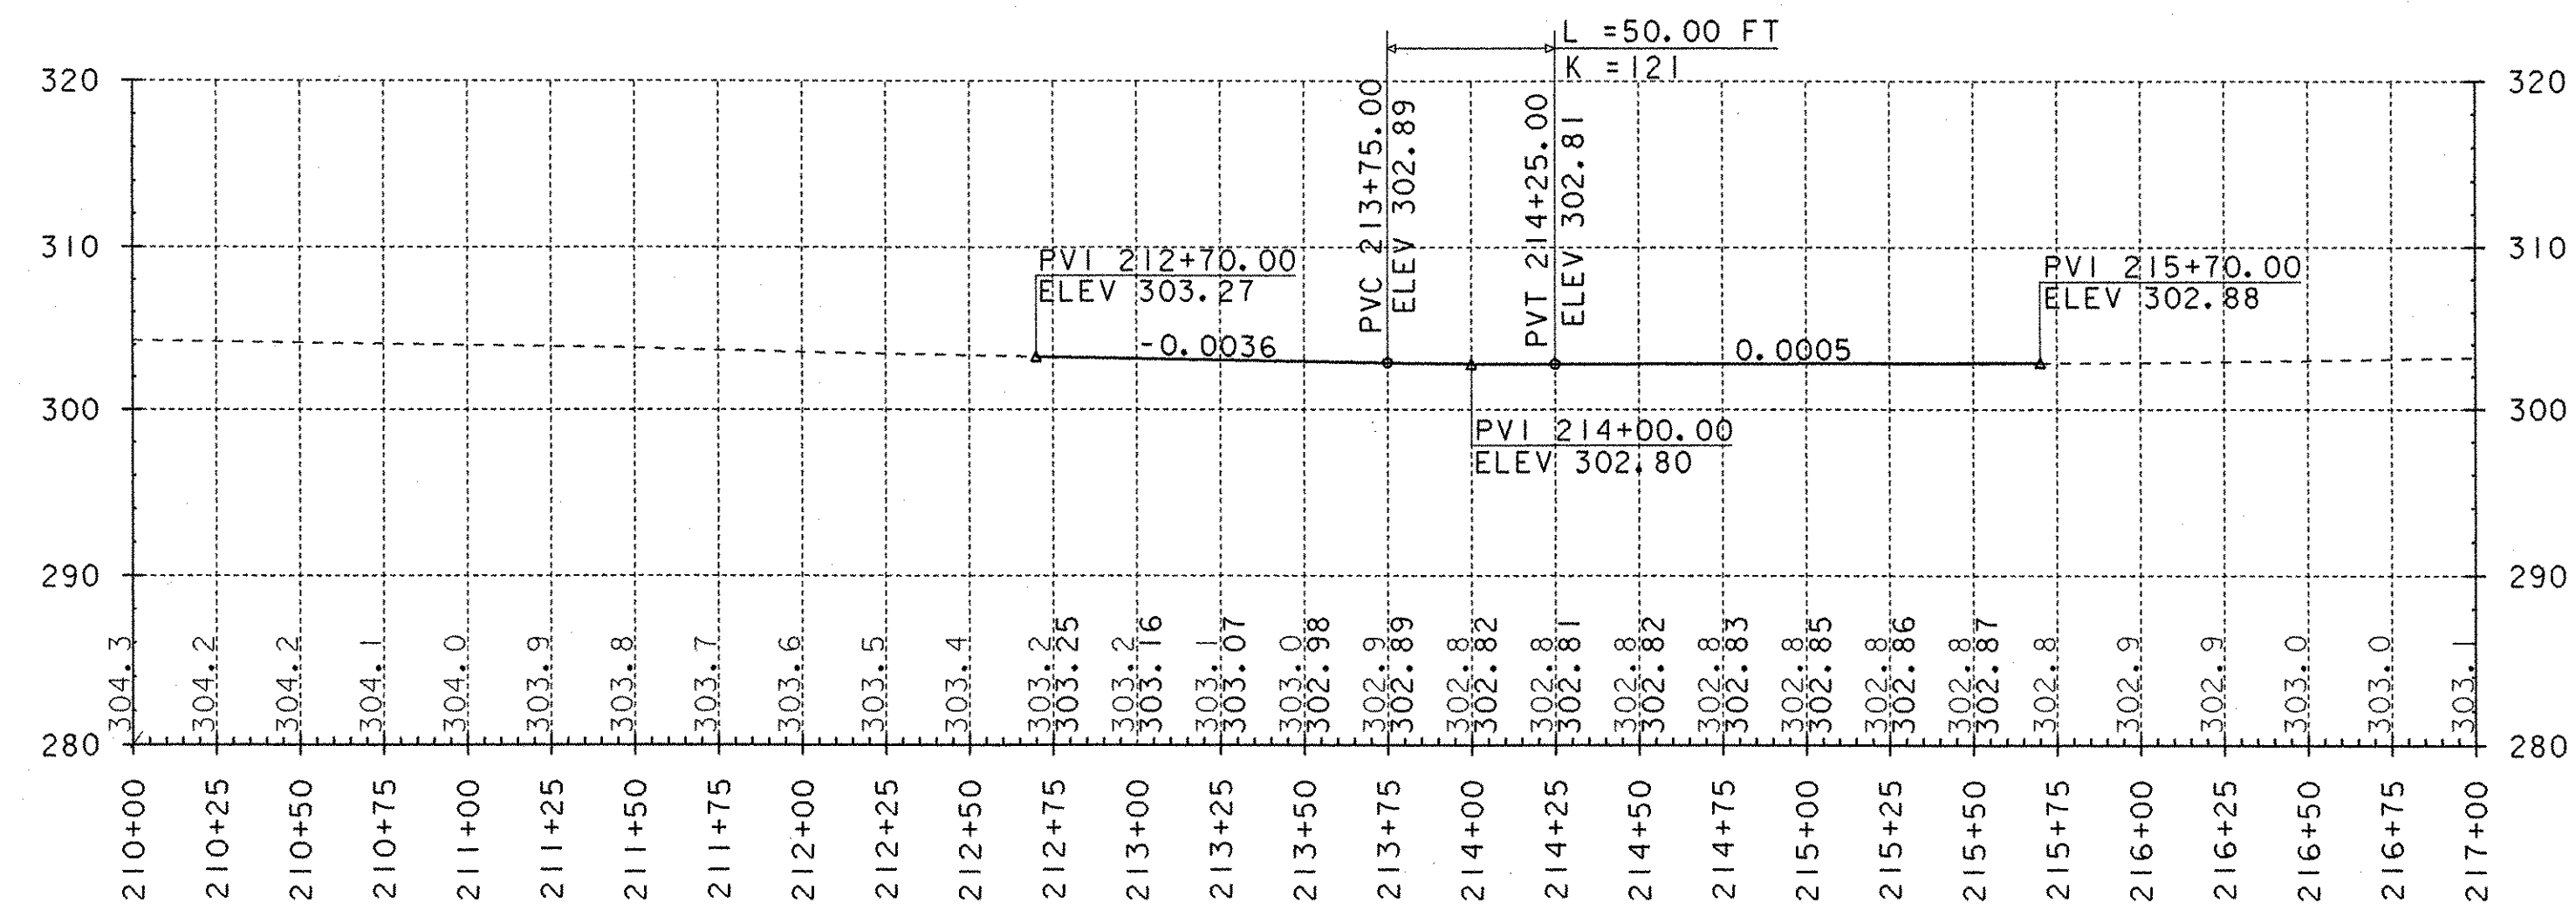


I-89 SOUTHBOUND

NOTE :

ELEVATIONS BASED UPON FIELD SURVEY BY VTRANS ON 9/2006  
 DATUM = NAVD 88.

DATUM  
 VERTICAL: NAVD 88  
 HORIZONTAL: NAD83 (96)

SCALE:  
 1" = 50' HORIZ.  
 1" = 10' VERT.

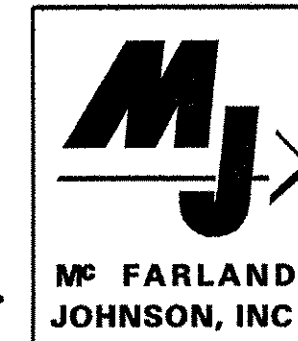

PROJECT NAME: SOUTH BURLINGTON  
 PROJECT NUMBER: AC IM CULV (9)

FILE NAME: prof01.dgn  
 PROJECT LEADER: LANDRY  
 DESIGNED BY: MRP  
 I-89 NORTHBOUND / SOUTHBOUND PROFILE

PLOT DATE: 21-SEP-2007  
 DRAWN BY: MAL  
 CHECKED BY: DMB  
 SHEET 13 OF 63