
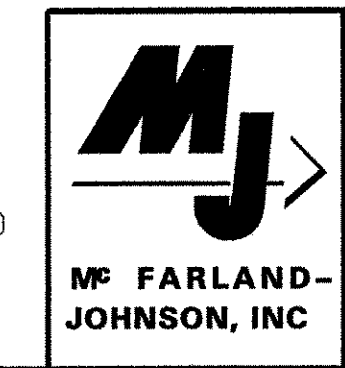


DATUM
 VERTICAL: NAVD 88
 HORIZONTAL: NAD83 (96)

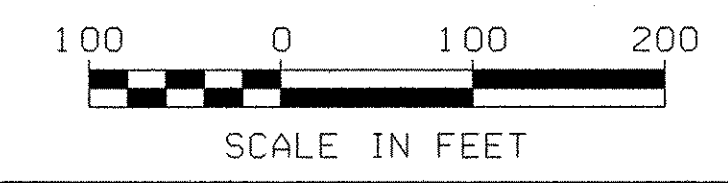

PHASE I

PROJECT NAME:	SOUTH BURLINGTON	PLOT DATE:	21-SEP-2007
PROJECT NUMBER:	AC IM CULV (9)	DRAWN BY:	MAL
FILE NAME:	ts01.dgn	CHECKED BY:	DMB
PROJECT LEADER:	LANDRY		
DESIGNED BY:	MRP		
TRAFFIC CONTROL PLAN - PHASE I		SHEET	33 OF 63