



\* SIGNS TO REMAIN FOR PHASES I, II, III

**LEGEND**

- - TRAFFIC FLOW
- ☒ - TYPE III BARRIERS
- ▬▬▬ - CONCRETE MEDIAN BARRIER
- ▨▨▨ - WORK AREA
- - REFLECTORIZED PLASTIC DRUM
- ▬▬▬ - ATTENUATOR

PHASE II

DATUM  
 VERTICAL: NAVD 88  
 HORIZONTAL: NAD83 (96)

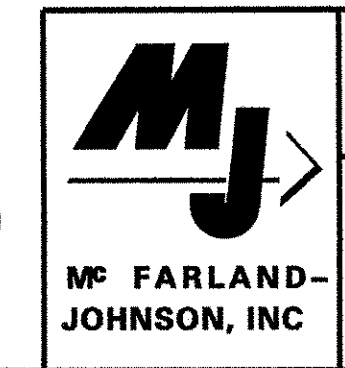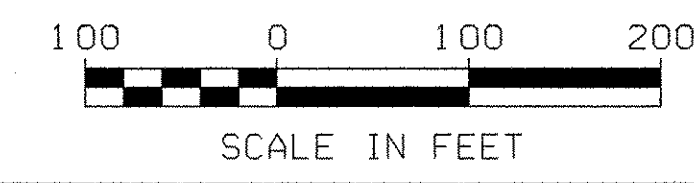

PROJECT NAME: SOUTH BURLINGTON  
 PROJECT NUMBER: AC IM CULV (9)  
 FILE NAME: tsl0.dgn  
 PROJECT LEADER: LANDRY  
 DESIGNED BY: MRP  
 TRAFFIC CONTROL PLAN - PHASE II  
 PLOT DATE: 21-SEP-2007  
 DRAWN BY: MAL  
 CHECKED BY: DMB  
 SHEET 42 OF 63