


\* SIGNS TO REMAIN FOR PHASES I, II, III

**LEGEND**

- TRAFFIC FLOW
- TYPE III BARRIERS
- CONCRETE MEDIAN BARRIER
- WORK AREA
- REFLECTORIZED PLASTIC DRUM
- ATTENUATOR

PHASE III

DATUM  
 VERTICAL: NAVD 88  
 HORIZONTAL: NAD83 (96)

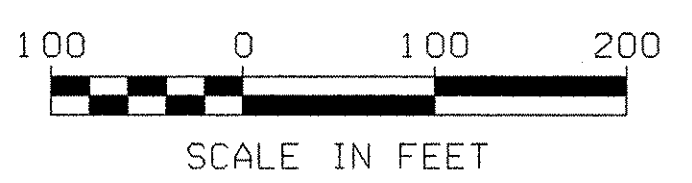

<p><b>Mc FARLAND- JOHNSON, INC</b></p>	PROJECT NAME: SOUTH BURLINGTON	PLOT DATE: 21-SEP-2007
	PROJECT NUMBER: AC IM CULV (9)	DRAWN BY: MAL
	FILE NAME: tsl.dgn	CHECKED BY: DMB
	PROJECT LEADER: LANDRY DESIGNED BY: MRP TRAFFIC CONTROL PLAN - PHASE III	SHEET 43 OF 63