



* SIGNS TO REMAIN FOR PHASES I, II, III

LEGEND

- TRAFFIC FLOW
- TYPE III BARRIERS
- CONCRETE MEDIAN BARRIER
- WORK AREA
- REFLECTORIZED PLASTIC DRUM
- ATTENUATOR

PHASE III

DATUM
 VERTICAL: NAVD 88
 HORIZONTAL: NAD83 (96)

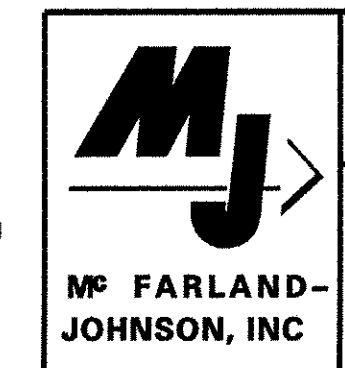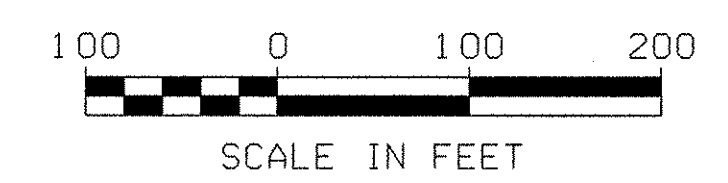

PROJECT NAME: SOUTH BURLINGTON
 PROJECT NUMBER: AC IM CULV (9)
 FILE NAME: +sl5.dgn
 PROJECT LEADER: LANDRY
 DESIGNED BY: MRP
 TRAFFIC CONTROL PLAN - PHASE III
 PLOT DATE: 21-SEP-2007
 DRAWN BY: MAL
 CHECKED BY: DMB
 SHEET 47 OF 63