



215+00

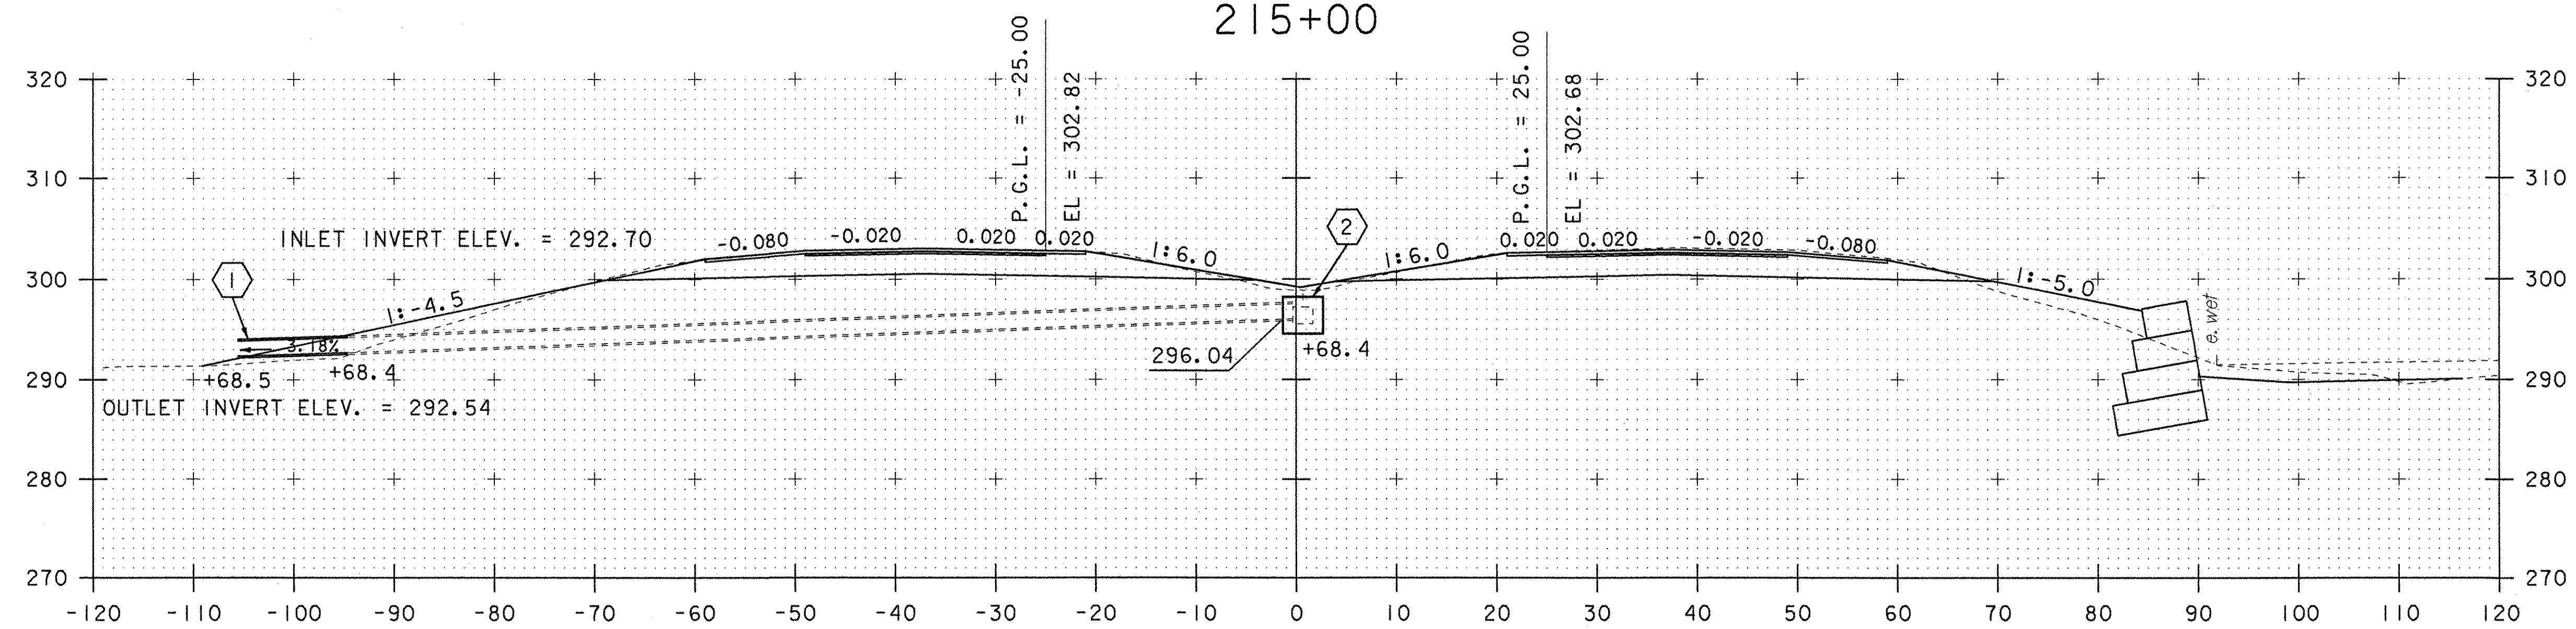

214+50

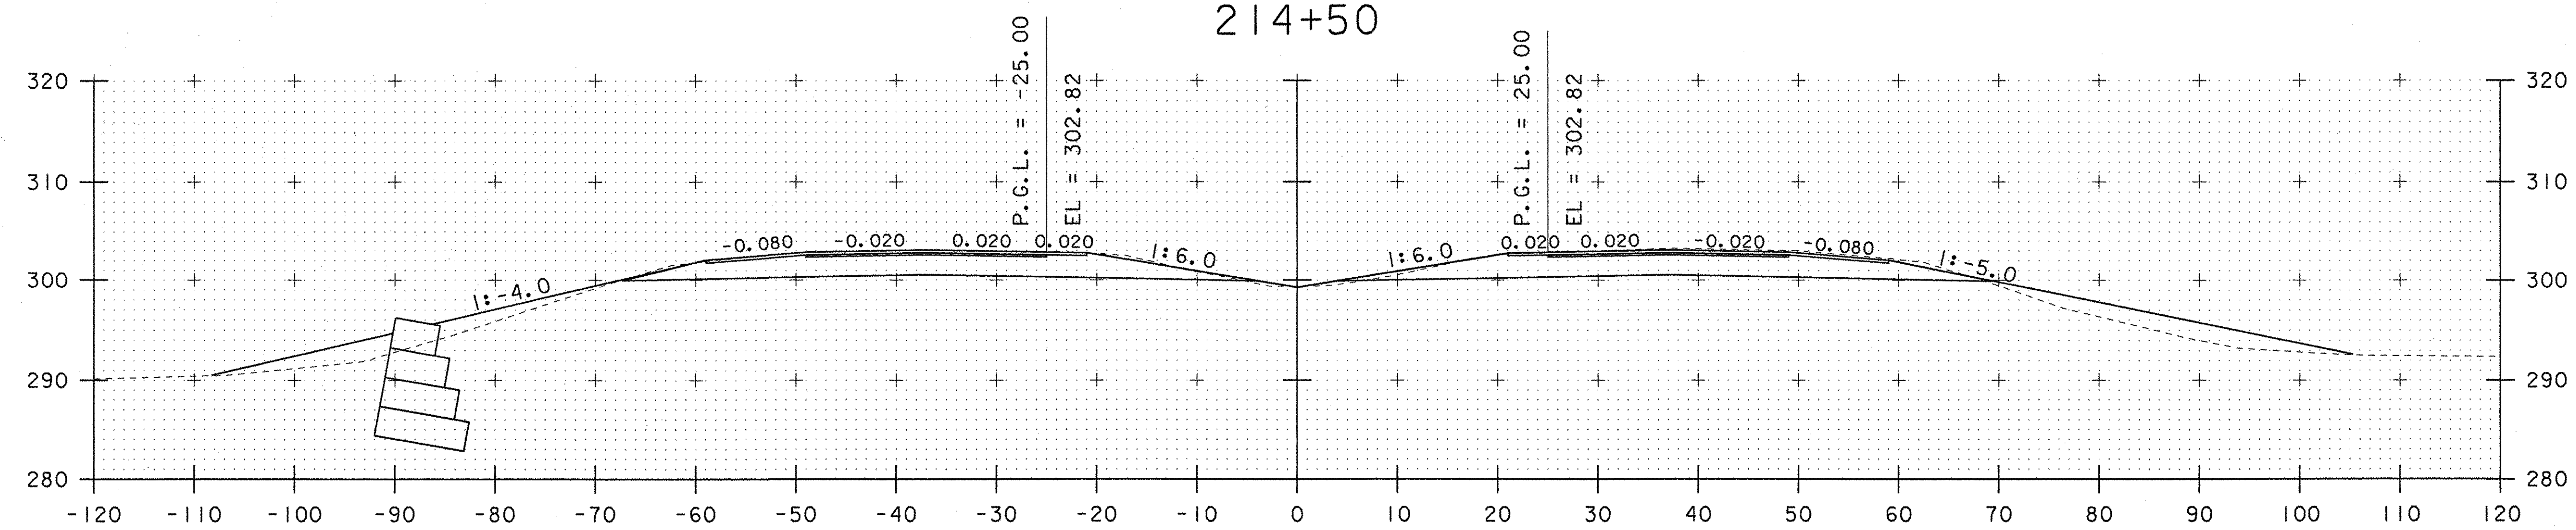

214+00

SHEET NAME: I-89 CROSS SECTIONS			
PROJECT NAME: SOUTH BURLINGTON		PROJECT NUMBER: AC IM CULV(9)	
PROJECT LEADER: LANDRY	DESIGNED BY: MAH	DRAWN BY: MAH	CHECKED BY: DMB
FILE NAME: Z05K286WRK.DGN		PLOT DATE: 21-SEP-2007	
STA 214+00 TO STA 215+00		SHEET 57 OF 63	