



SOUTH BURLINGTON I.M. 89 CURBSET

GABION - NING DETAILS

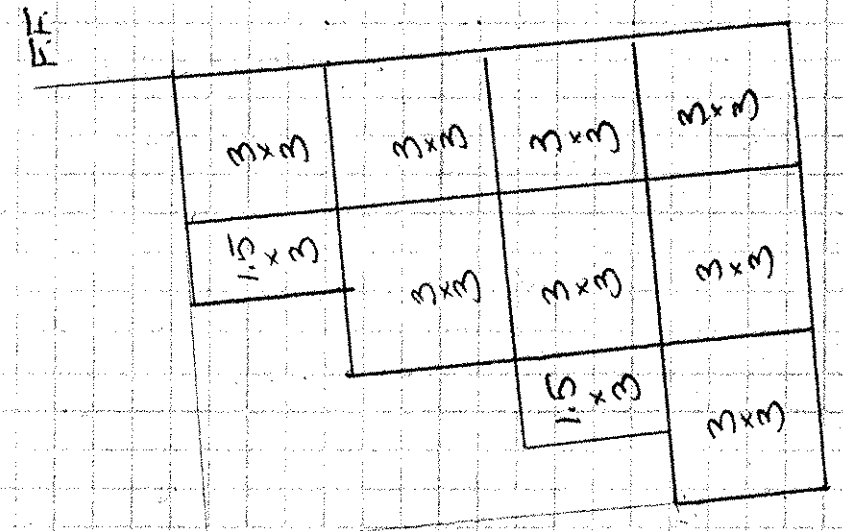

TYP SECTION
1" = 5'0

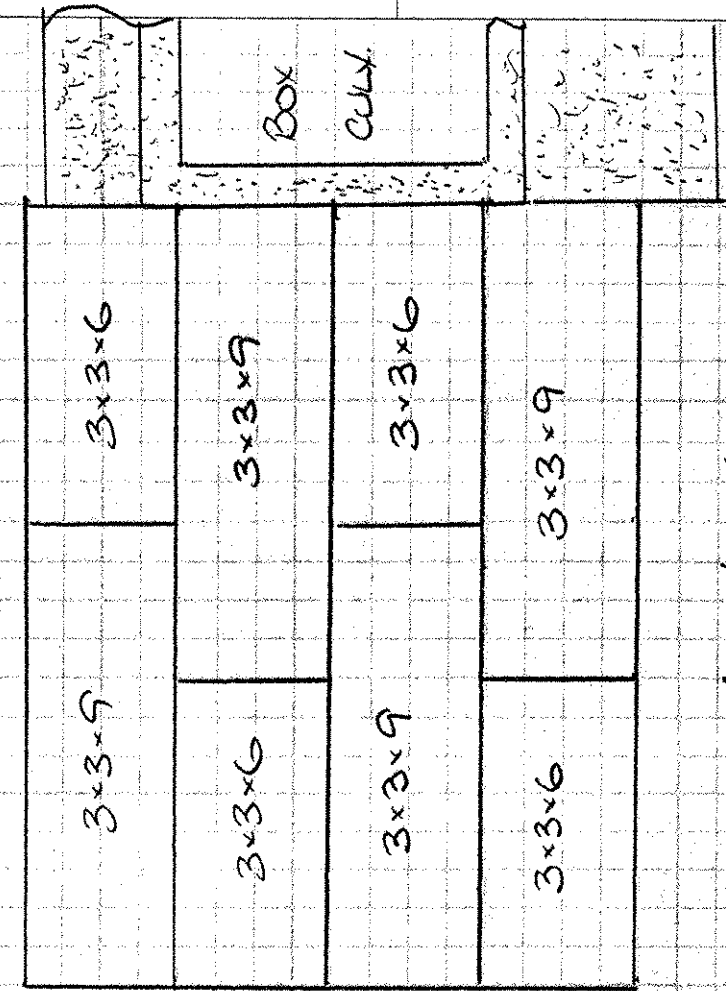

ELEVATION - TYP.
1" = 5'0

Box
CLW