

Contractor is to verify that all information shown on drawings has been thoroughly checked, compiled with the contract documents and is adequate to meet the requirements of the project. Some dimensions and details may differ slightly from contract drawings to accommodate the manufacturing or design process. Approval of this drawing indicates that any deviation from the contract documents has been reviewed and found to be acceptable. Production will not commence until receipt of signed, approved shop drawings.

This drawing contains information proprietary to CONCRETE SYSTEMS, INC. This drawing is released with the understanding that it will be retained in CONFIDENTIALITY and its use limited solely to the purpose for which it is prepared. It is understood that no portion of this drawing is authorized without the permission of CONCRETE SYSTEMS, INC. and that it will be returned to CONCRETE SYSTEMS, INC. upon request.

Stamp for structural culvert design only

Rev.	Date	DESCRIPTION
1	10/12/07	Revised Reinforcing Detail; culvert wall thickness; cut-off walls; overall length of culvert; Misc. MS
2	10/16/07	End sections to be plumb; MK 401 @ 10"; Permanent closure hardware; Misc. revisions MS
3		
4		
5		

Rev.	Date	DESCRIPTION
1	10/12/07	Revised Reinforcing Detail; culvert wall thickness; cut-off walls; overall length of culvert; Misc. MS
2	10/16/07	End sections to be plumb; MK 401 @ 10"; Permanent closure hardware; Misc. revisions MS
3		
4		
5		

This drawing is based upon information provided from the following documents and/or sources:

Other Sources:  
 Pages 1 through 17  
 Special Provisions for South Burlington AC IM CULV (9)  
 Sheets 50 through 55 of 55 sheets

Engineer:  
 VAOT  
 1-89 Over Pot Ash Brook Tributary






Project No.:  
 1-89 Over Pot Ash Brook Tributary

Drawings:  
 1-89 Over Pot Ash Brook Tributary

Specifications:  
 1-89 Over Pot Ash Brook Tributary

By: MS

Project No.:	1-89 OVER POT ASH BROOK TRIBUTARY (BRIDGE NO. 67-1)
Drawing No.:	BOX CULVERT LAYOUT AND DETAILS
Project Name:	FRANK W. WHITCOMB CONSTRUCTION CORP. SOUTH BURLINGTON, VT
Project No.:	10/16/2007
Project Name:	AC IM CULV (9)
Project No.:	10/03/2007
Project Name:	VAOT
Project No.:	10/03/2007
Project Name:	VAOT
Project No.:	10/03/2007
Project Name:	VAOT

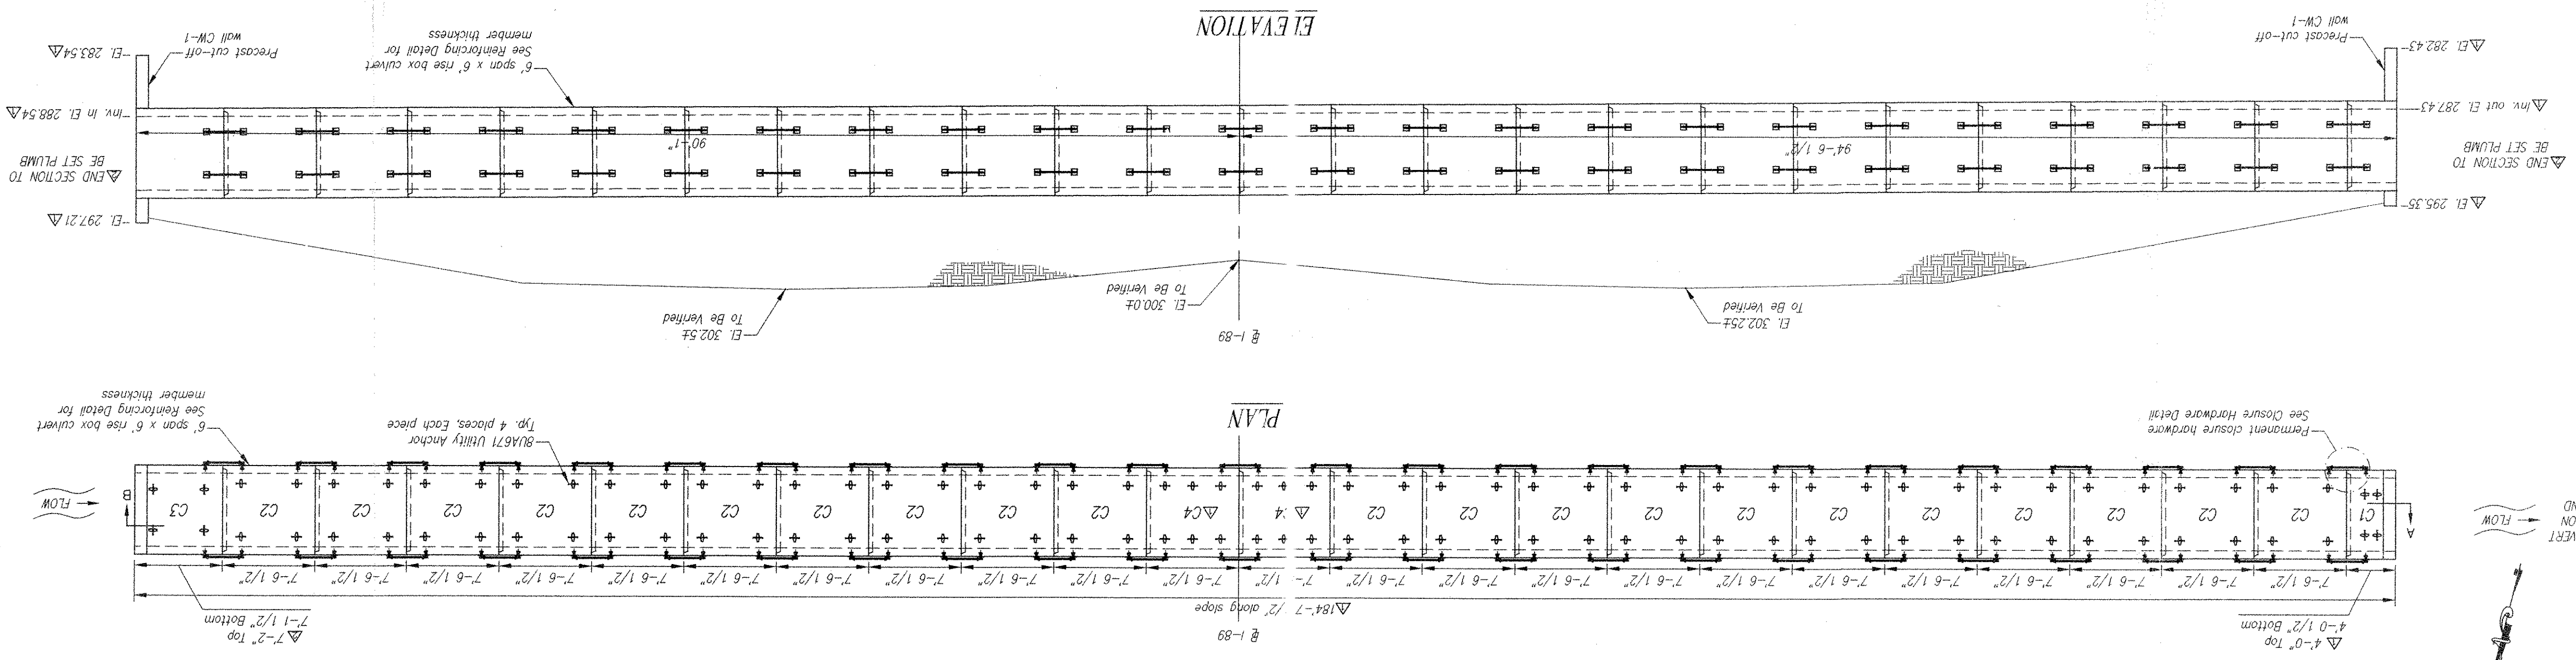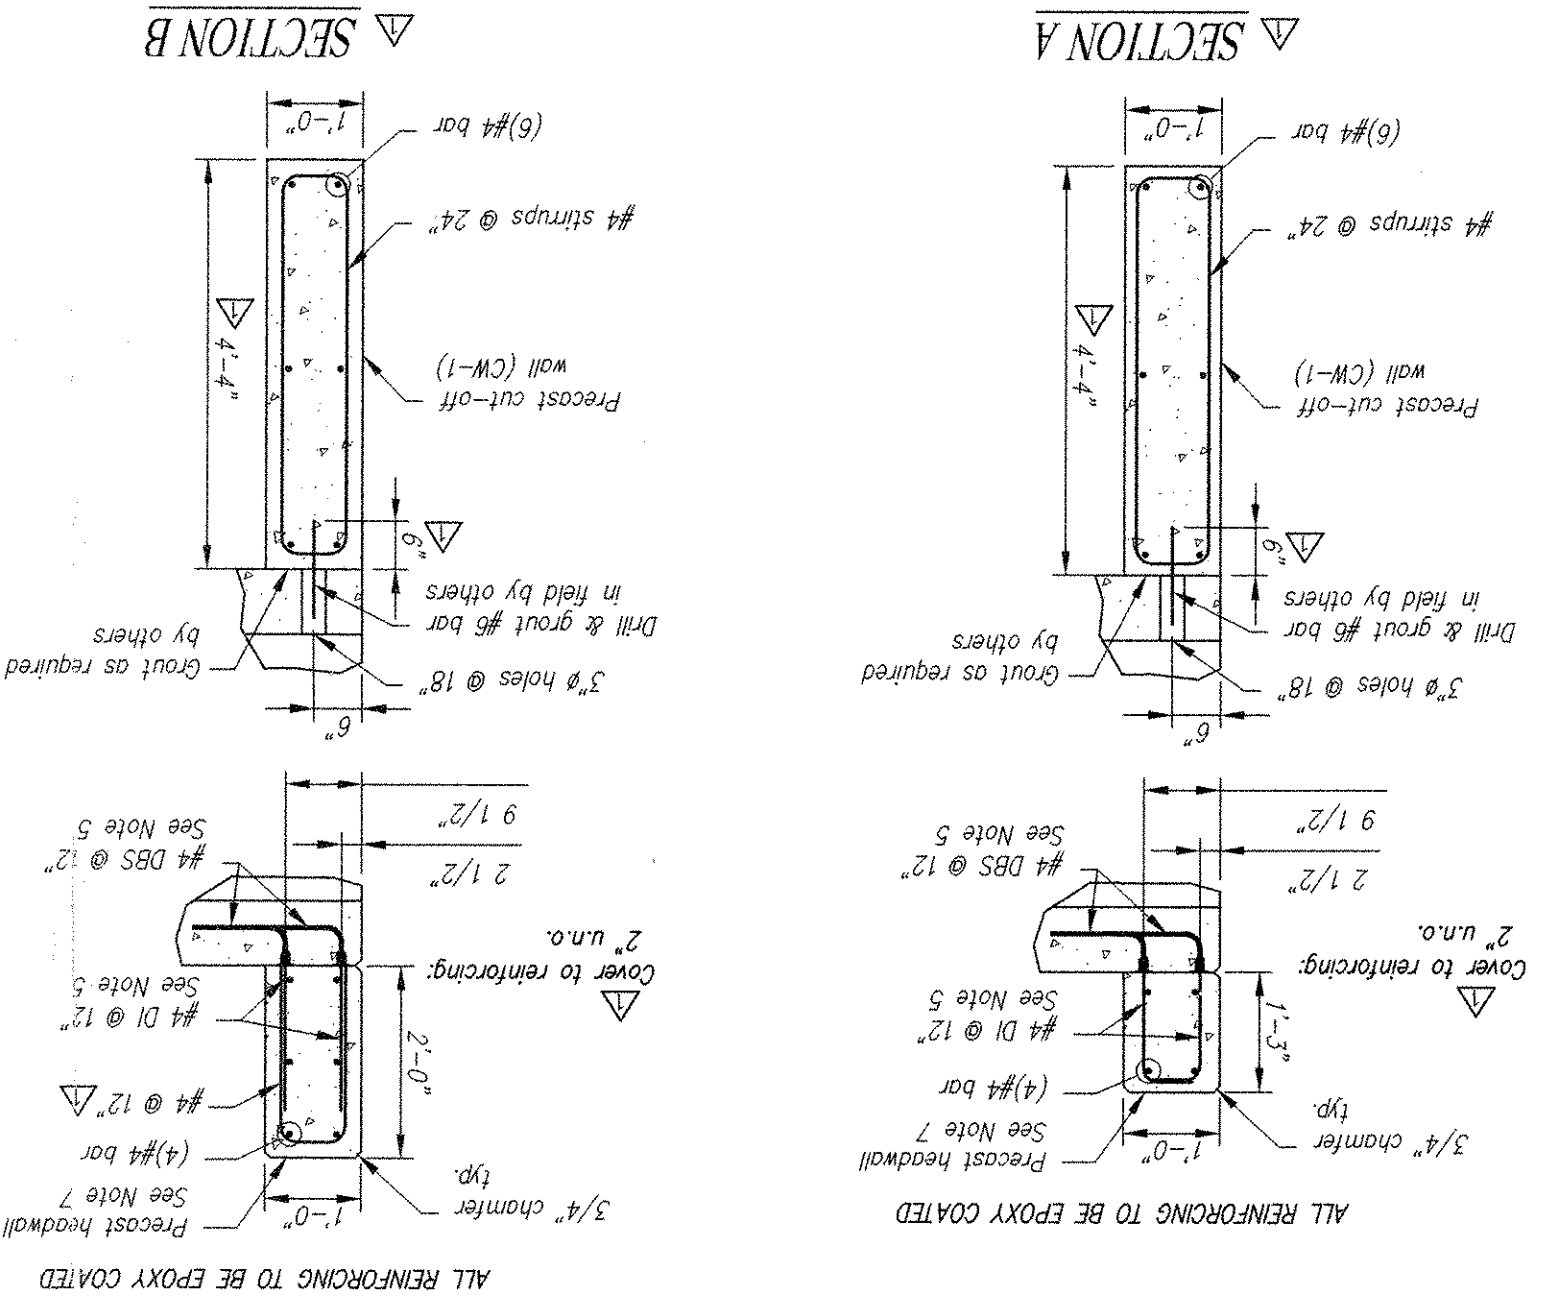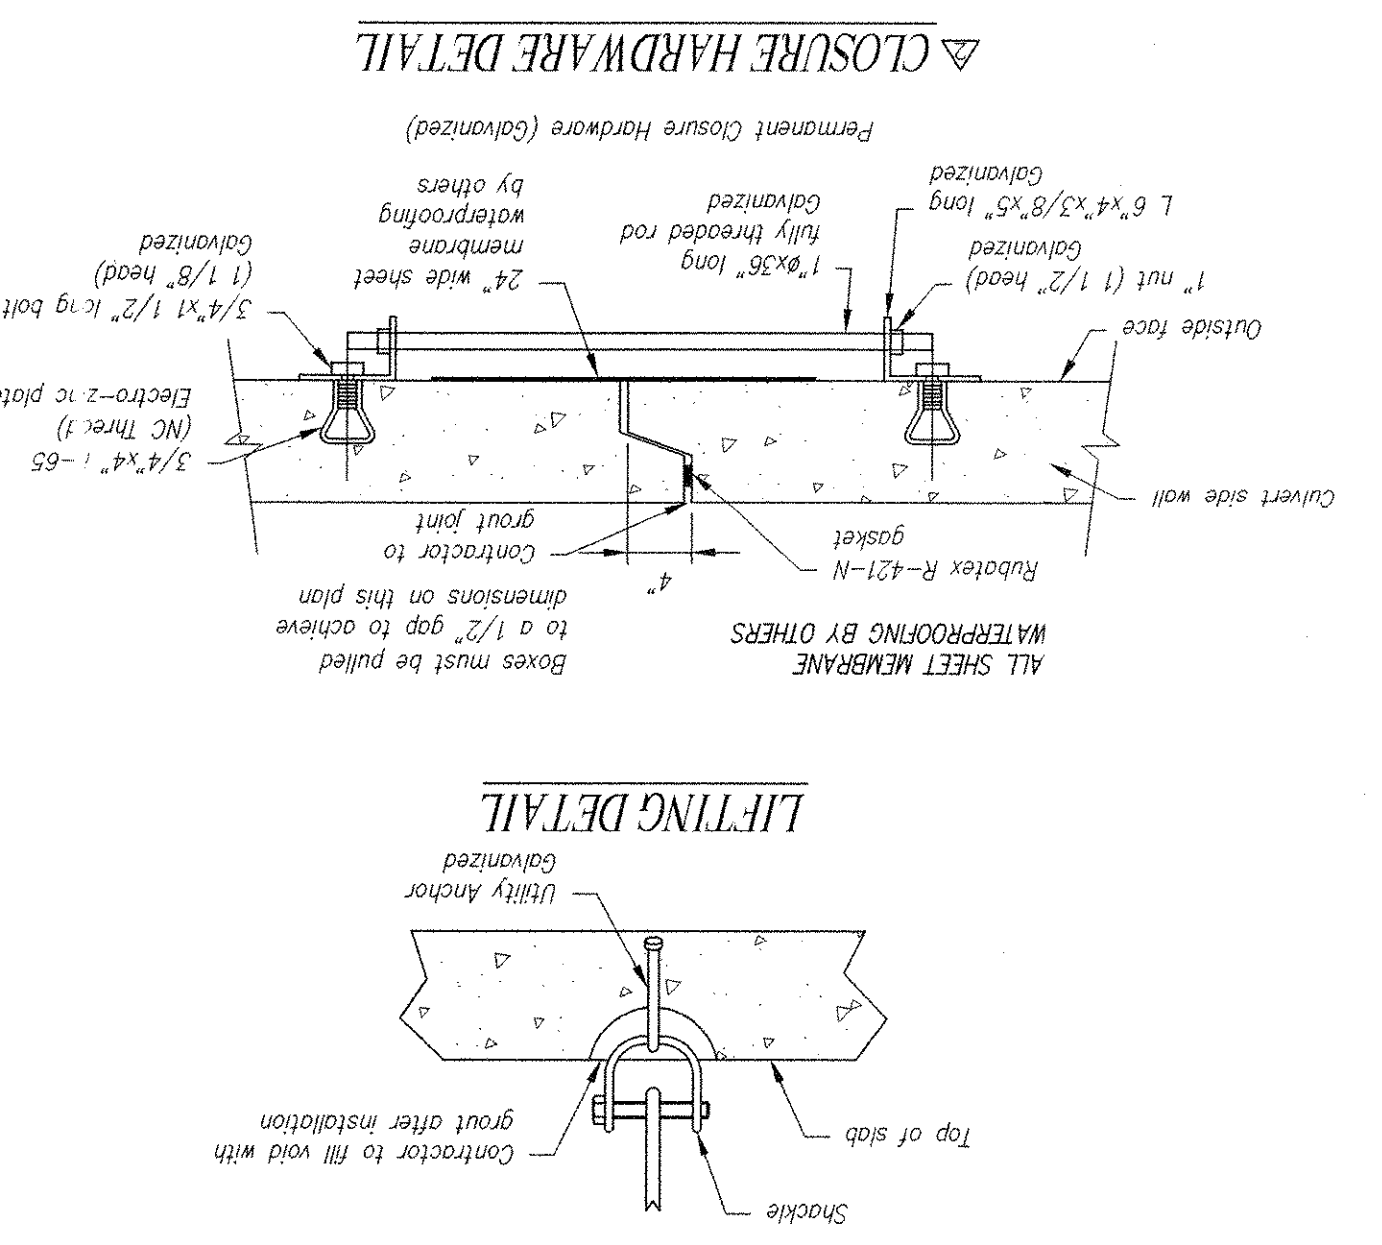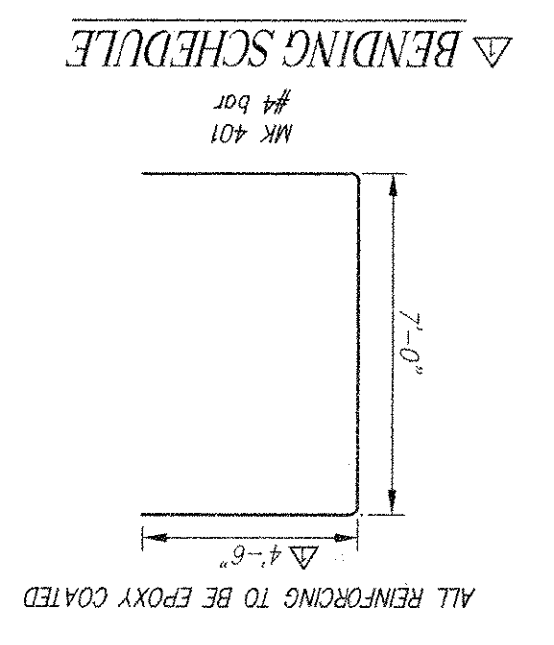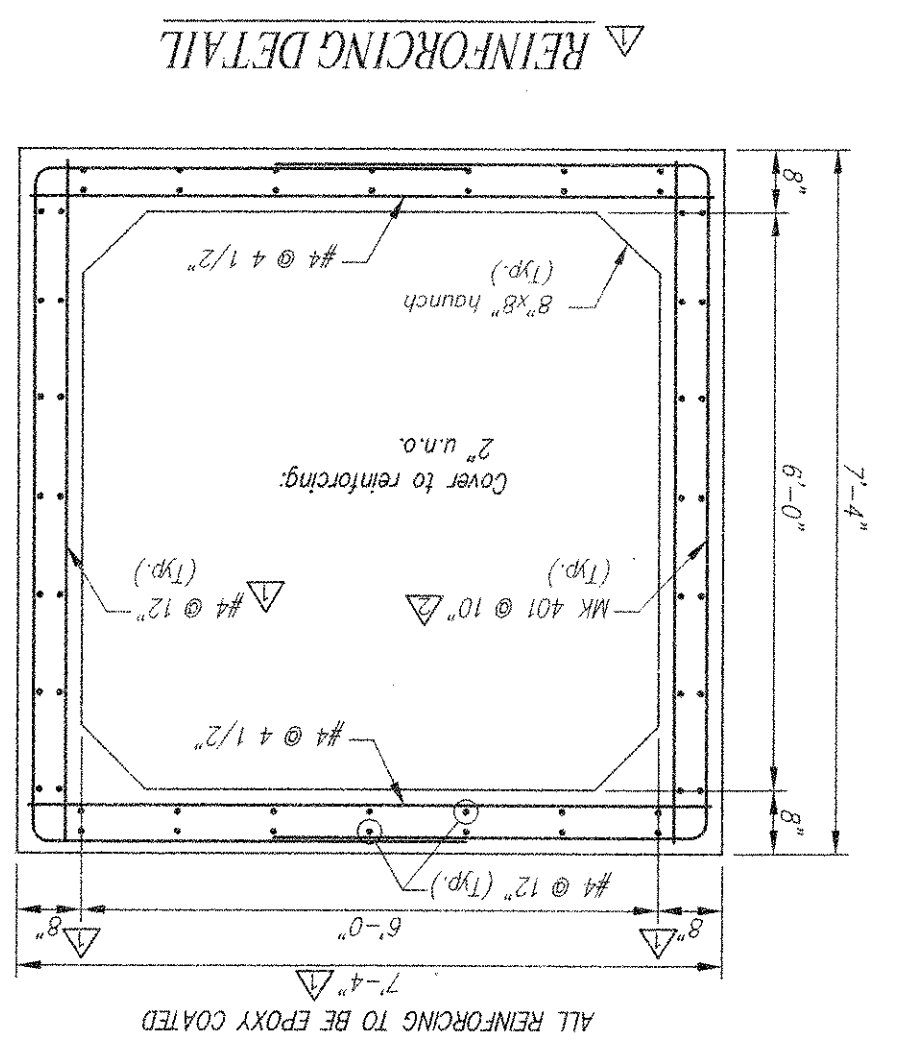

**GENERAL NOTES:**

- Reference Standards: AASHTO "Standard Specifications for Highway Bridges" ASTM C1433 Design Formers: H25 Live load: HS25 Earth Cover: 5' to 8' Concrete: Design strength  $f_c = 5000$  psi Unit weight = 150 pcf Epoxy Coated Reinforcing: ASTM A775 (rebar), grade 60, Epoxy Coated Unit weight = 140 pcf Minimum lateral pressure coefficient .25 Maximum lateral pressure coefficient .50 Cover to reinforcing: 2" u.a. Dimensions include a joint gap. Actual culvert piece length is shorter (ie. C-2 = 7'-6").
- Water repellent (Stone Siloxane) to be applied to all exposed surfaces of the headwalls and exposed interior surfaces of the culvert including the bottom surface of the top slab, the surface of the bottom slab, and the vertical walls. Water repellent applied at location of manufacture by CSI.
- DBS are Dowel Bar Spacers and DL are Dowel Bars. All inserts to be corrosion resistant or to have a corrosion resistant coating (ie. epoxy coated, galvanized, electro-zinc plated, etc.).
- Headwalls not designed for impact load.
- Mingwills by others.
- End sections, C-1 & C-3, to be set plumb.

*Handwritten signature and date: 10/16/07*

STRUCTURAL DESIGN ONLY

11/16/07  
 11/16/07  
 11/16/07

Rejected  
 Revise and Resubmit  
 Submit Specified Item