
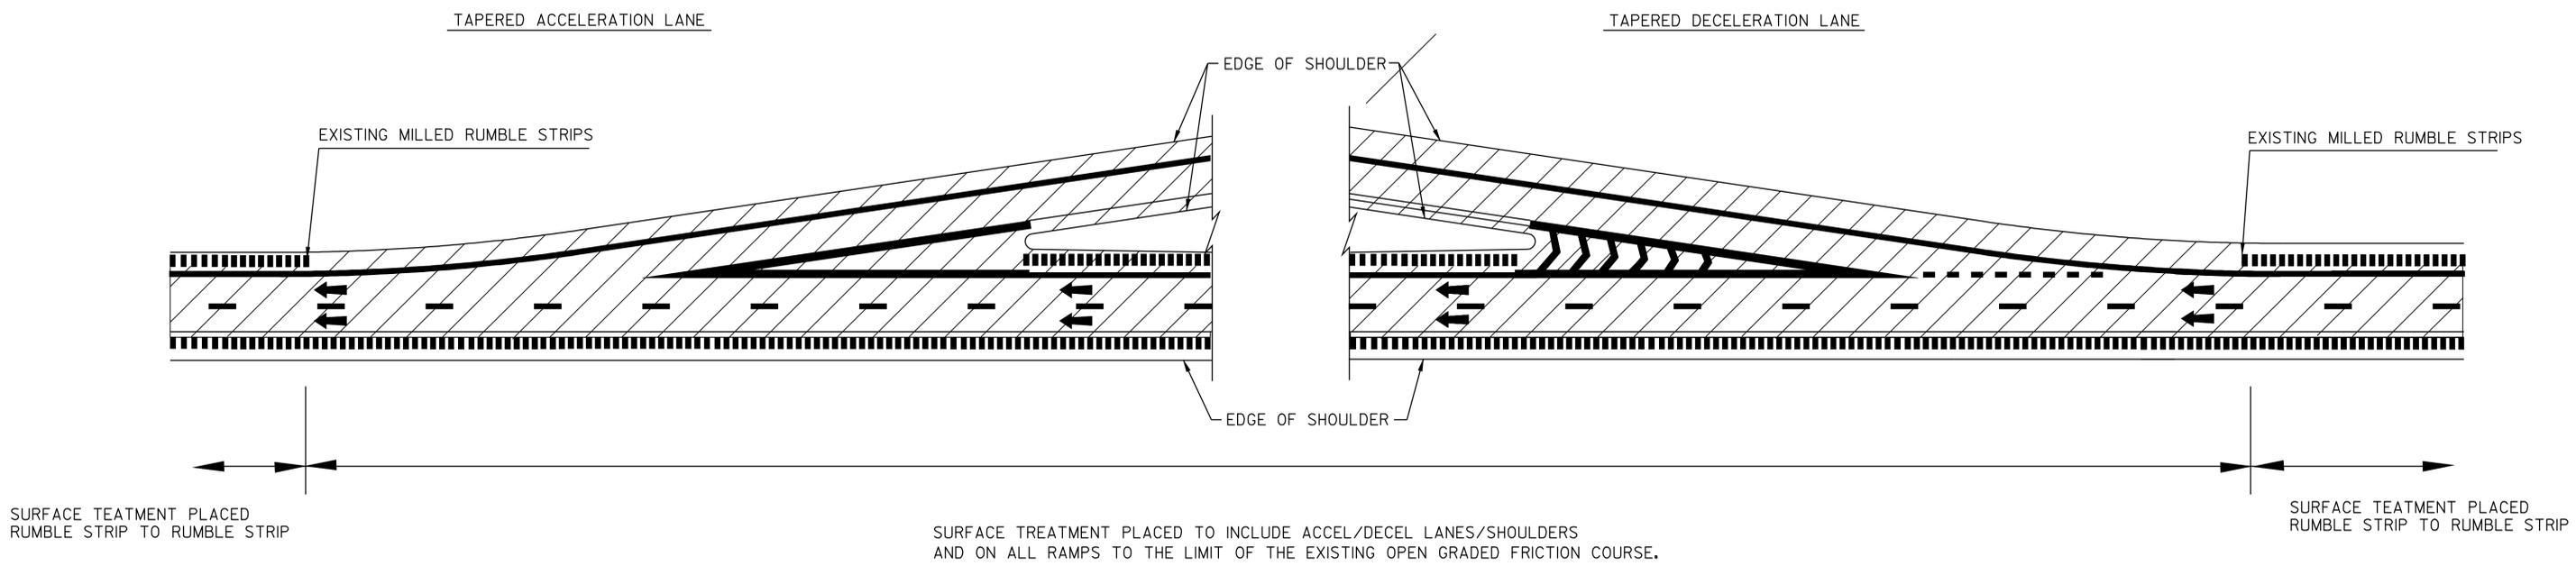
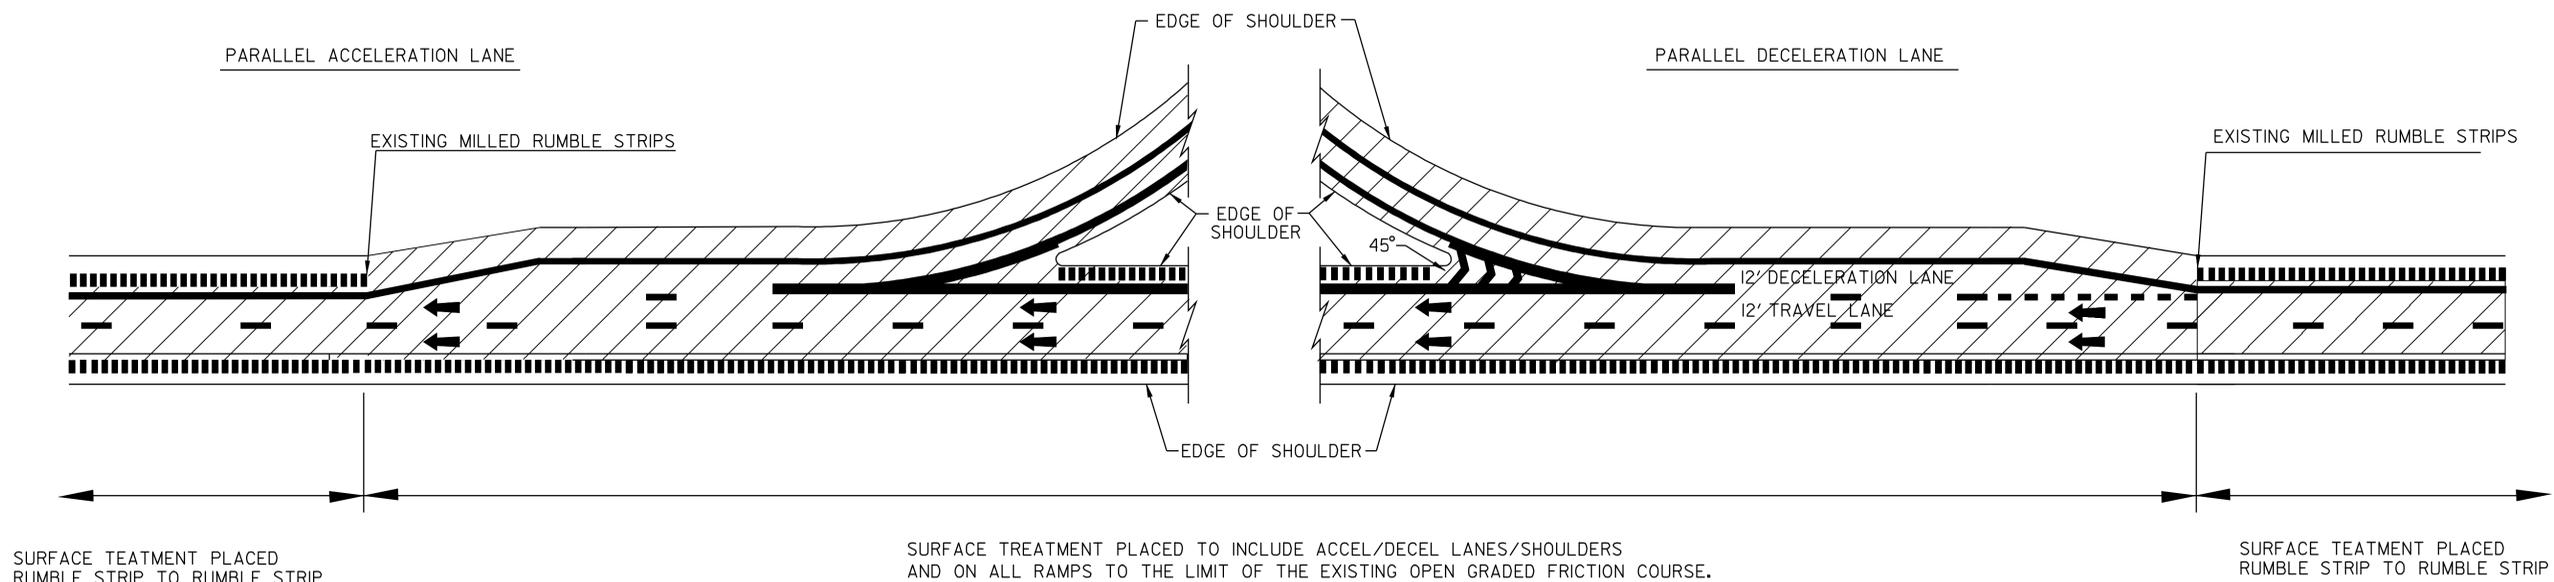


TYPICAL INTERCHANGE SURFACING DETAILS

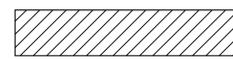

LEGEND

-  = AREA OF MICROSURFACE TREATMENT, TYPE II
-  DIRECTION OF TRAFFIC FLOW
-  MILLED RUMBLE STRIPS

NOTES:
1. LINE STRIPING SHOWN FOR REFERENCE ONLY.

N.T.S.

INTERCHANGE SURFACING DETAILS	PROJECT NAME: BARNET-WATERFORD	PLOT DATE: 08-JAN-2009 12:00
	PROJECT NUMBER: IM SURF(4)	DRAWN BY: KAS
	FILE NAME: /pave/06a180/p06a180.dgn	CHECKED BY: KML
	DESIGNED BY: KAS	SHEET 6 OF 11