



**BRIDGE COLD PLANE DETAIL**

LOCATION  
 BRIDGE 29-N NB MM STA. 44.989  
 (NO KNOWN MEMBRANE)

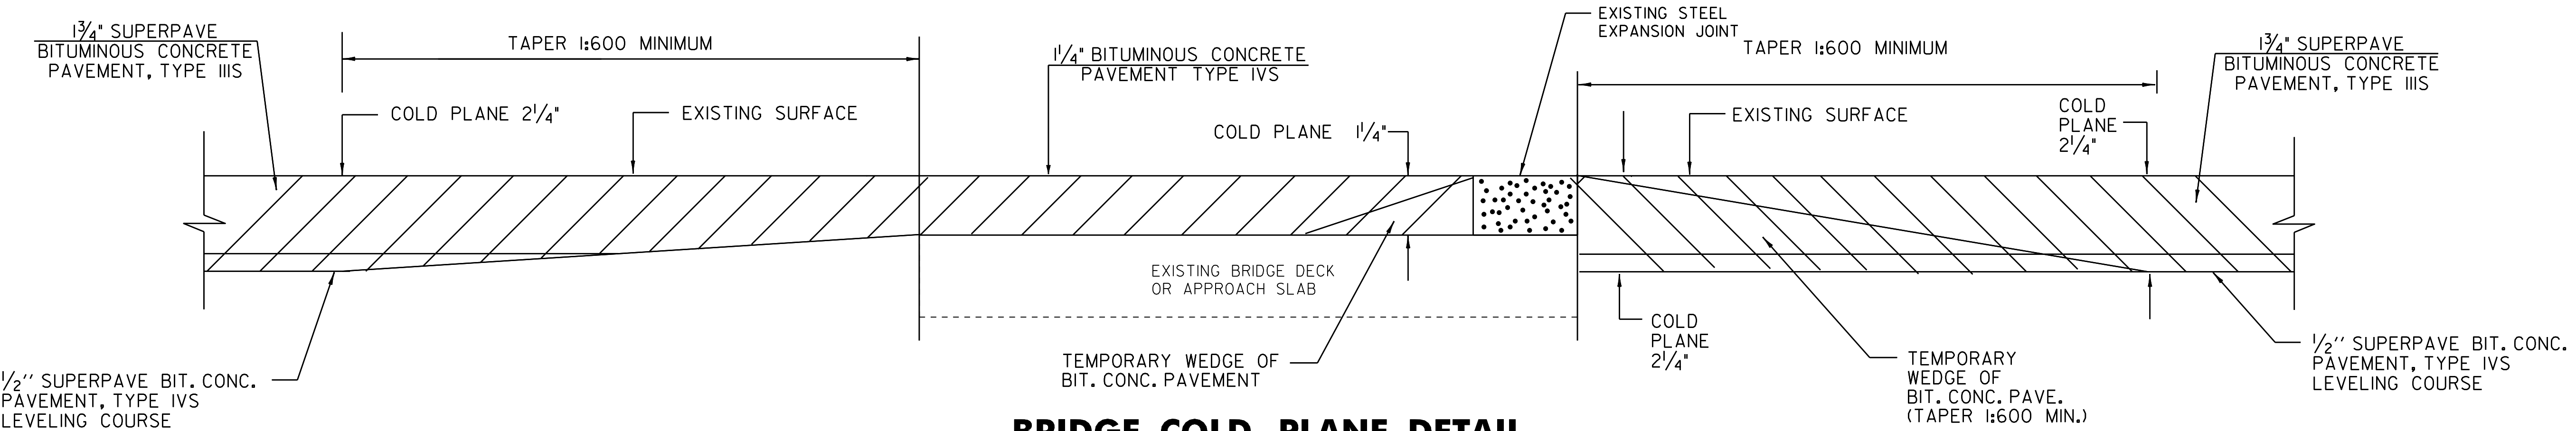

**BRIDGE COLD PLANE DETAIL**

LOCATION  
 BRIDGE 30-N NB MM STA. 51.371  
 (NO KNOWN MEMBRANE)  
 BRIDGE 34-N NB MM STA. 57.395  
 (MEMBRANE ON BRIDGE)

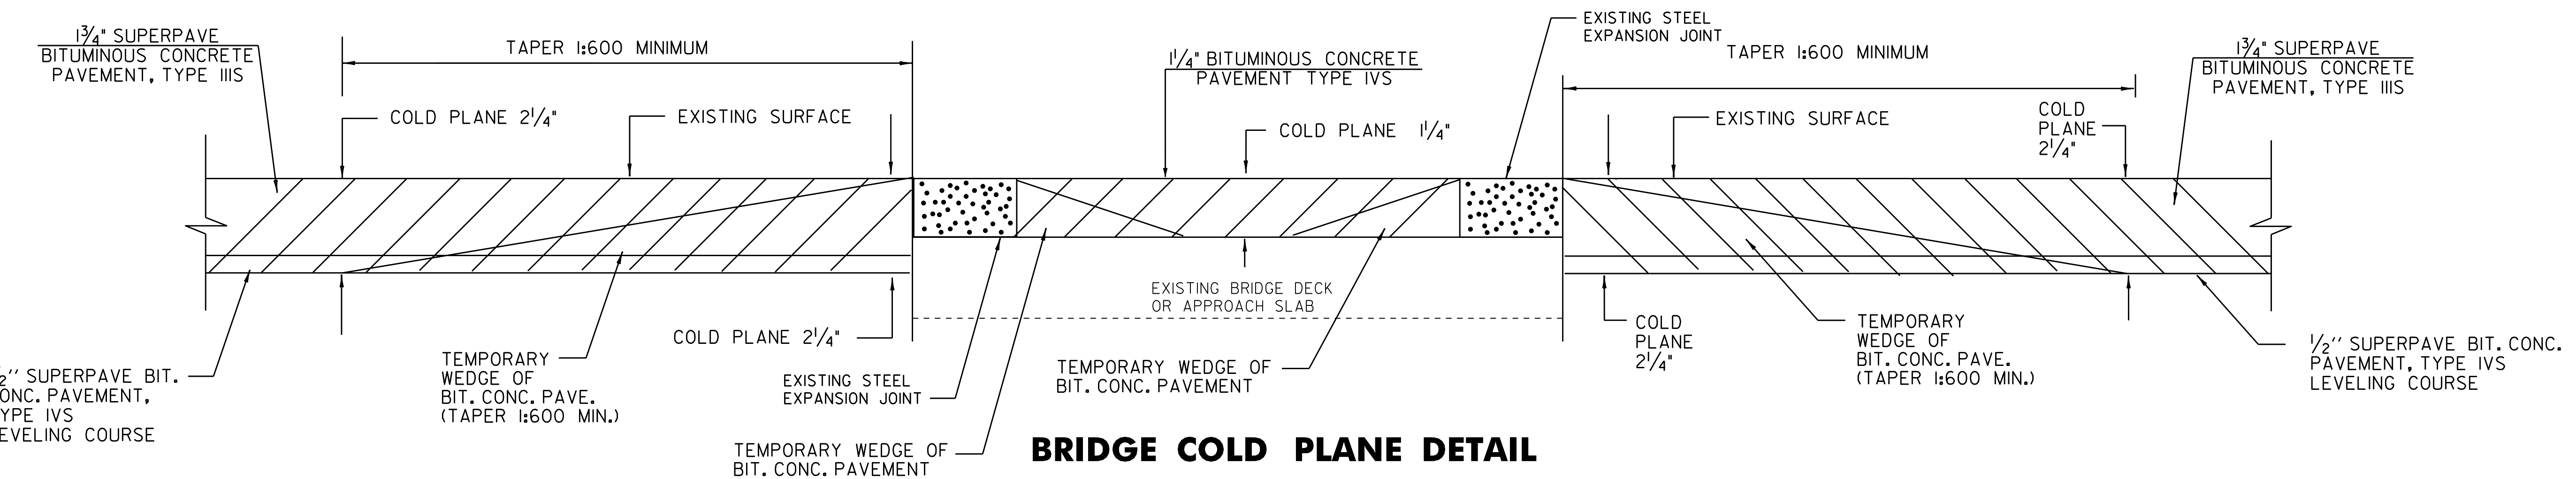

**BRIDGE COLD PLANE DETAIL**

LOCATION  
 BRIDGE 33-N NB MM STA. 55.130  
 (MEMBRANE ON BRIDGE)

- NOTES:
1. REFER TO SHEET 6 FOR ASPHALTIC PLUG JOINT LOCATIONS AND DETAILS.
  2. THE CONTACTOR SHALL TAKE PRECAUTIONS TO AVOID THE ACCUMULATION OF DEBRIS IN THE DRAINAGE STRUCTURES LOCATED AT CURB LINE AND IN THE EXPANSION JOINTS. THE CONTRACTOR SHALL EXAMINE THESE BRIDGE FEATURES ON A REGULAR BASIS TO ENSURE THAT DEBRIS HAS NOT ACCUMULATED. ANY DEBRIS WHICH IS PRESENT SHALL BE REMOVED BY THE CONTRACTOR AT NO COST TO THE STATE.
  3. SPECIAL PRECAUTIONS MUST ALSO BE TAKEN DURING THE REMOVAL OF PAVEMENT FROM AREAS ADJACENT TO FINGER OR PLATE JOINTS.

NOT TO SCALE

<b>BRIDGE COLD PLANE DETAIL SHEET</b>	PROJECT NAME: SPRINGFIELD - WINDSOR	
	PROJECT NUMBER: IM 091-1(55)	
	FILE NAME: 06A194.dgn	PLOT DATE: 28-OCT-2011 4:01
	PROJECT LEADER: LFW	DRAWN BY: LFW
DESIGNED BY: LFW	CHECKED BY: LFW	
PLOT FILE: 06A194+yp3.i		SHEET 5 OF 36