

ITEM 646.426 - DURABLE 6" WHITE LINE, RECESSED  
 NB MM STA. 44.900 TO 57.400 SOLID RT  
 NB MM STA. 44.900 TO 57.400 DASHED CL

ITEM 646.436 - DURABLE 6" YELLOW LINE, RECESSED  
 NB MM STA. 44.900 TO 57.400 SOLID LT  
 ITEM 646.632 - TEMPORARY 6" YELLOW LINE, PAINT  
 NB MM STA. 44.900 TO 57.400 SOLID LT


ITEM 621.76 - REPLACE GUARDRAIL POST ASSEMBLY  
 SEE ITEM DETAIL SHEETS FOR LOCATIONS  
 ITEM 621.50 - MANUFACTURED TERMINAL SECTION, FLARED  
 SEE ITEM DETAIL SHEETS FOR LOCATIONS  
 ITEM 621.20 - STEEL BEAM GUARDRAIL  
 SEE ITEM DETAIL SHEETS FOR LOCATIONS

ITEM 621.77 - REPLACE GUARDRAIL BEAM UNIT  
 SEE ITEM DETAIL SHEETS FOR LOCATIONS  
 ITEM 621.70 - GUARDRAIL APPROACH SECTION, GALVANIZED TYPE I  
 SEE ITEM DETAIL SHEETS FOR LOCATIONS  
 ITEM 621.71 - GUARDRAIL APPROACH SECTION, GALVANIZED TYPE II  
 SEE ITEM DETAIL SHEETS FOR LOCATIONS

ITEM 621.80 - REMOVAL & DISP. OF GUARDRAIL  
 SEE ITEM DETAIL SHEETS FOR LOCATIONS  
 621.60 - ANCHOR FOR STEEL BEAM RAIL  
 SEE ITEM DETAIL SHEETS FOR LOCATIONS

ITEM 646.622 - TEMPORARY 6" WHITE LINE, PAINT  
 NB MM STA. 44.900 TO 57.400 SOLID RT  
 NB MM STA. 44.900 TO 57.400 DASHED CL

**INTERSTATE ROUTE 91 NB  
 NB MM STA. 44.900  
 BEGIN PROJECT  
 IM 091-1(55)**

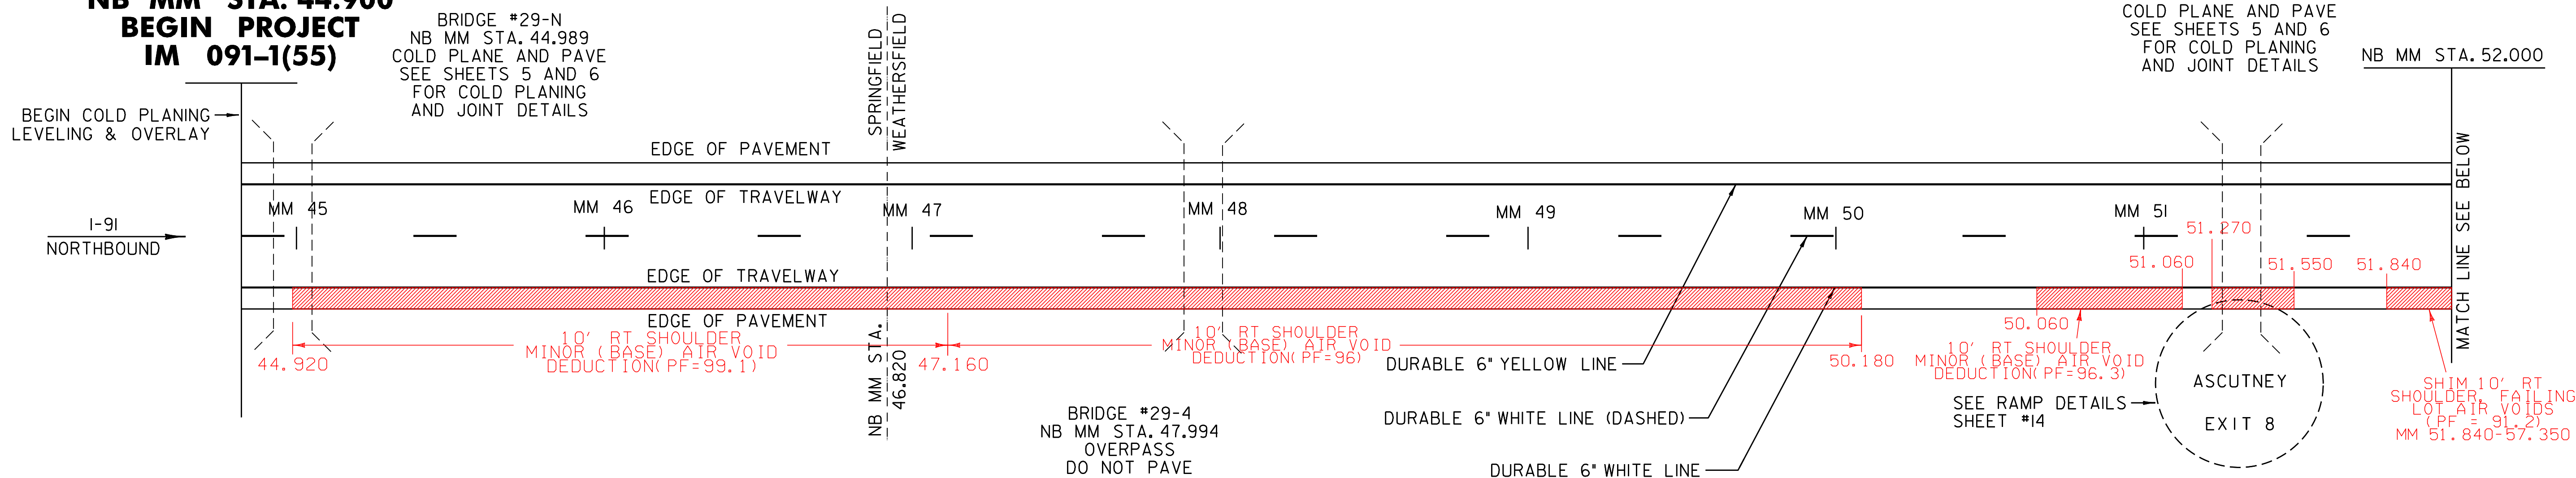


ITEM 616.47 - BITUMINOUS CONCRETE  
 GUTTERS AND TRAFFIC ISLANDS  
 NB MM STA. 48.851 RT  
 NB MM STA. 55.297 RT

NB MM STA. 53.60 (+/-)  
 END DISTRICT #2  
 BEGIN DISTRICT #4

**INTERSTATE ROUTE 91 NB  
 NB MM STA. 57.414 438  
 END PROJECT  
 IM 091-1(55)**

ITEM 604.412 - REHAB. DROP INLETS, CATCH  
 BASINS OR MANHOLES, CLASS I

NB MM STA. 46.217 RT	NB MM STA. 52.708 LT & RT
NB MM STA. 46.235 LT	NB MM STA. 52.765 LT & RT
NB MM STA. 46.249 RT	NB MM STA. 53.101 LT
NB MM STA. 46.264 LT	NB MM STA. 53.866 RT
NB MM STA. 46.477 RT	NB MM STA. 53.922 RT
NB MM STA. 47.777 RT	NB MM STA. 54.900 RT
NB MM STA. 47.843 RT	NB MM STA. 54.948 RT
NB MM STA. 47.895 RT	NB MM STA. 55.010 RT
NB MM STA. 47.922 RT	NB MM STA. 55.058 RT
NB MM STA. 48.636 RT	NB MM STA. 56.388 RT
NB MM STA. 48.683 RT	NB MM STA. 56.692 RT
NB MM STA. 48.726 RT	NB MM STA. 56.739 RT
NB MM STA. 48.768 RT	NB MM STA. 57.315 RT
NB MM STA. 51.050 RT	NB MM STA. 57.364 RT
NB MM STA. 51.389 RT	NB MM STA. 51.335 RT
NB MM STA. 51.943 RT	NB MM STA. 57.364 LT

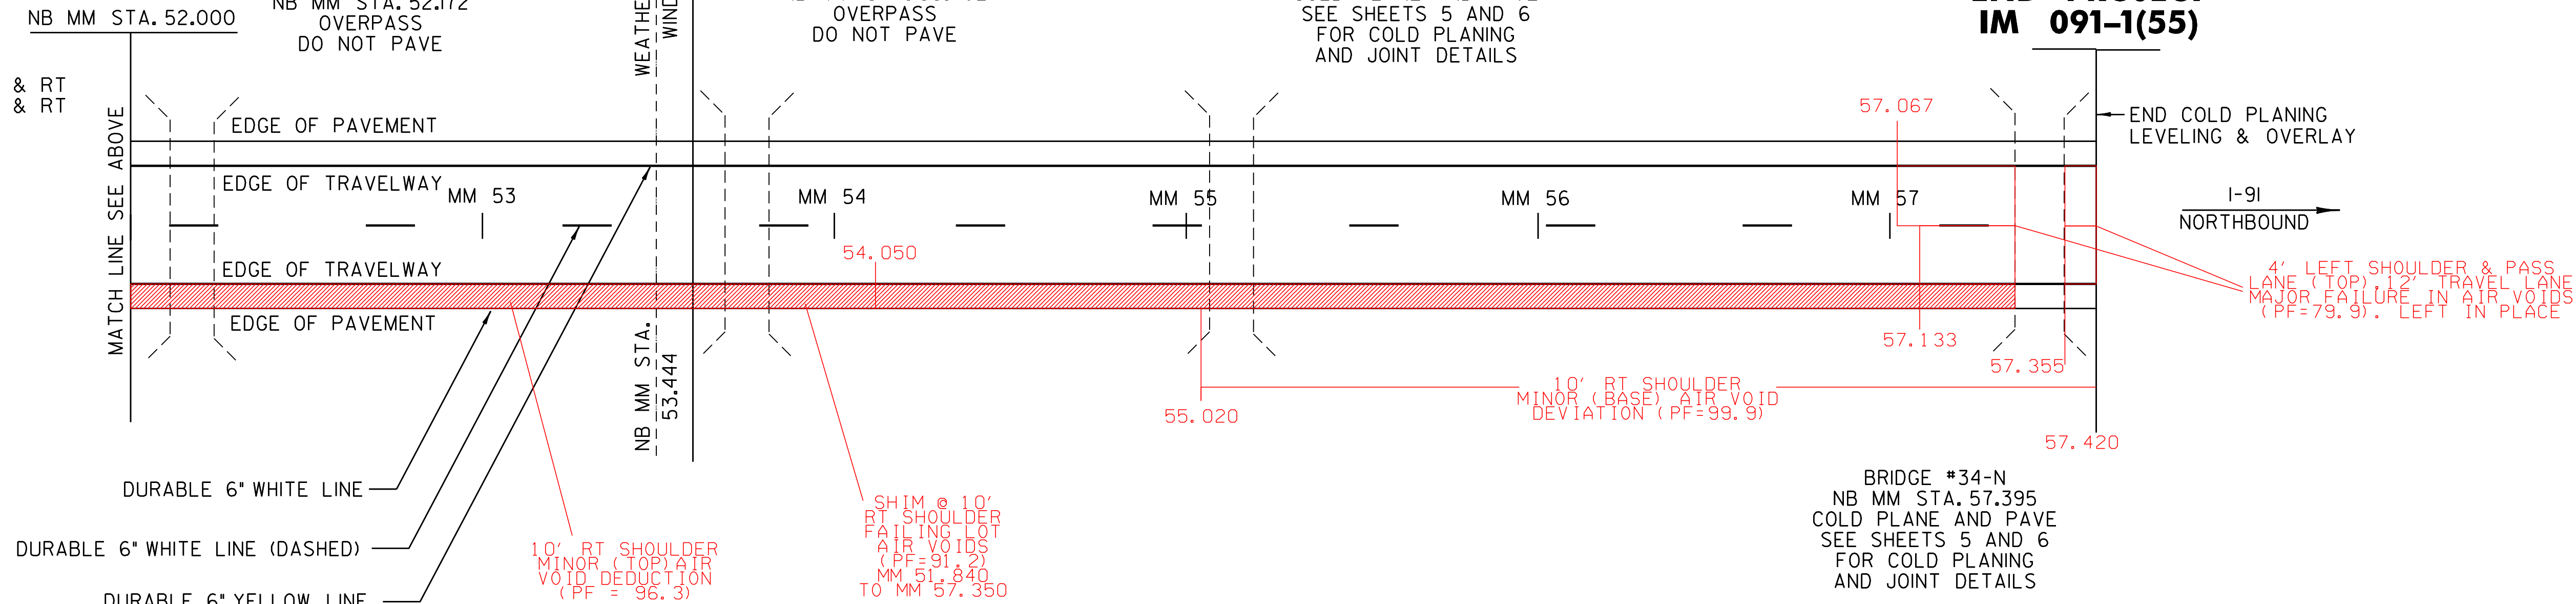

SEE PROJECT PAVING LIMITS TABLE ON  
 PROJECT TYPICAL SHEET I FOR ROADWAY  
 DIMENSIONS.

NOT TO SCALE

ITEM 620.75 - SNOW BARRIER - GALVANIZED

BRIDGE #29-4 (OVERPASS) (TWO 62 FOOT SECTIONS ON EACH SIDE OF BR #29-4 OVER THE NB & SB LANES) (248 FEET TOTAL)  
 BRIDGE #31 (OVERPASS) (TWO 66 FOOT SECTIONS ON EACH SIDE OF BR #31 OVER THE NB & SB LANES) (264 FEET TOTAL)  
 BRIDGE #32 (OVERPASS) (TWO 82 FOOT SECTIONS ON EACH SIDE OF BR #32 OVER THE NB & SB LANES) (328 FEET TOTAL)

ITEM 676.10 - DELINEATOR WITH STEEL POST  
 REFER TO STANDARDS E-197, E-198,  
 AND E-199 FOR PLACEMENT GUIDELINES  
 (SEE ITEM DETAIL SHEETS FOR LOCATIONS)

**PAVING  
 PROJECT  
 LAYOUT  
 SHEET**

PROJECT NAME: SPRINGFIELD - WINDSOR	
PROJECT NUMBER: IM 091-1(55)	
FILE NAME: 06A194.dgn	PLOT DATE: 28-OCT-2011 14:01
PROJECT LEADER: LFW	DRAWN BY: LFW
DESIGNED BY: LFW	CHECKED BY: LFW
PLOT FILE: 06A194pls.i	SHEET 13 OF 36