

DURABLE 6 INCH  
YELLOW LINE


DURABLE 6 INCH  
DOTTED WHITE LINE

DURABLE 6 INCH  
DASHED WHITE LINE

DURABLE 6 INCH  
WHITE LINE

DURABLE 12 INCH  
WHITE LINE

DURABLE 6 INCH  
YELLOW LINE

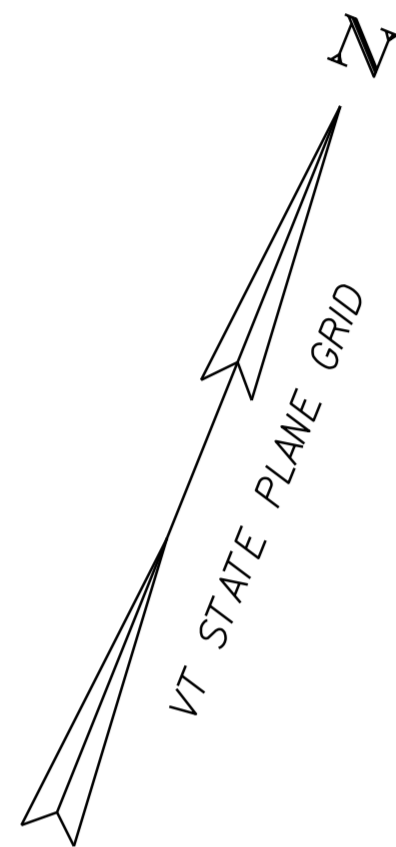

**RAMP RADII INFORMATION**

RAMP	RADII, FT	DESCRIPTION
B	300	STA. 0+95 TO STA. 2+48
	445	STA. 3+67 TO STA. 8+36

**646.426 DURABLE 6 INCH WHITE LINE, RECESSED**

MAINLINE  
 STA. 5611+10 TO STA. 5614+86 (SOLID RT)  
 STA. 5611+10 TO STA. 5613+69 (DOTTED RT)  
 STA. 5613+69 TO STA. 5614+42 (DASHED RT)  
 RAMP B  
 STA. 0+15 TO STA. 8+42 (SOLID RT)

**646.436 DURABLE 6 INCH YELLOW LINE, RECESSED**

RAMP B  
 STA. 0+15 TO STA. 7+09 (SOLID RT)

**646.466 DURABLE 12 INCH WHITE LINE, RECESSED**

MAINLINE  
 STA. 5614+42 TO STA. 5616+30 (GORE MARKINGS)  
 RAMP B  
 STA. 7+09 TO 8+08 (GORE MARKINGS)

**646.482 DURABLE 24 INCH STOP BAR, THERMOPLASTIC**

RAMP B  
 STA. 0+24 LT & RT

**646.492 DURABLE LETTER OR SYMBOL, THERMOPLASTIC**

RAMP B  
 STA. 3+09 RT "ARROW"  
 STA. 6+98 RT "AHEAD"  
 STA. 7+38 RT "STOP"

0+27 \*STOP\*

**646.622 TEMPORARY 6 INCH WHITE LINE, PAINT**

MAINLINE  
 STA. 5611+10 TO STA. 5614+86 (SOLID RT)  
 STA. 5611+10 TO STA. 5613+69 (DOTTED RT)  
 STA. 5613+69 TO STA. 5614+42 (DASHED RT)  
 RAMP B  
 STA. 0+15 TO STA. 8+42 (SOLID RT)

**646.632 TEMPORARY 6 INCH YELLOW LINE, PAINT**

RAMP B  
 STA. 0+15 TO STA. 7+09 (SOLID RT)

**646.662 TEMPORARY 12 INCH WHITE LINE, PAINT**

MAINLINE  
 STA. 5614+42 TO STA. 5616+30 (GORE MARKINGS)  
 RAMP B  
 STA. 7+09 TO 8+08 (GORE MARKINGS)

**646.692 TEMPORARY LETTER OR SYMBOL, PAINT**

RAMP B  
 STA. 0+33 RT "STOP"  
 STA. 3+09 RT ARROW  
 STA. 6+98 RT "AHEAD"  
 STA. 7+38 RT "STOP"

**675.50 REMOVING SIGNS**

AS SHOWN - 25












**675.60 ERECTING SALVAGED SIGNS**

AS SHOWN - 6

NOT TO SCALE

REMOVALS=2+3+3+11+8+2+5=34

**LEGEND**  
 N = NEW  
 R = REMOVE  
 B-B = BACK TO BACK  
 RET = RETAIN

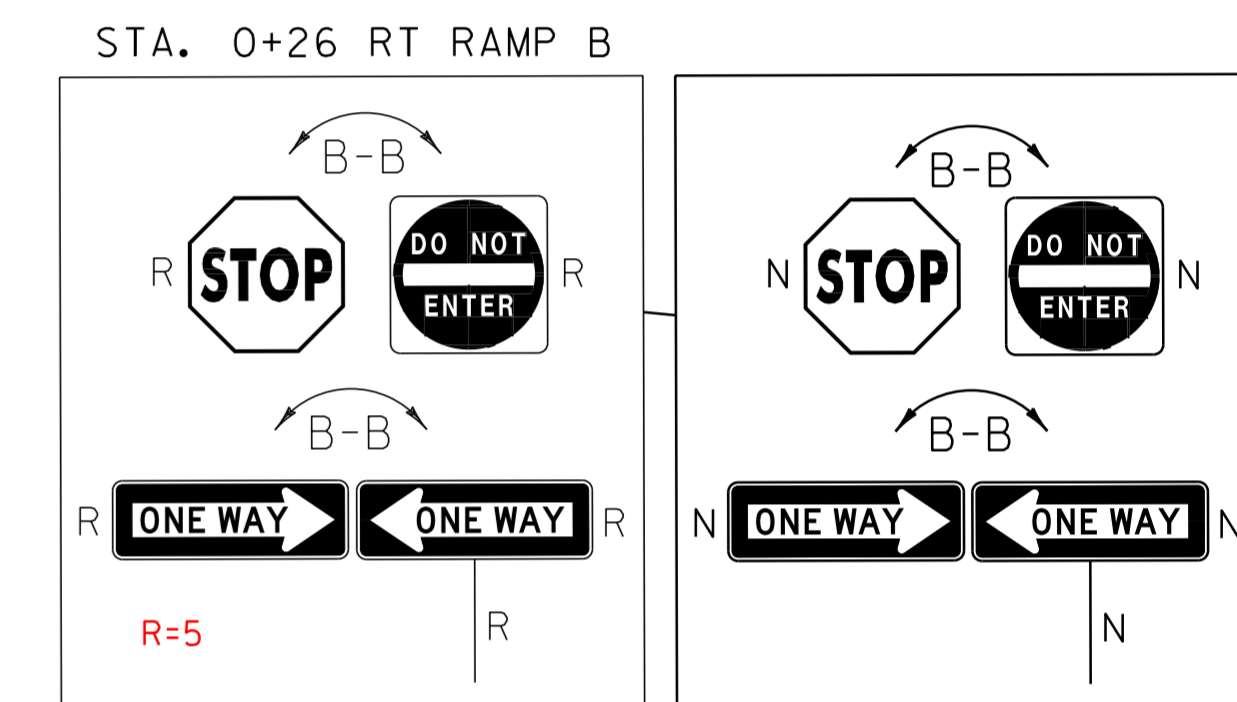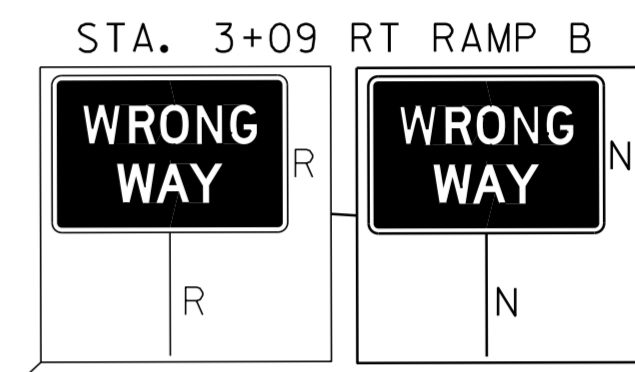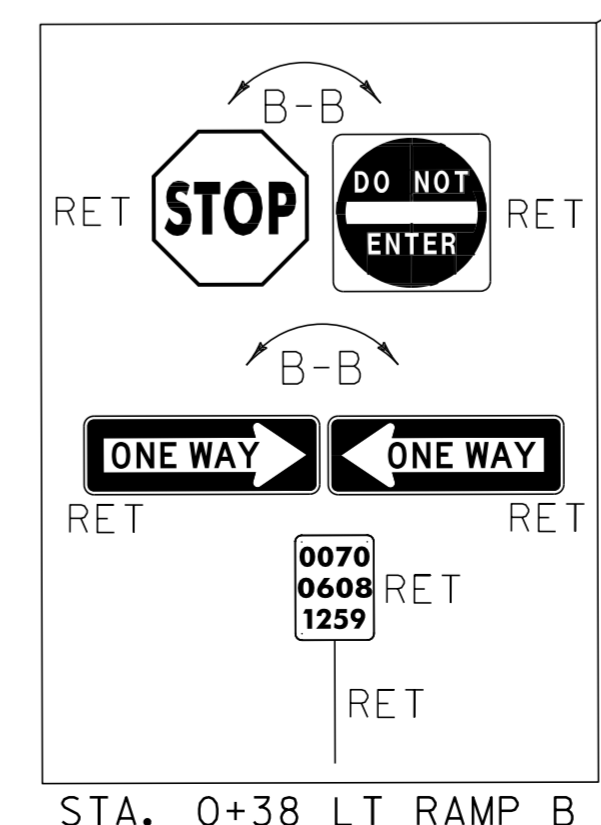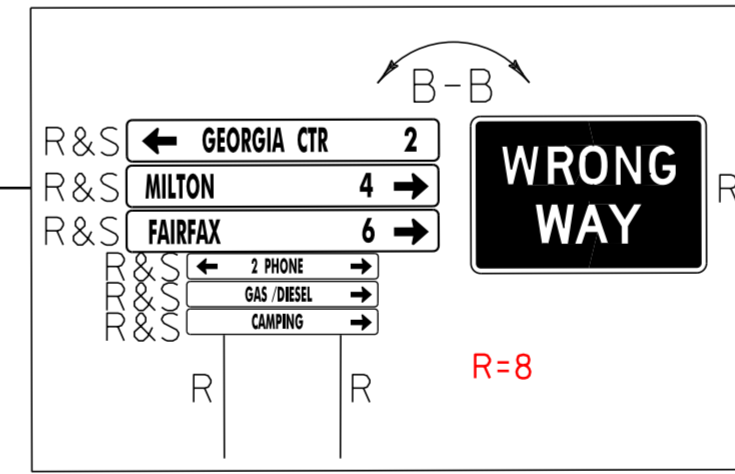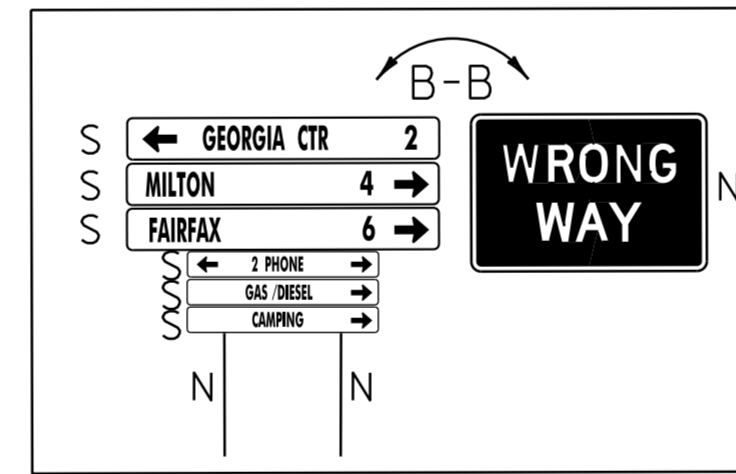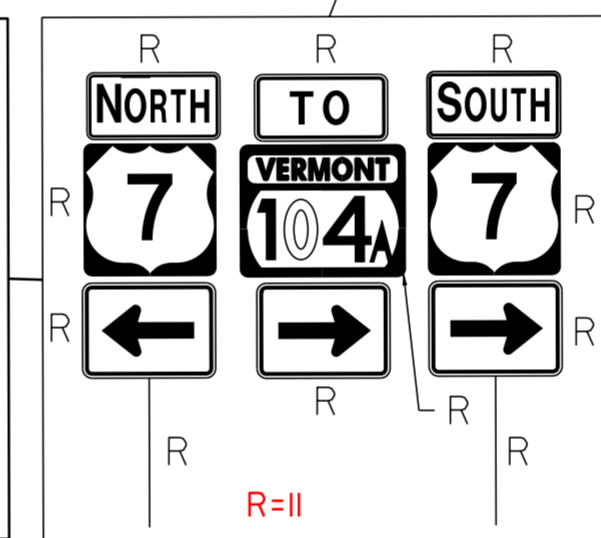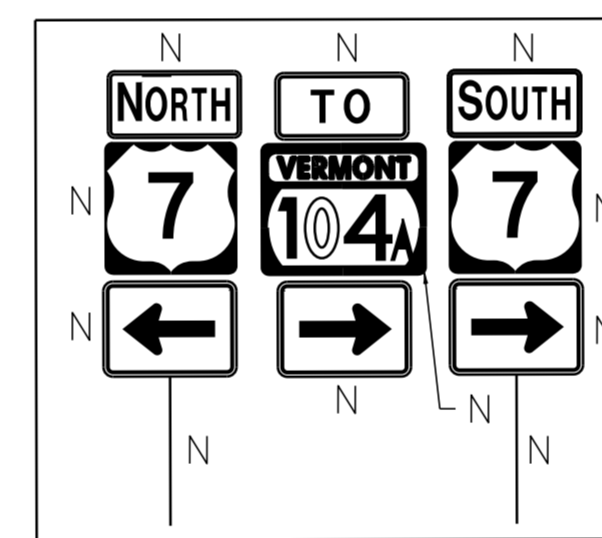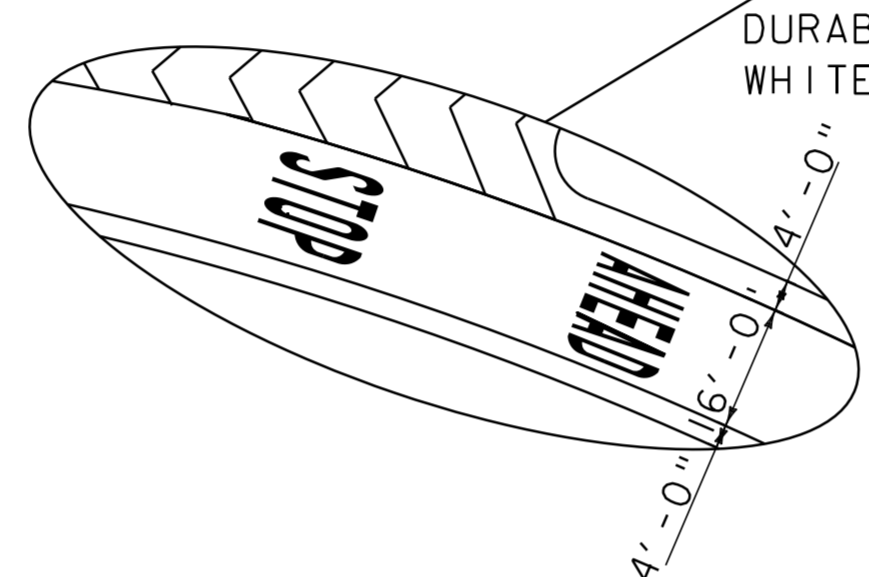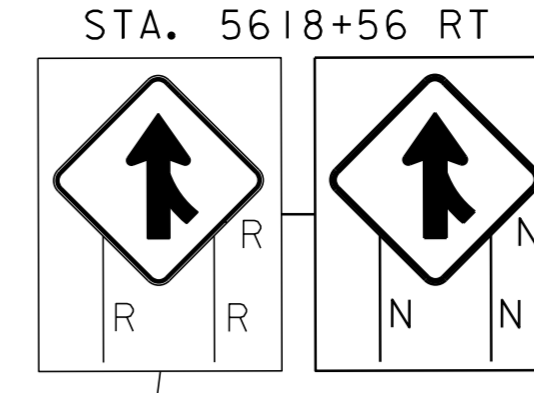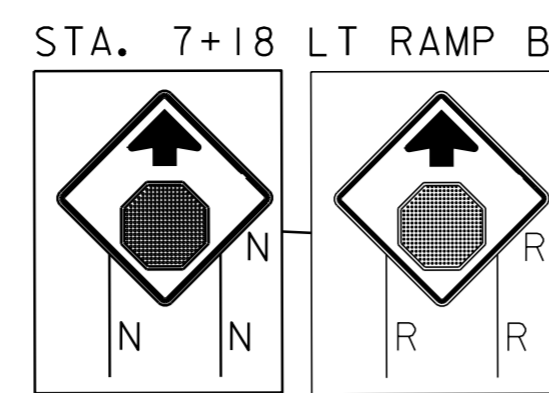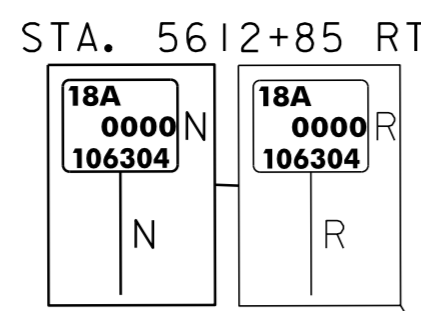

**RAMP DETAIL SHEET  
INTERCHANGE  
#18 RAMP B**

PROJECT NAME: COLCHESTER - GEORGIA  
 PROJECT NUMBER: IM 089-3(64)  
 FILE NAME: p06a196.dgn  
 PROJECT LEADER: CDL  
 DESIGNED BY: SJL  
 PLOT FILE: p06a196rds118b.i  
 PLOT DATE: 04-OCT-2011 16:52  
 DRAWN BY: RHB/SJL  
 CHECKED BY: CDL  
 SHEET 15 OF 23