

# EXIT 3 - RAMP A NORTHBOUND ON RAMP

SEE STANDARDS E-191, E-192 AND E-193  
FOR PAVEMENT MARKING GUIDELINES

TEMPORARY 6" WHITE LINE, PAINT  
DURABLE 6" WHITE LINE, RECESSED

210+50 TO 219+73 SOLID RT  
1182+78 TO 1183+50 DASHED RT

TEMPORARY 6" YELLOW LINE, PAINT  
DURABLE 6" YELLOW LINE, RECESSED

210+50 TO 215+43 SOLID LT

TEMPORARY 12" WHITE LINE, PAINT  
DURABLE 12" WHITE LINE, RECESSED

215+43 TO 218+00 SOLID LT 257'  
1178+48 TO 1182+78 SOLID RT 430'

SHOULDER BERM REMOVAL


210+50 TO 210+80 RT  
218+50 TO 219+50 RT

REHAB. DROP INLETS, CATCH BASINS,  
OR MANHOLES, CLASS I, CLASS II OR CLASS III

210+80 RT  
213+33 RT  
215+59 RT  
215+64 RT

DELINEATORS

REFER TO STANDARDS E-197 AND  
E-198 FOR PLACEMENT GUIDELINES

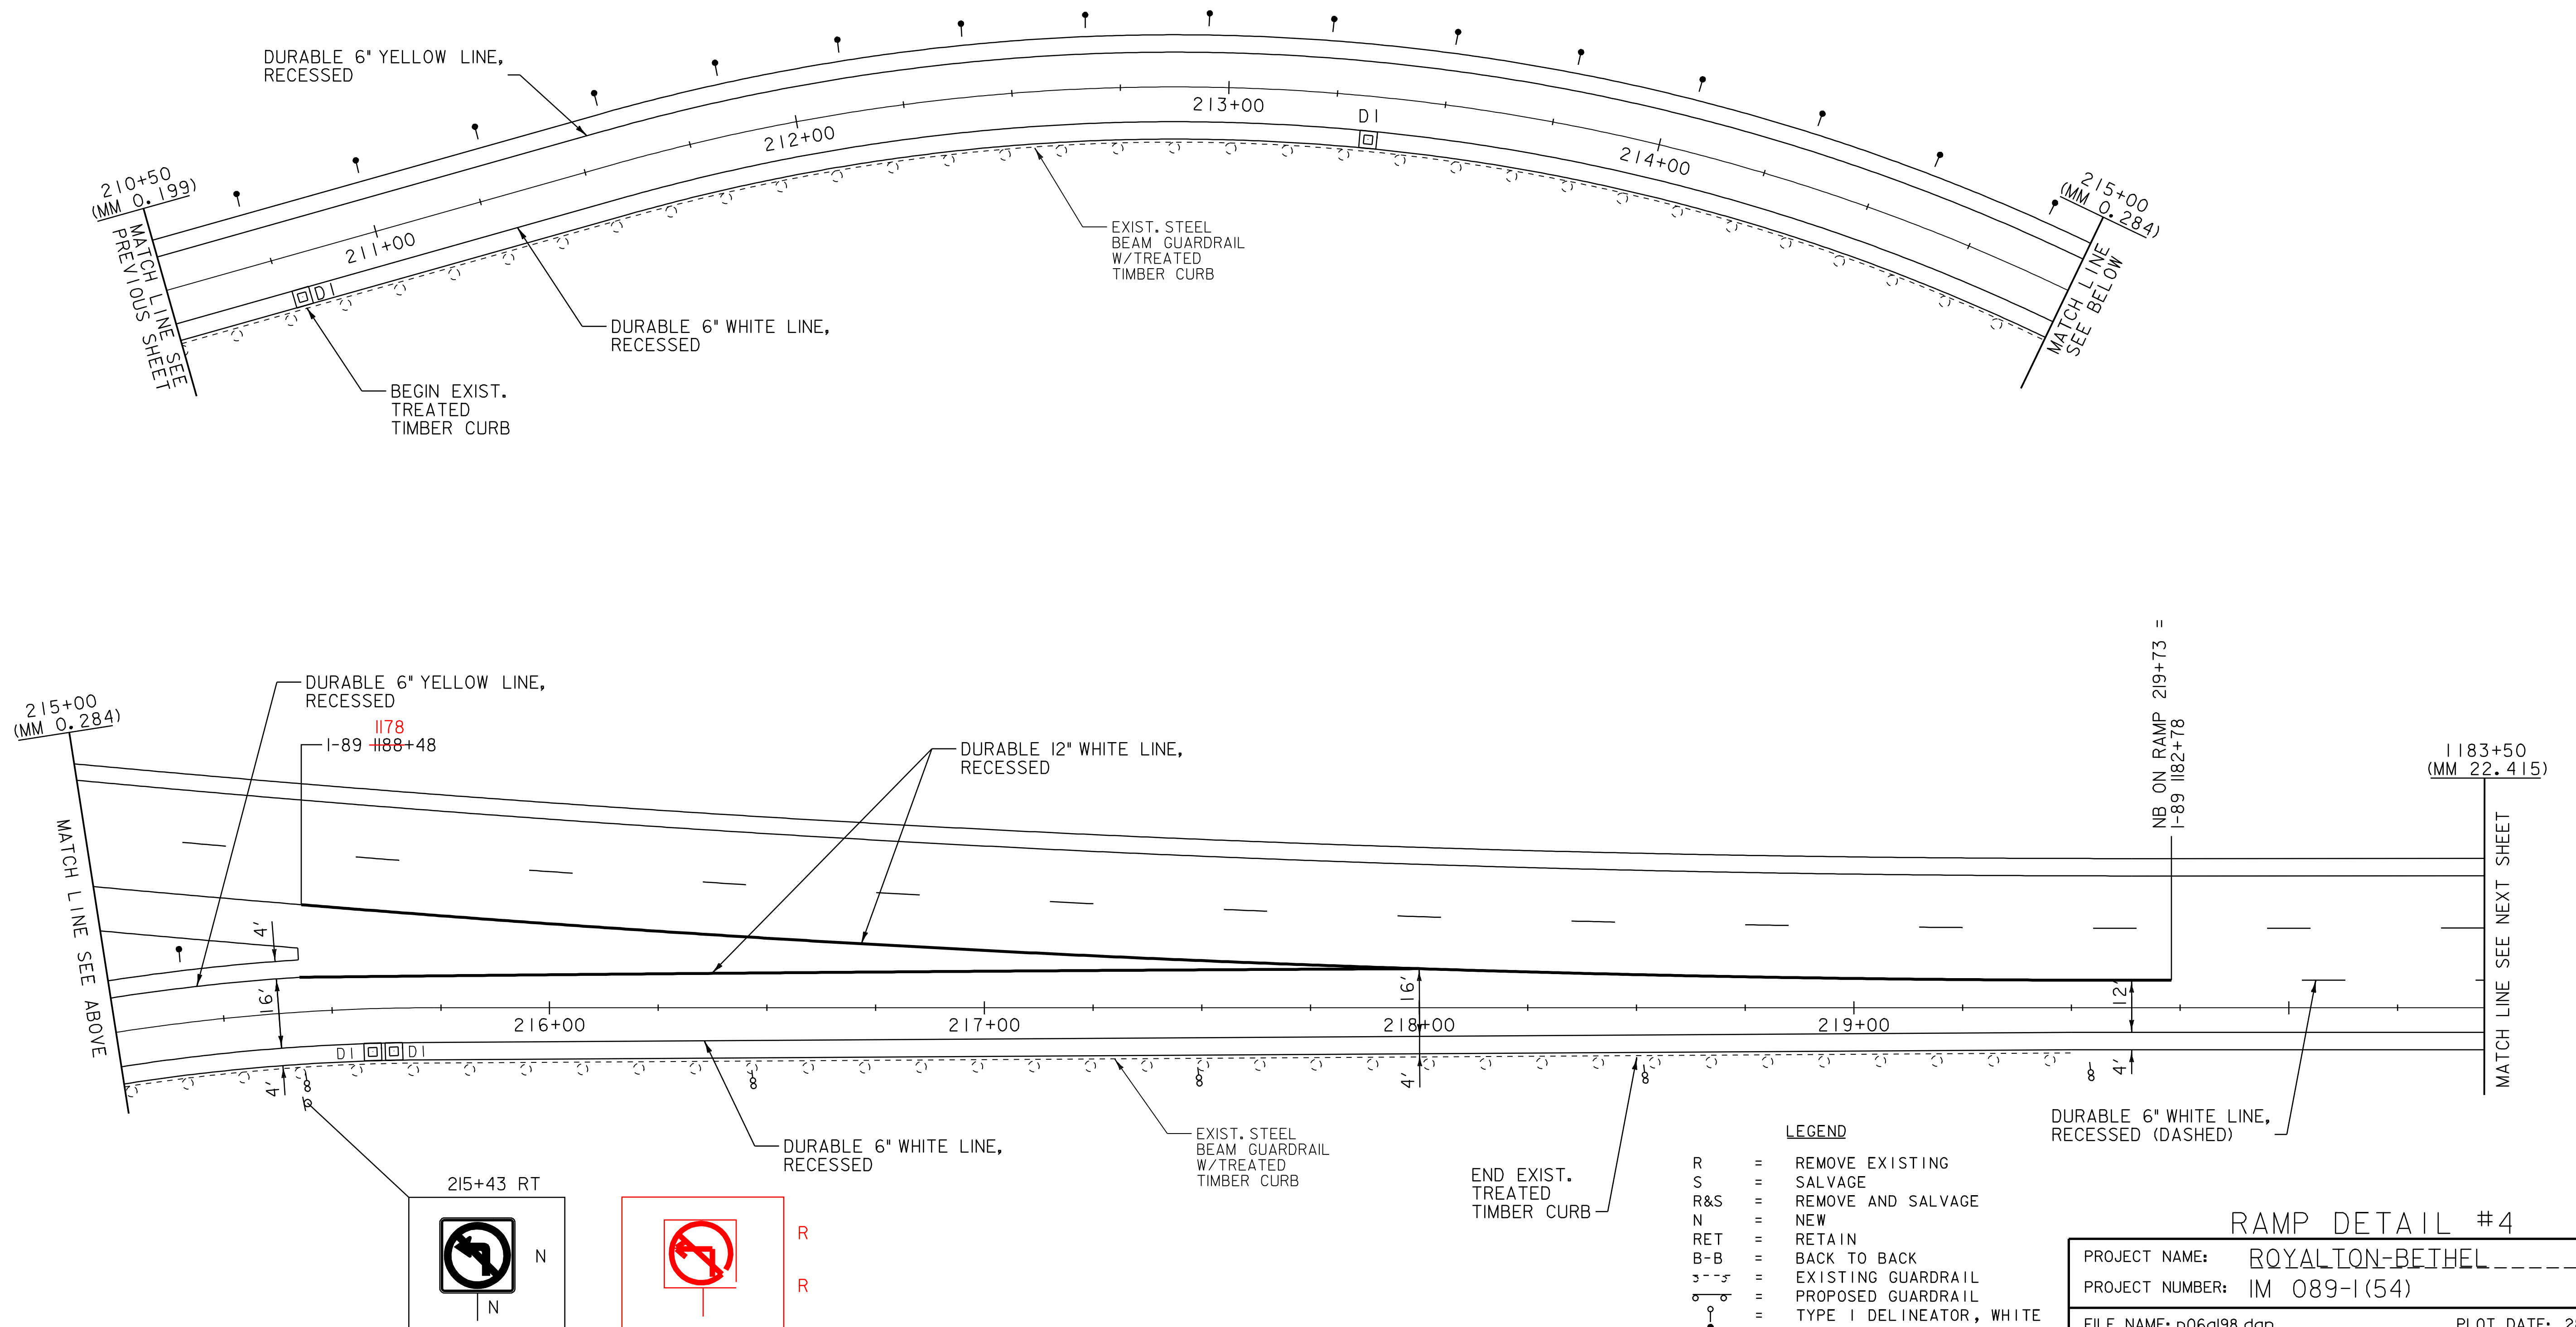

NOT TO SCALE

## RAMP DETAIL #4

PROJECT NAME: ROYALTON-BETHEL	
PROJECT NUMBER: IM 089-1(54)	
FILE NAME: p06a198.dgn	PLOT DATE: 28-JUN-2010 15:12
PROJECT LEADER: PTS	DRAWN BY: MRS
DESIGNED BY: NULL	CHECKED BY: PTS
IPARM FILE NAME: p06a198r4.1	SHEET 17 OF 37