

GUARDRAIL TREATMENT AT BULLNOSE LOCATION - BRIDGE

BRIDGE 26 NORTHBOUND & SOUTHBOUND MM 21.918
INTERSTATE 89 OVER WHITE RIVER AND VT 107

REMOVAL AND DISPOSAL OF GUARDRAIL
 NB 1155+58.0 TO 1157+80.0 LT
 NB 1168+20.5 TO 1170+34.0 LT
 SB 1156+70.0 TO 1157+80.0 RT
 SB 1168+20.5 TO 1170+34.0 RT

STEEL BEAM GUARDRAIL, GALVANIZED
 NB 1153+55.0 TO 1157+55.0 LT
 NB 1168+20.5 TO 1168+45.5 LT
 SB 1157+30.0 TO 1157+55.0 RT
 SB 1168+20.5 TO 1172+08.0 RT


ALUMINUM APPROACH RAILING
 NB 1157+55.0 TO 1157+80.0 LT
 SB 1157+55.0 TO 1157+80.0 RT

MANUFACTURED TERMINAL SECTION, FLARED DELINEATOR WITH STEEL POST
 NB 1153+17.5 TO 1153+55.0 LT
 SB 1172+08.0 TO 1172+45.5 RT

ANCHOR FOR STEEL BEAM RAIL
 NB 1168+45.5 LT
 SB 1157+30.0 RT


EXCAVATION OF SURFACES AND PAVEMENTS (PLACE 4" TOPSOIL, SEED, FERTILIZER, LIMESTONE AND **TEMPORARY EROSION MATTING**)

1172+53 TO 1173+33
(REMOVE U-TURN)

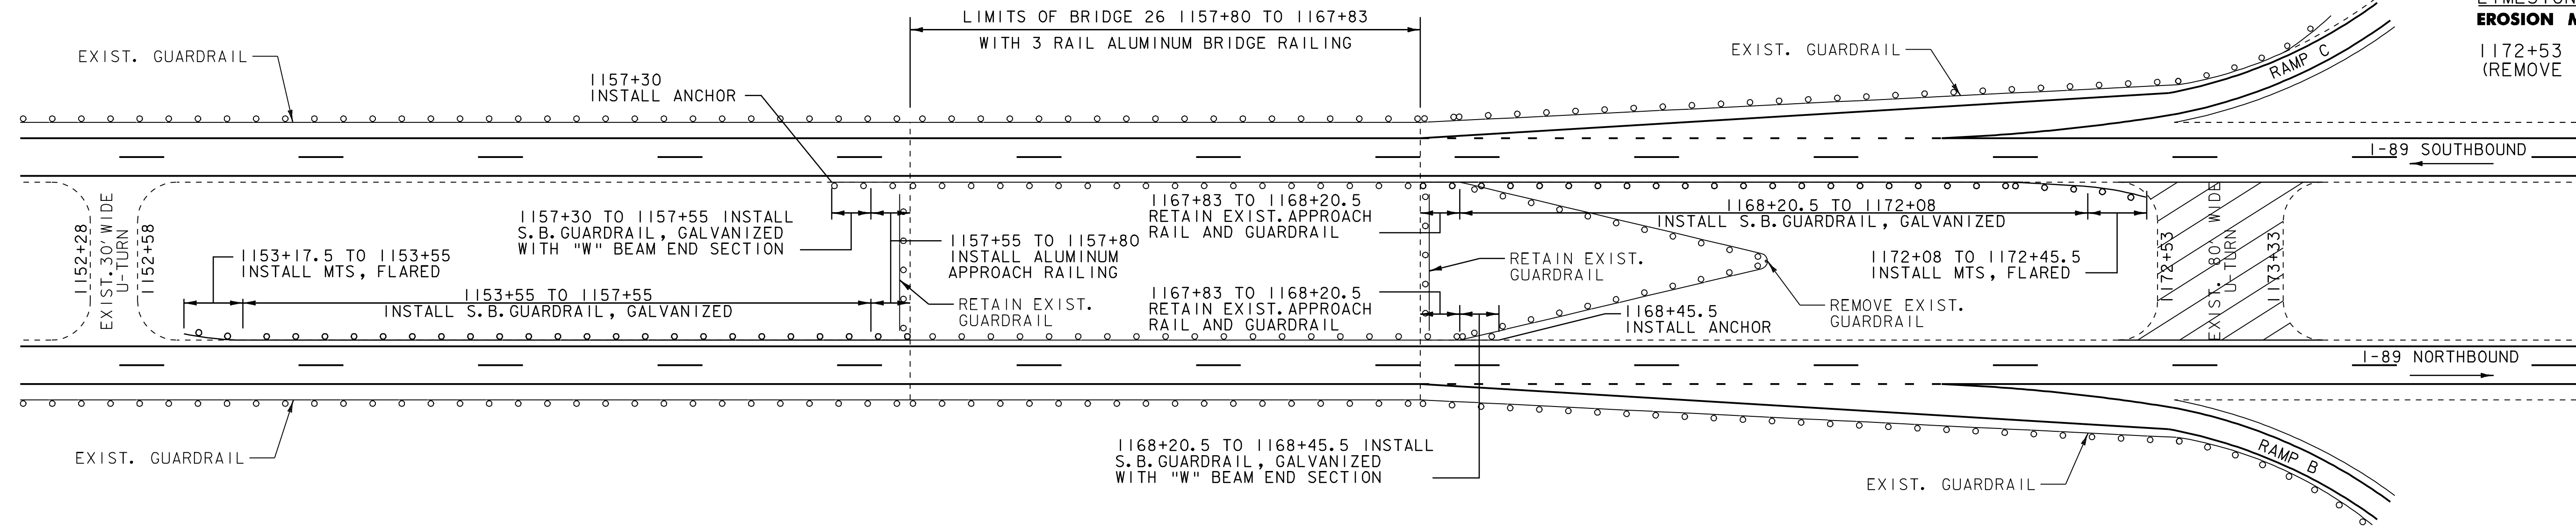

GUARDRAIL LOCATIONS - OVERPASS

BRIDGE 28 MM 24.348
TH 6 OVER INTERSTATE 89

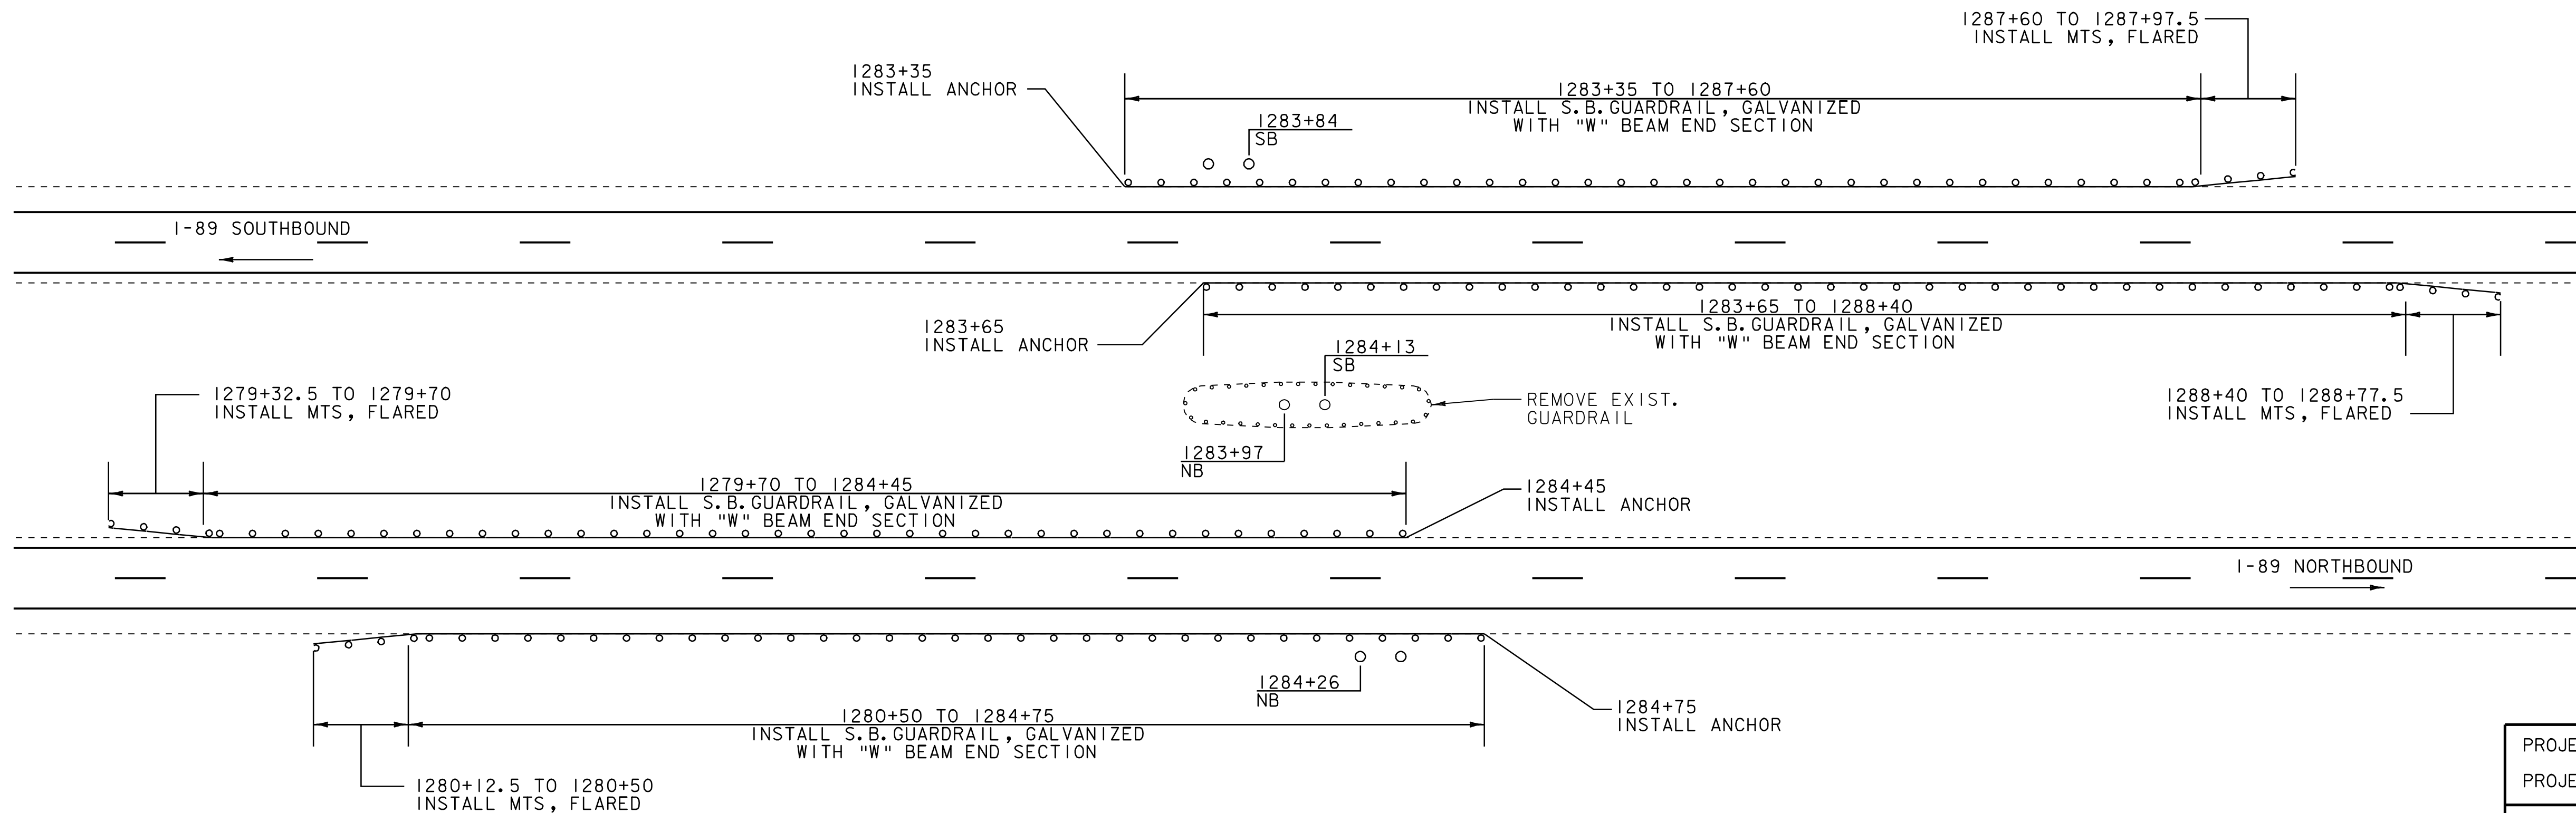

REMOVAL AND DISPOSAL OF GUARDRAIL
 NB 1281+28.0 TO 1284+76.0 RT
 NB 1283+65.0 TO 1284+55.0 LT
 SB 1279+41.0 TO 1285+84.0 LT
 SB 1283+65.0 TO 1284+55.0 RT

STEEL BEAM GUARDRAIL, GALVANIZED
 NB 1279+70.0 TO 1284+45.0 LT
 NB 1280+50.0 TO 1284+75.0 RT
 SB 1283+35.0 TO 1287+60.0 LT
 SB 1283+65.0 TO 1288+40.0 RT

MANUFACTURED TERMINAL SECTION, FLARED DELINEATOR WITH STEEL POST
 NB 1279+32.5 TO 1279+70.0 LT
 NB 1280+12.5 TO 1280+50.0 RT
 SB 1287+60.0 TO 1287+97.5 LT
 SB 1288+40.0 TO 1288+77.5 RT

ANCHOR FOR STEEL BEAM RAIL
 NB 1284+45 LT
 NB 1284+75 RT
 SB 1283+35 LT
 SB 1283+65 RT

BRIDGE/GUARDRAIL TREATMENT DETAILS

PROJECT NAME: ROYALTON-BETHEL	
PROJECT NUMBER: IM 089-1(54)	
FILE NAME: p06a198.dgn	PLOT DATE: 28-JUN-2010 15:22
PROJECT LEADER: PTS	DRAWN BY: MRS
DESIGNED BY: NLL	CHECKED BY: PTS
IPARM FILE NAME: p06a198bg+td.l	SHEET 31 OF 37

NOT TO SCALE

REVISED 02-17-09