



NOTE - PLACED DOTTED LINES ACROSS ALL RAMP
 (ON AND OFF) AS PER
 MUTCD 3A.06
 (3 FOOT LINE SEGMENTS AND 9 FOOT GAPS)

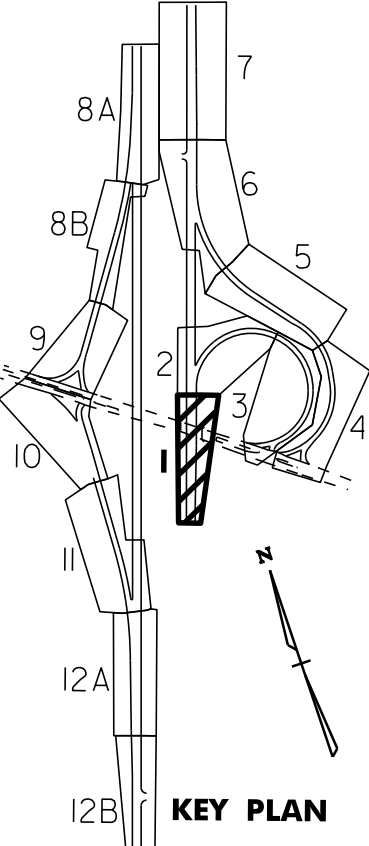

NOTES: 1. FOR STRIPING DETAILS AT GORES,
 SEE THE PAVEMENT MARKINGS
 DETAIL SHEET AND THE LATEST
 EDITION OF THE MUTCD.

2. DIRECTION OF TRAVEL ARROW ⇒

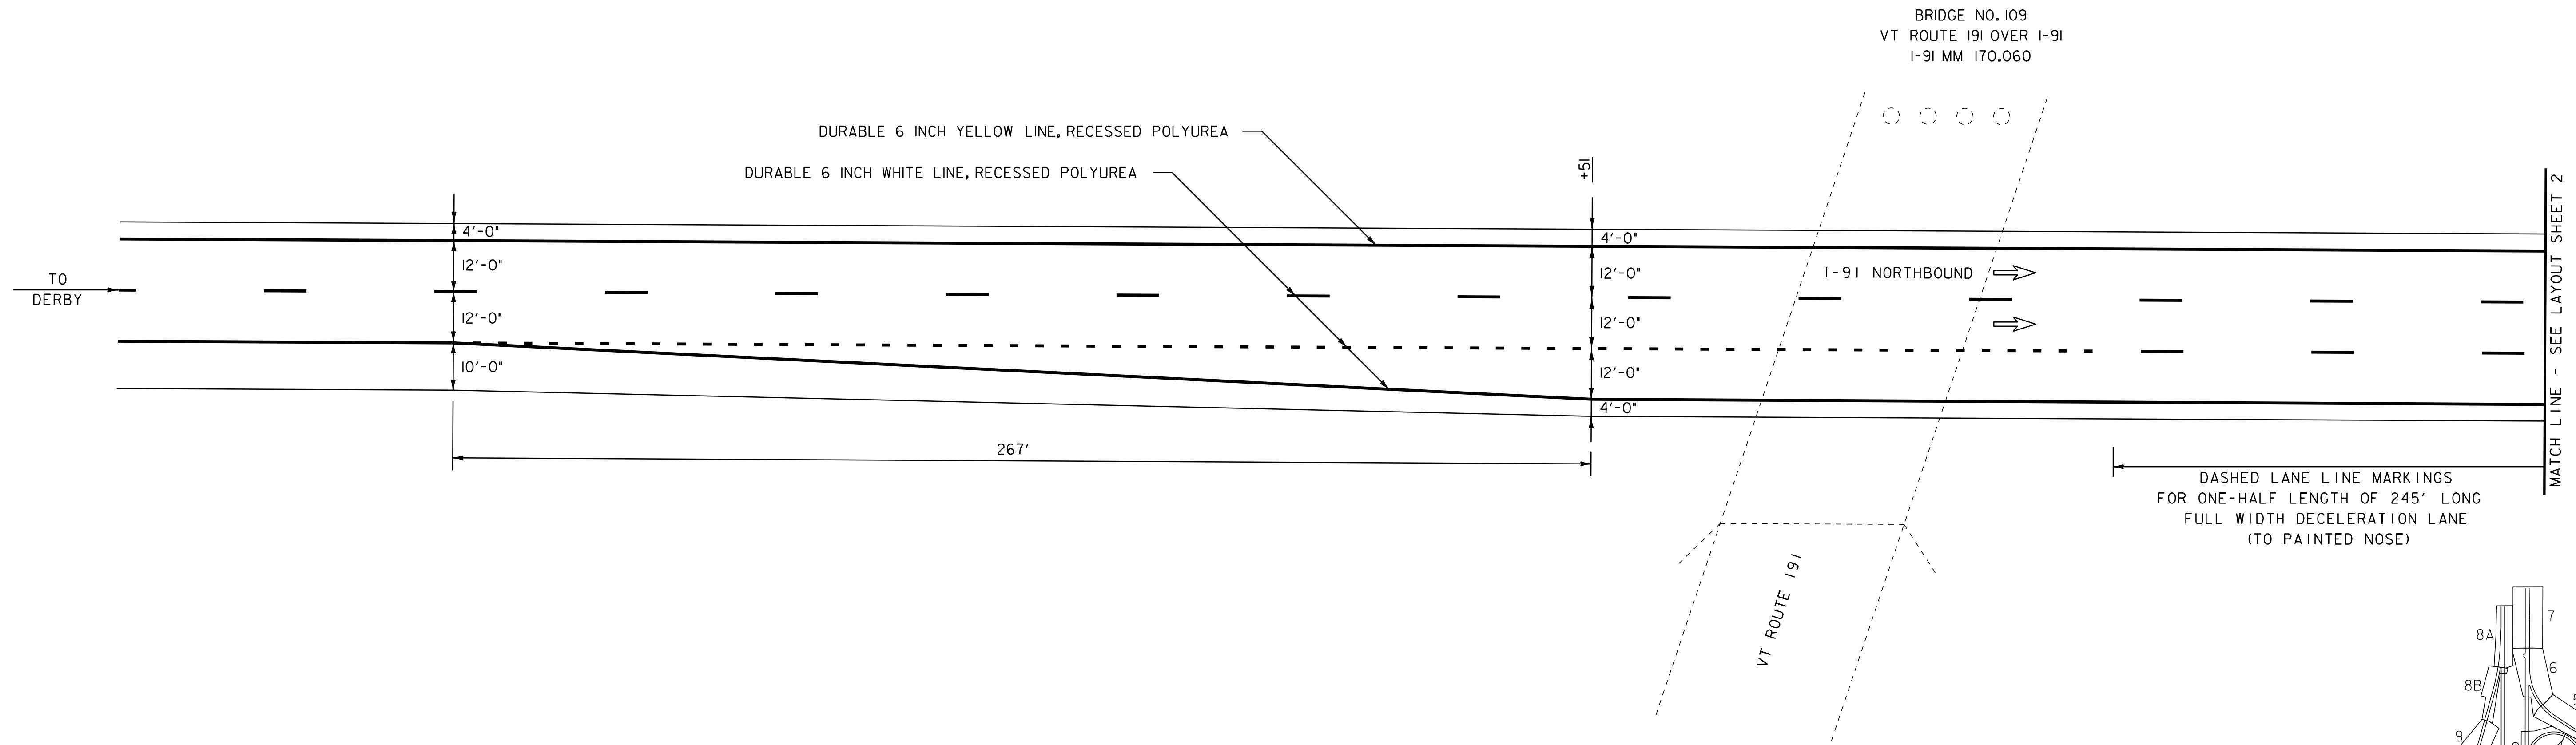

**INTERCHANGE
 27 LAYOUT
 SHEET #1**

NOT TO SCALE

PROJECT NAME: DERBY
 PROJECT NUMBER: IM 091-3(46)

FILE NAME: p06a200.dgn
 PROJECT LEADER: JLL
 DESIGNED BY: STANTEC
 IPARM FILE: p06a200i01

PLOT DATE: 07-SEP-2011 10:23
 DRAWN BY: STANTEC
 CHECKED BY: JLL
 SHEET 21 OF 63