

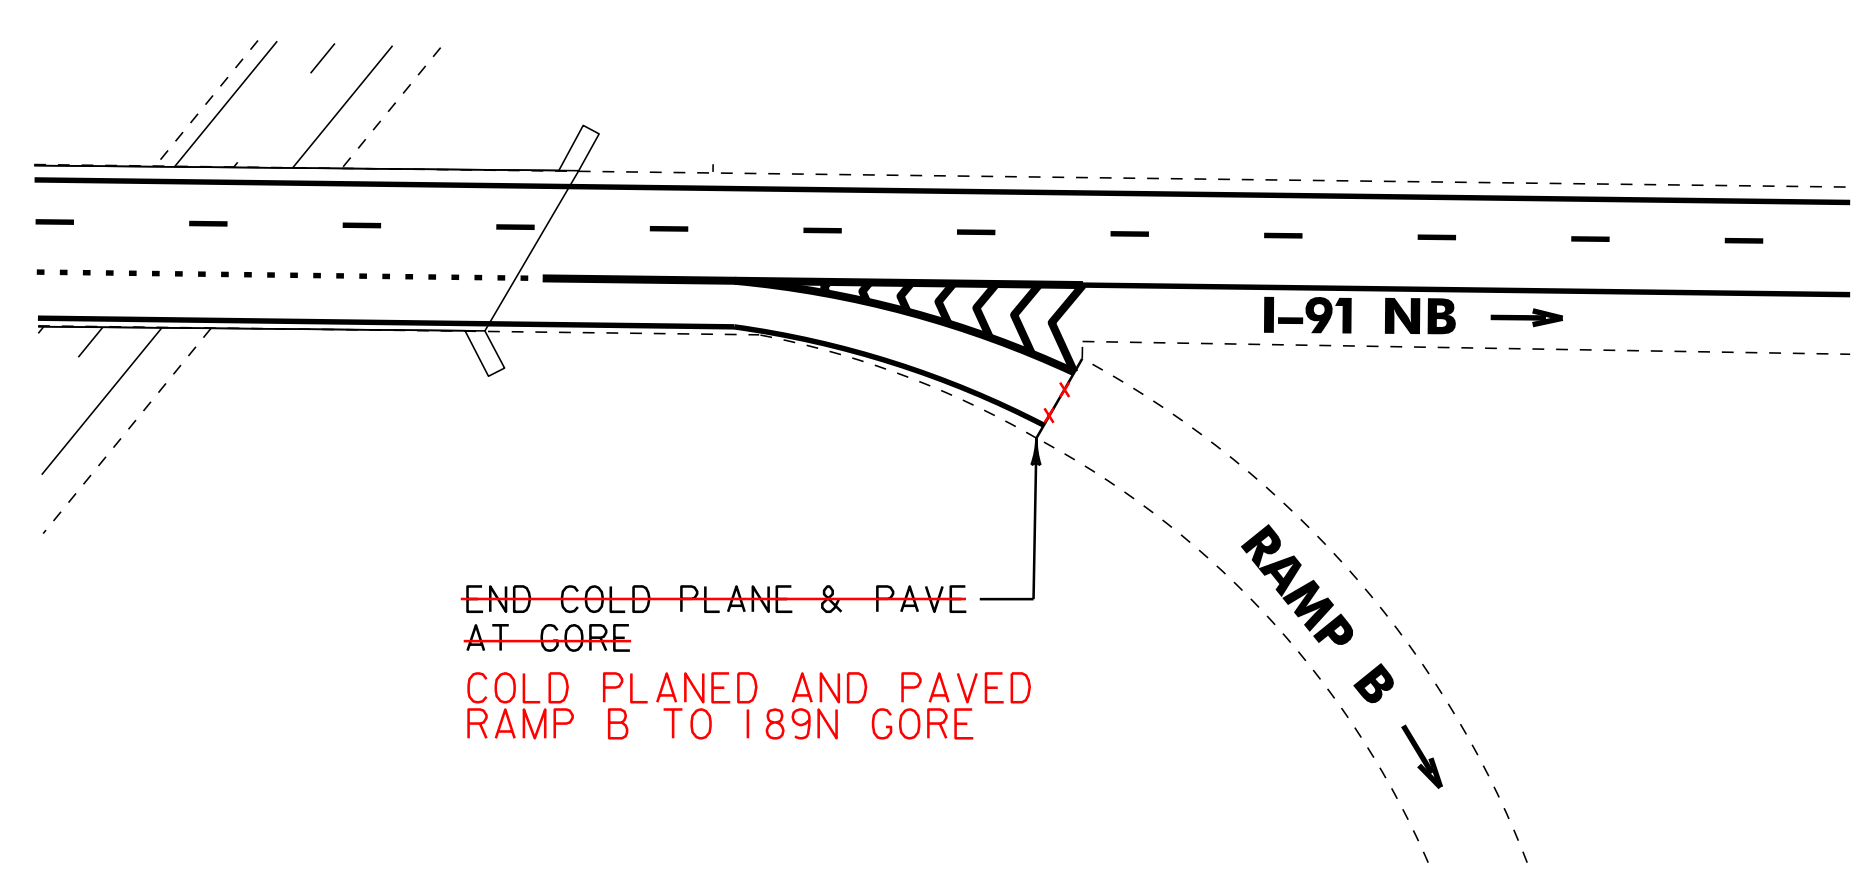



**EXIT 10 - RAMP A
I-89 NORTHBOUND OFF RAMP**

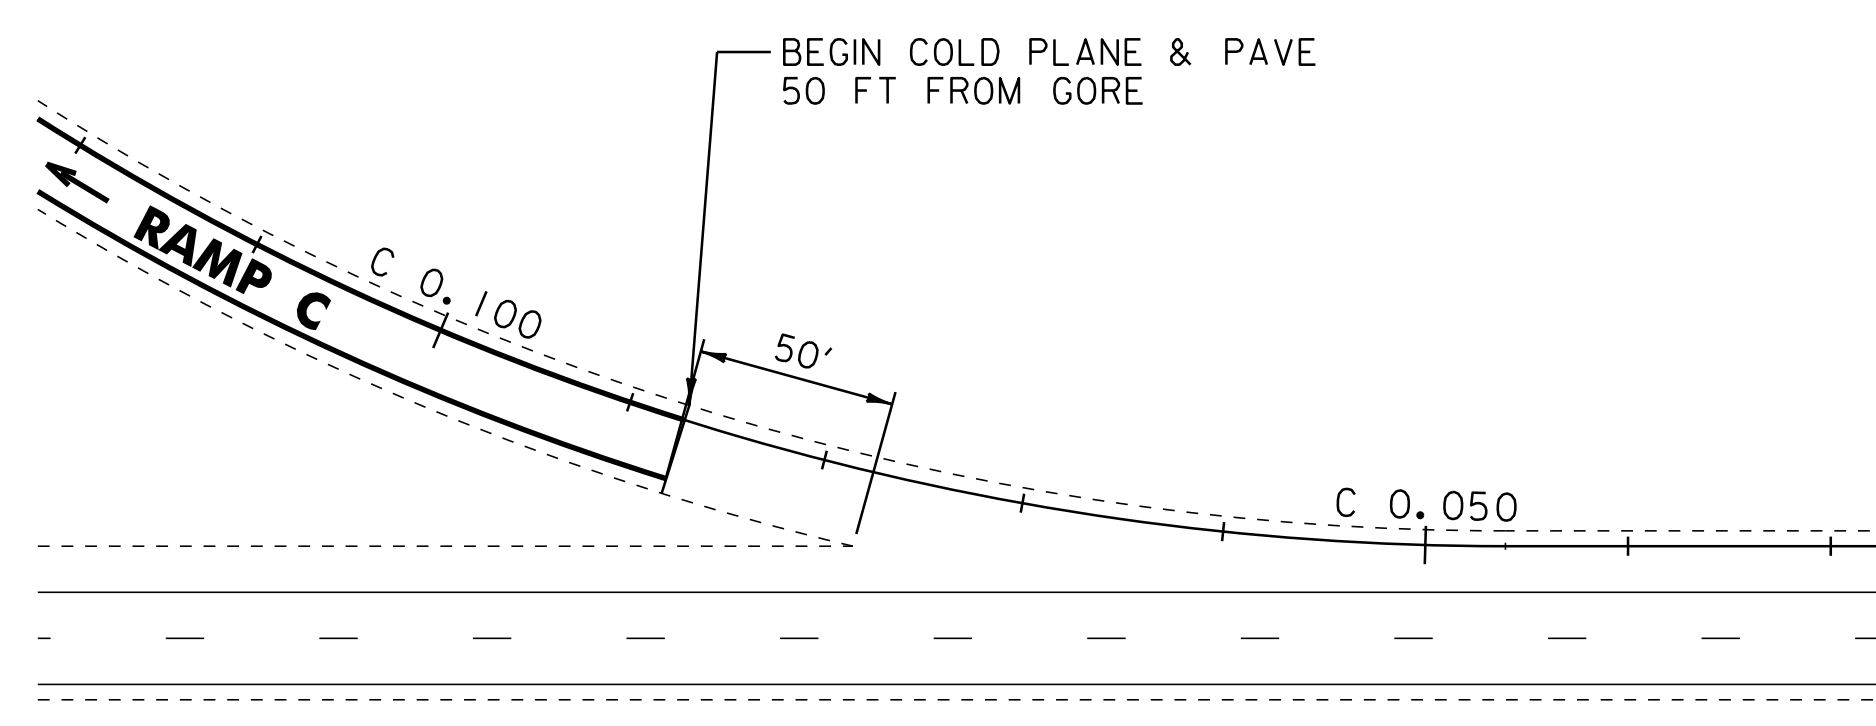


**EXIT 10 - RAMP B
I-91 NORTHBOUND OFF RAMP**

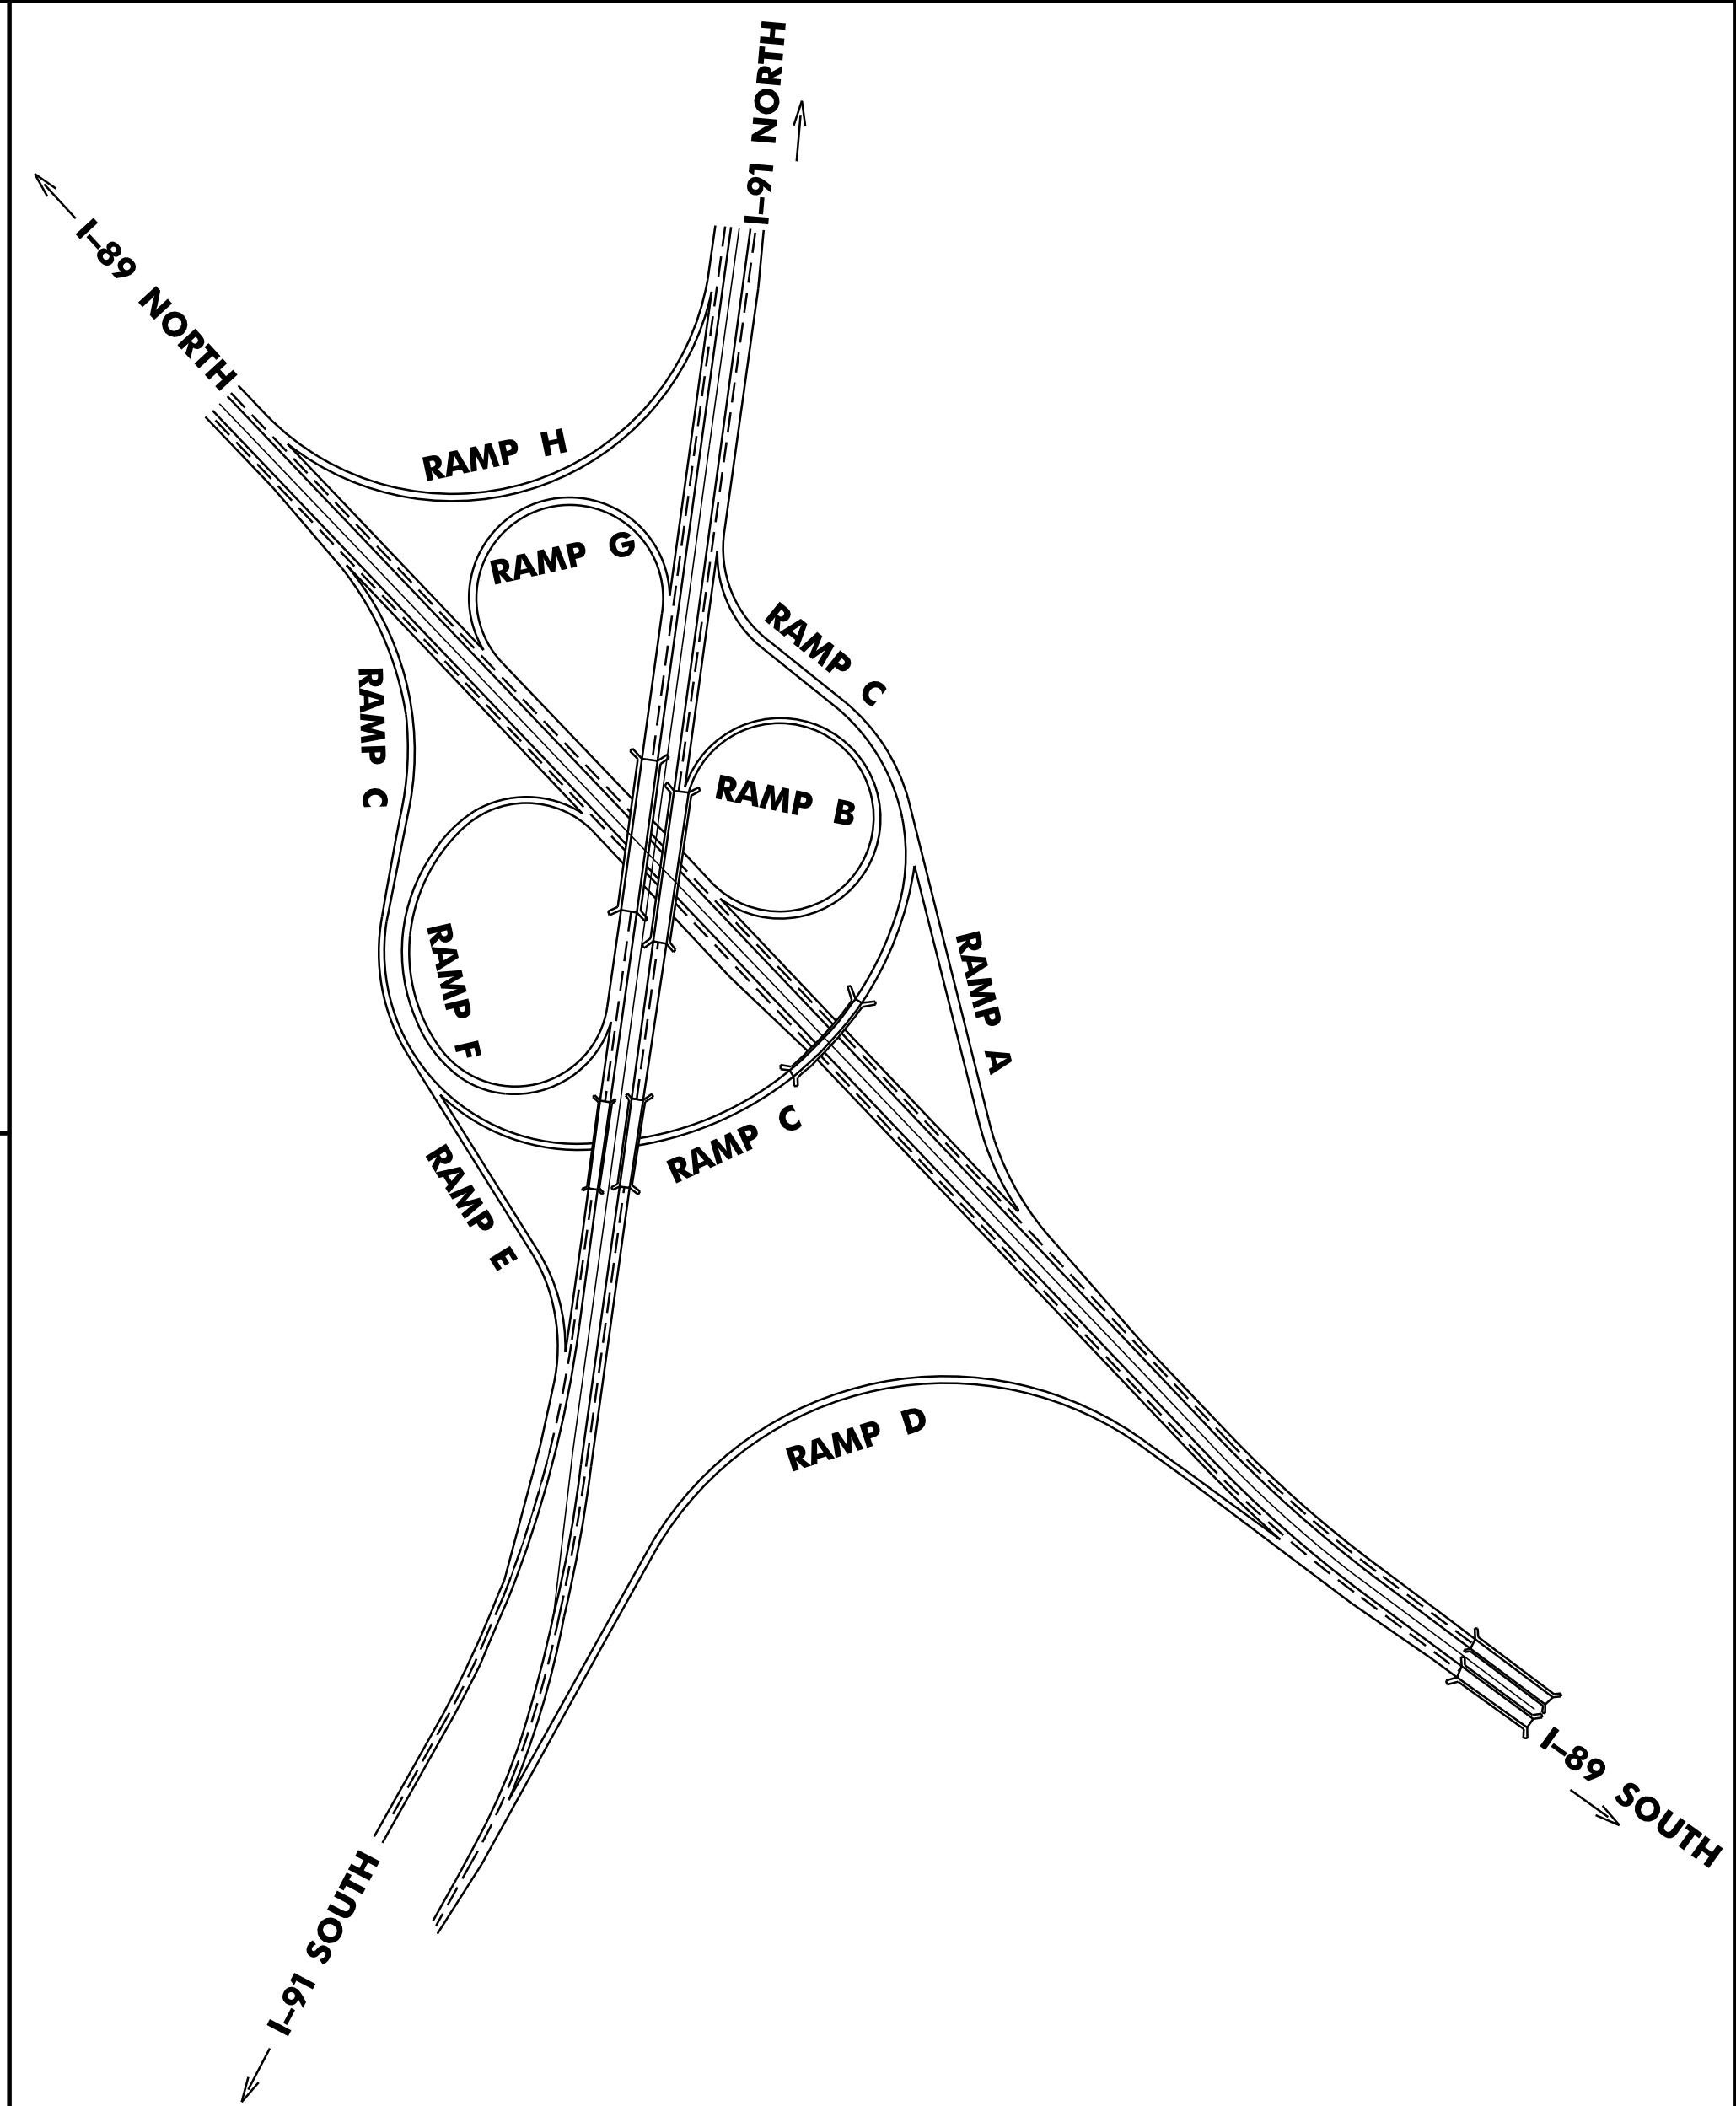


**EXIT 10 - RAMP C
I-89 SOUTHBOUND OFF RAMP**

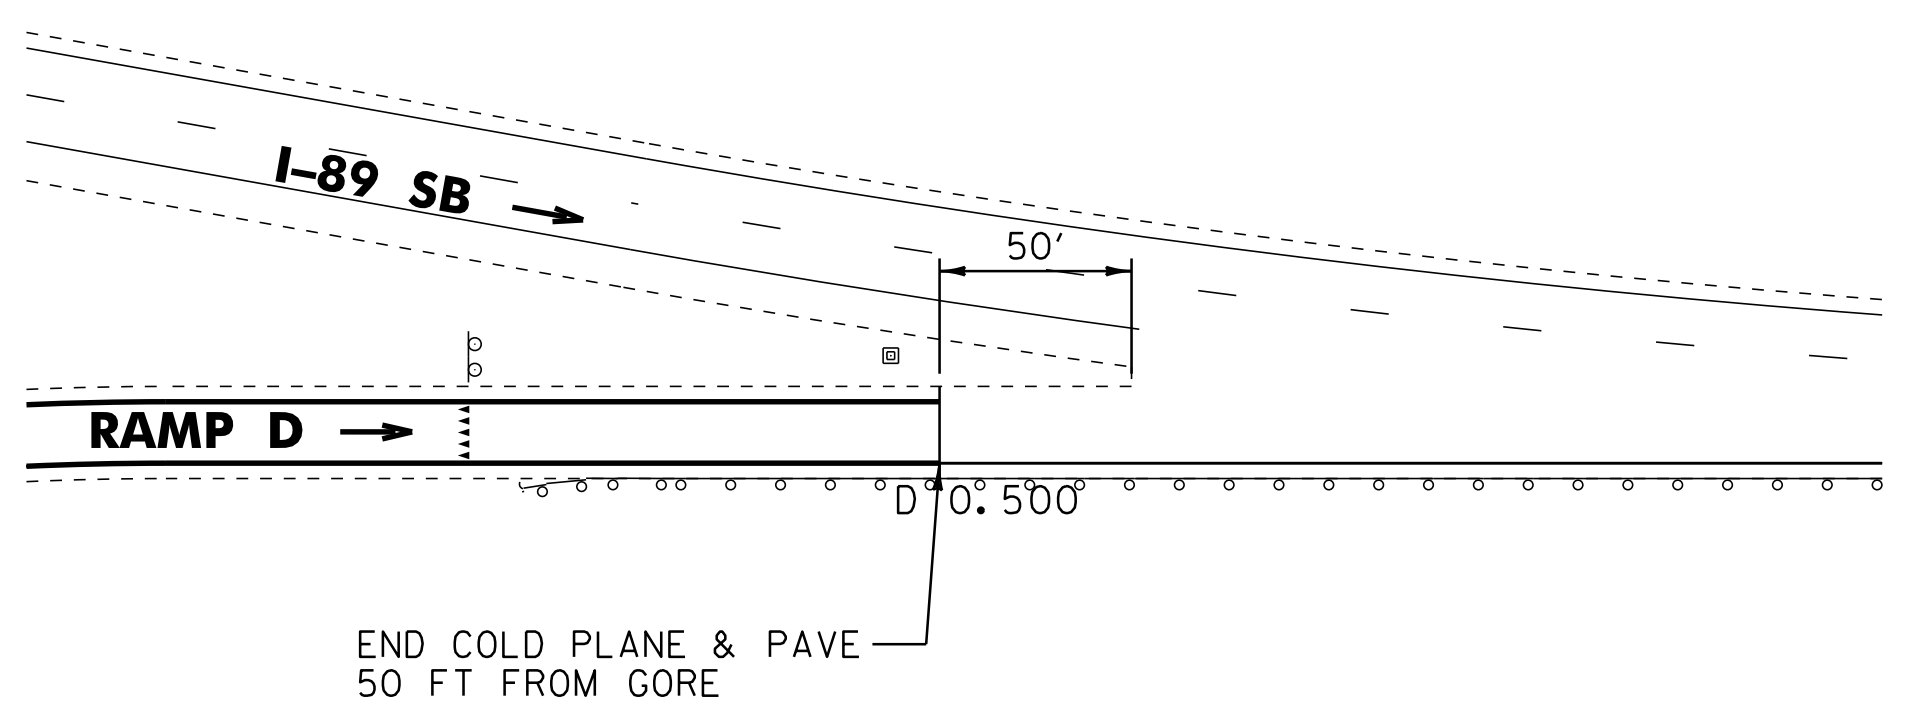


**EXIT 10 - RAMP D
I-89 SOUTHBOUND ON RAMP**

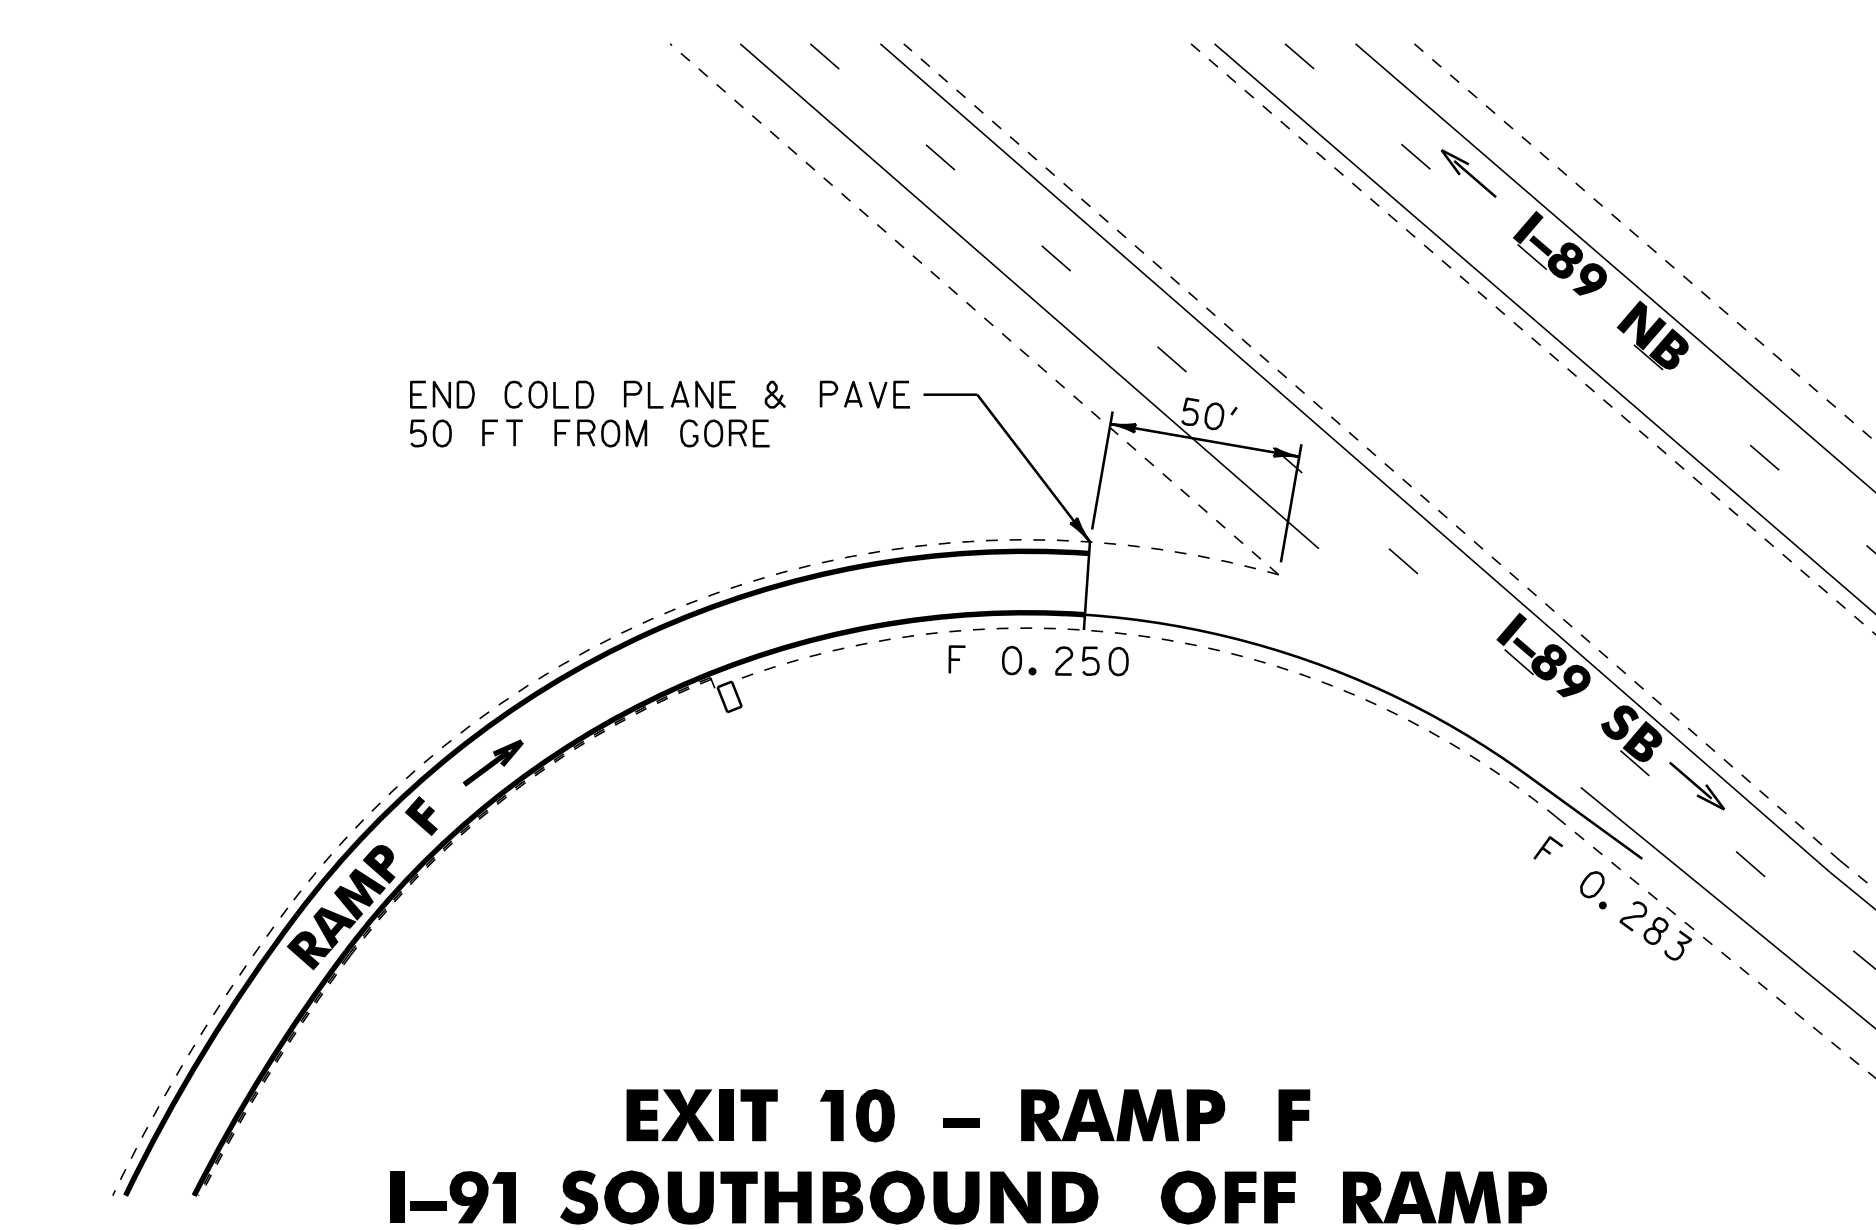

**EXIT 10 - RAMP F
I-91 SOUTHBOUND OFF RAMP**

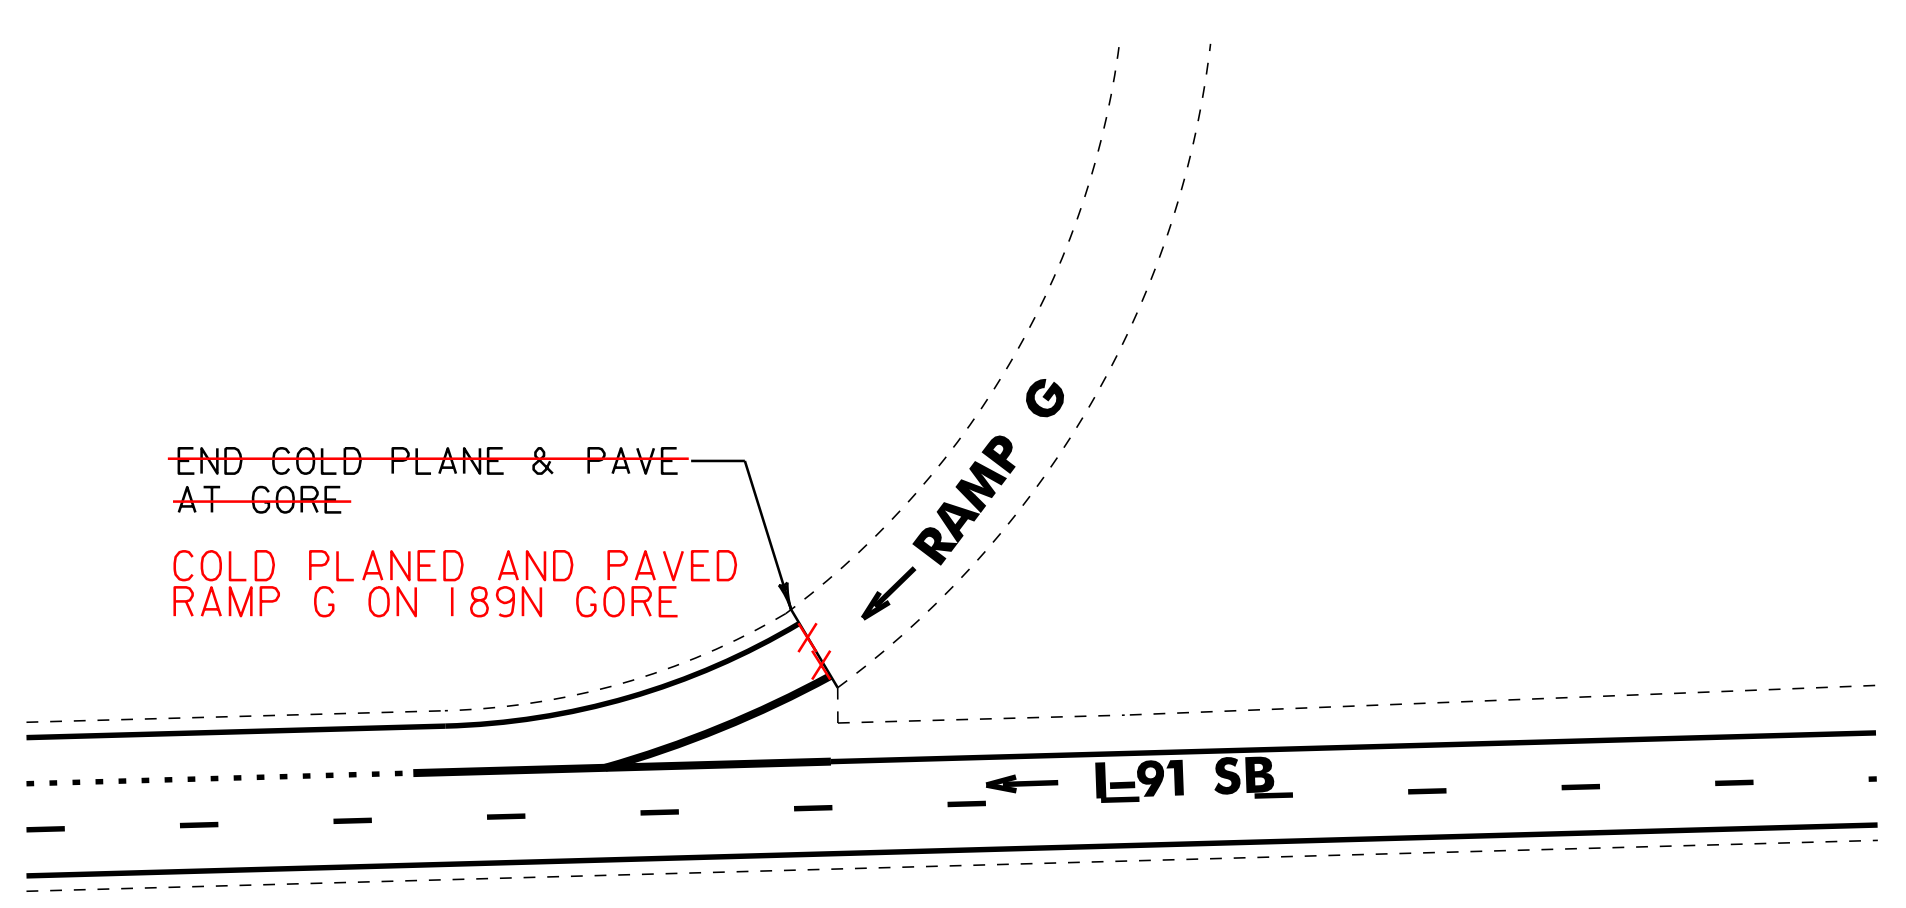

**EXIT 10 - RAMP G
I-91 SOUTHBOUND ON RAMP**

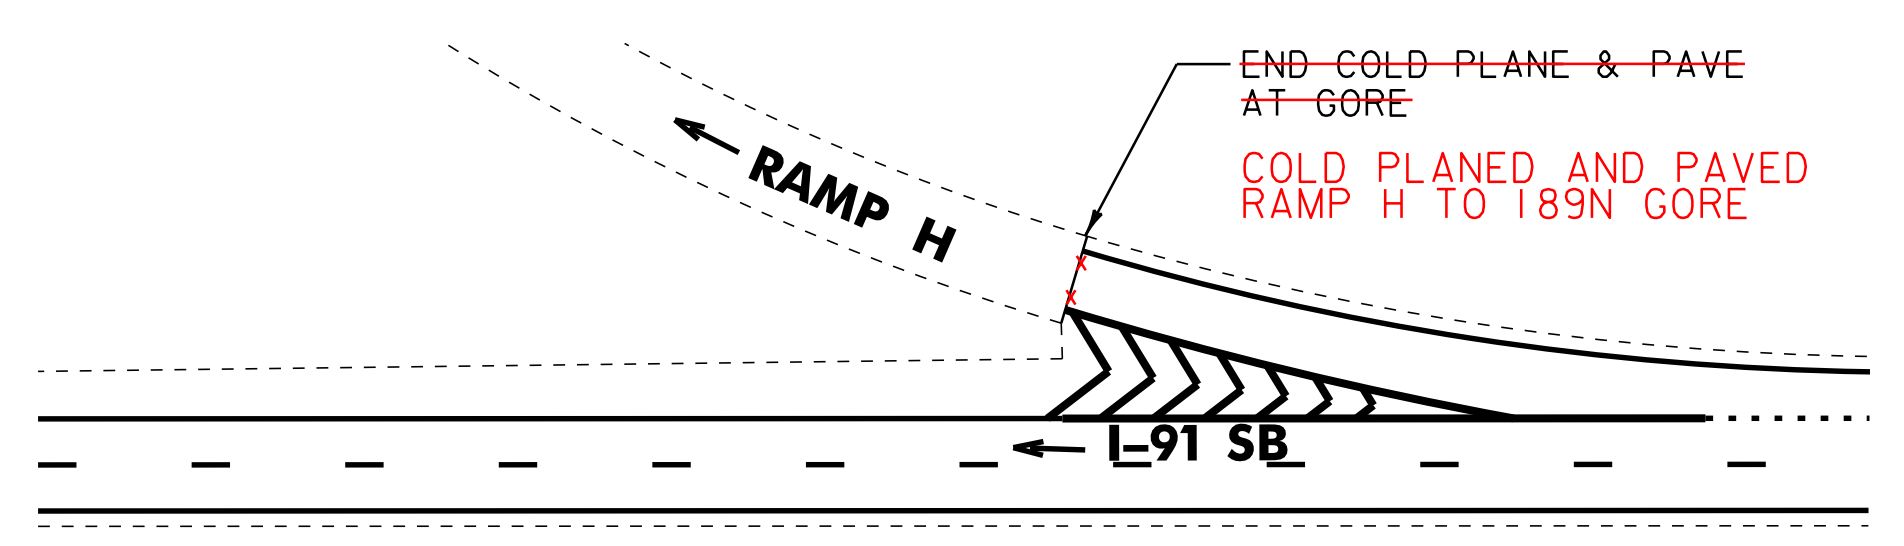

**EXIT 10 - RAMP H
I-91 SOUTHBOUND OFF RAMP
EXIT 10 TIE SHEET**

PROJECT NAME:	HARTLAND-NORWICH	
PROJECT NUMBER:	IM 091-I(59)	
FILE NAME:	/pave/06a202/p06a202.dgn	PLOT DATE: 21-NOV-2012 11:44
PROJECT LEADER:	PTS	DRAWN BY: MWS
DESIGNED BY:	NLL	CHECKED BY: PTS
IPARM FILE NAME:	06A202_05	SHEET 5 OF 60

NOT TO SCALE