




**EXIT 11 - RAMP A
SOUTHBOUND ON RAMP**

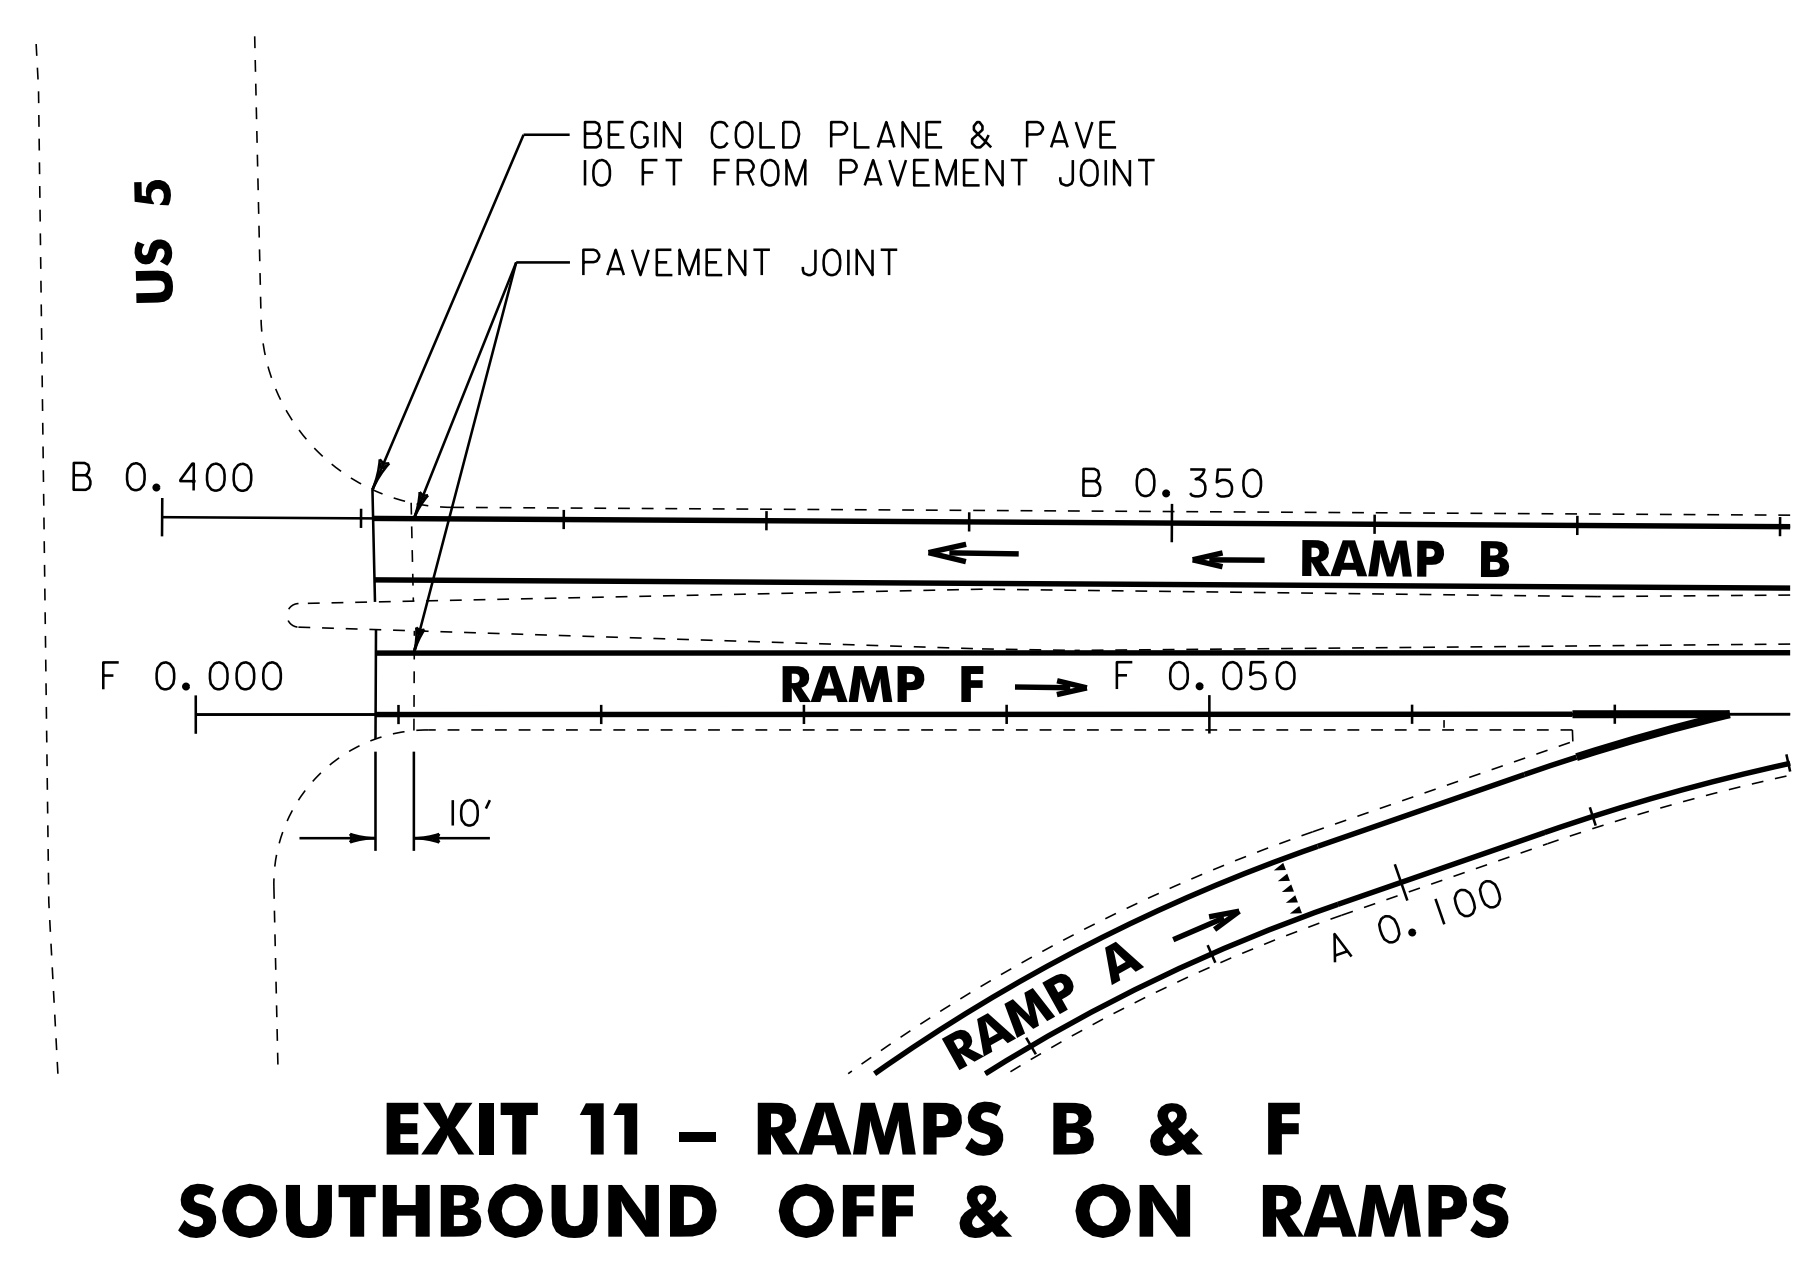


**EXIT 11 - RAMPS B & F
SOUTHBOUND OFF & ON RAMPS**

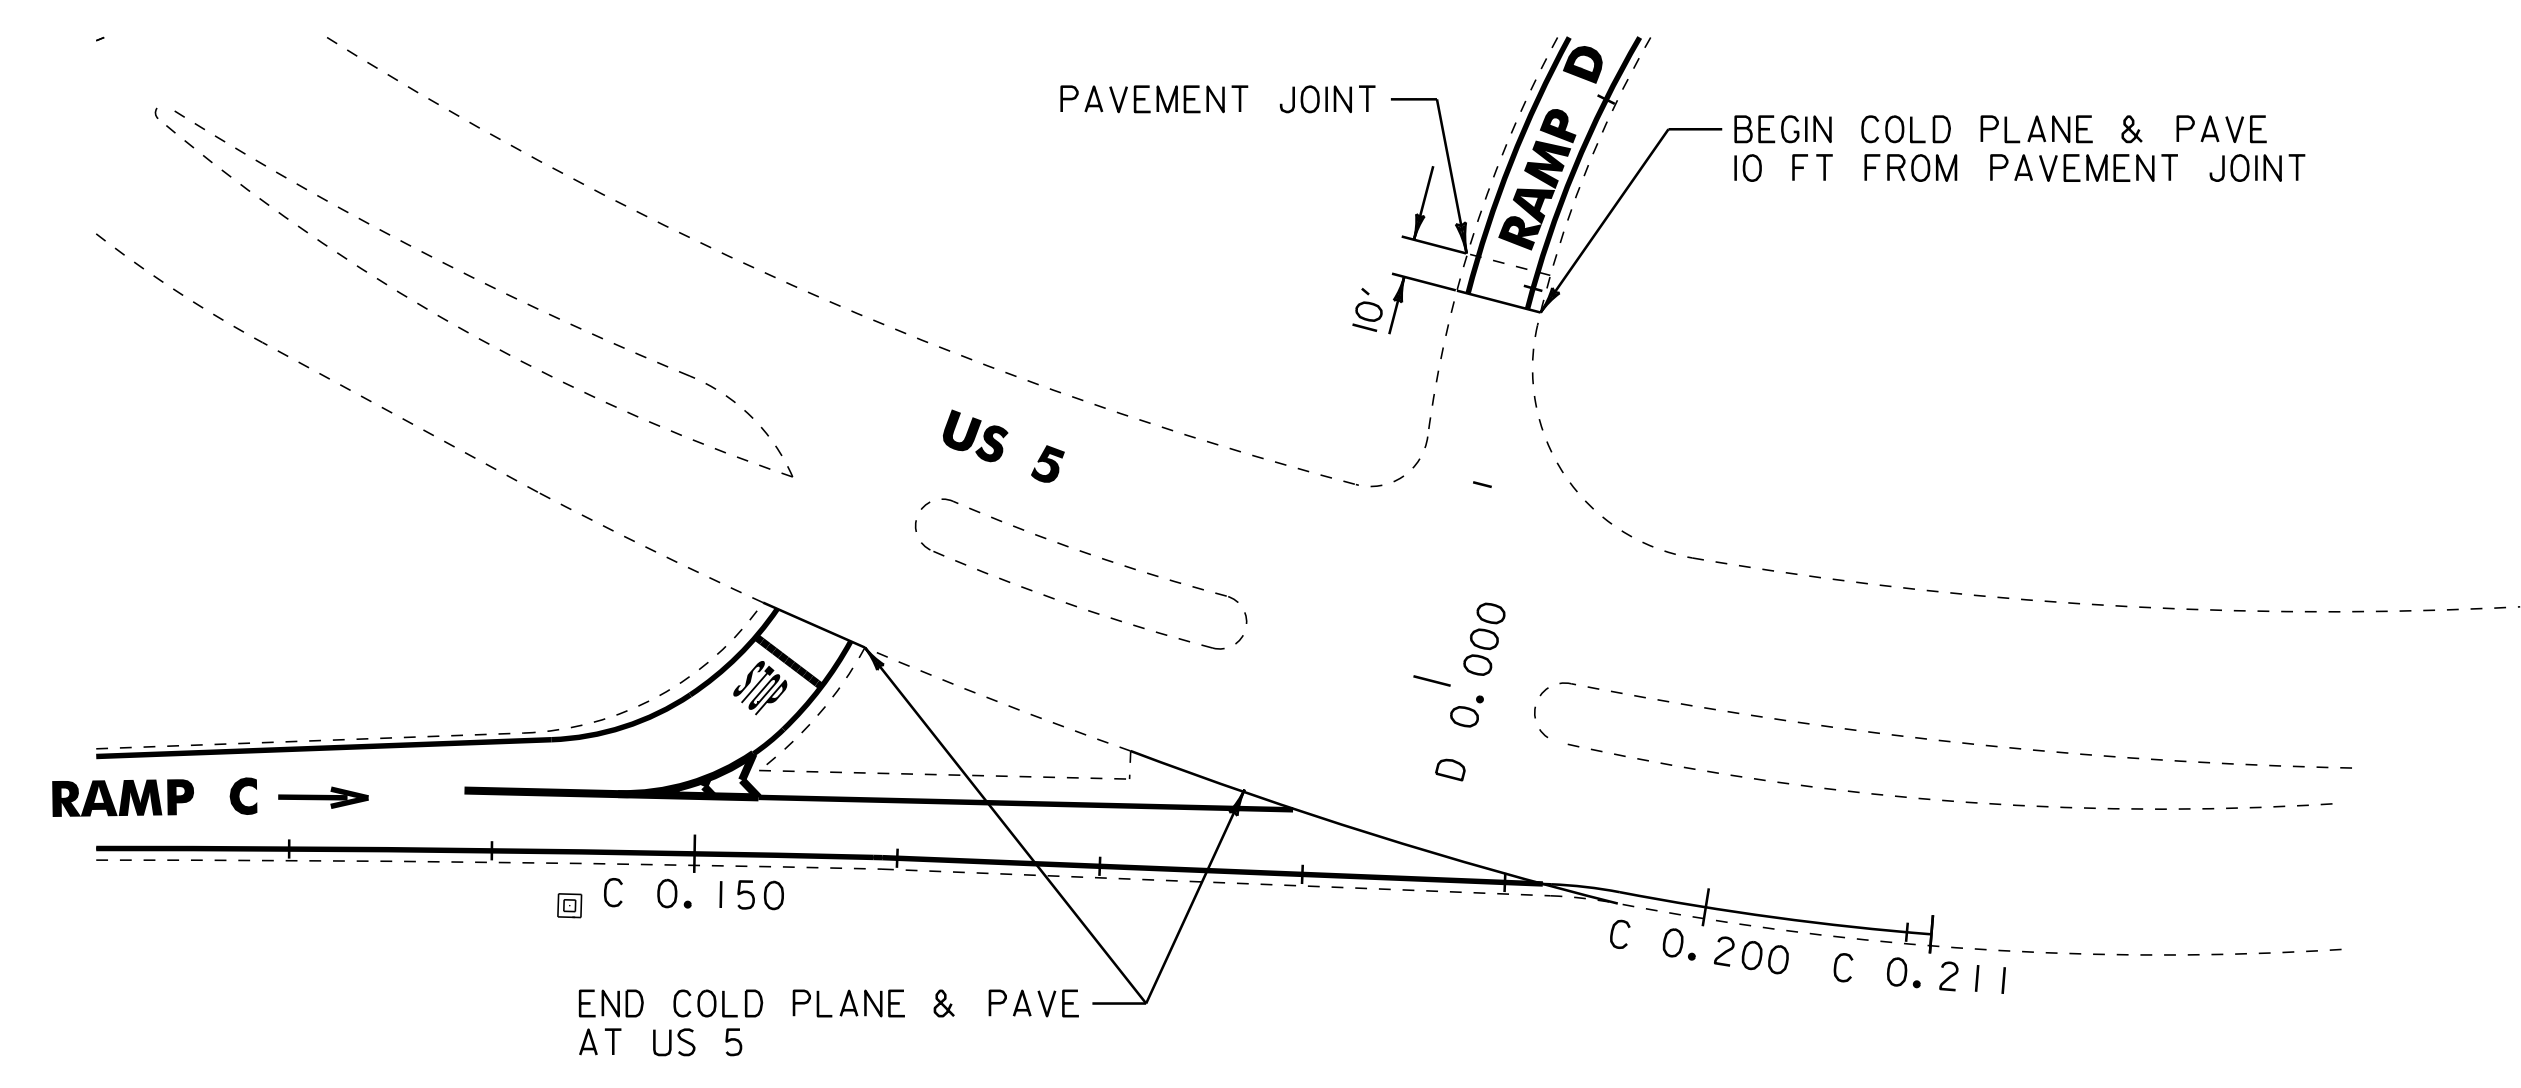


**EXIT 11 - RAMPS C & D
NORTHBOUND OFF & ON RAMPS**

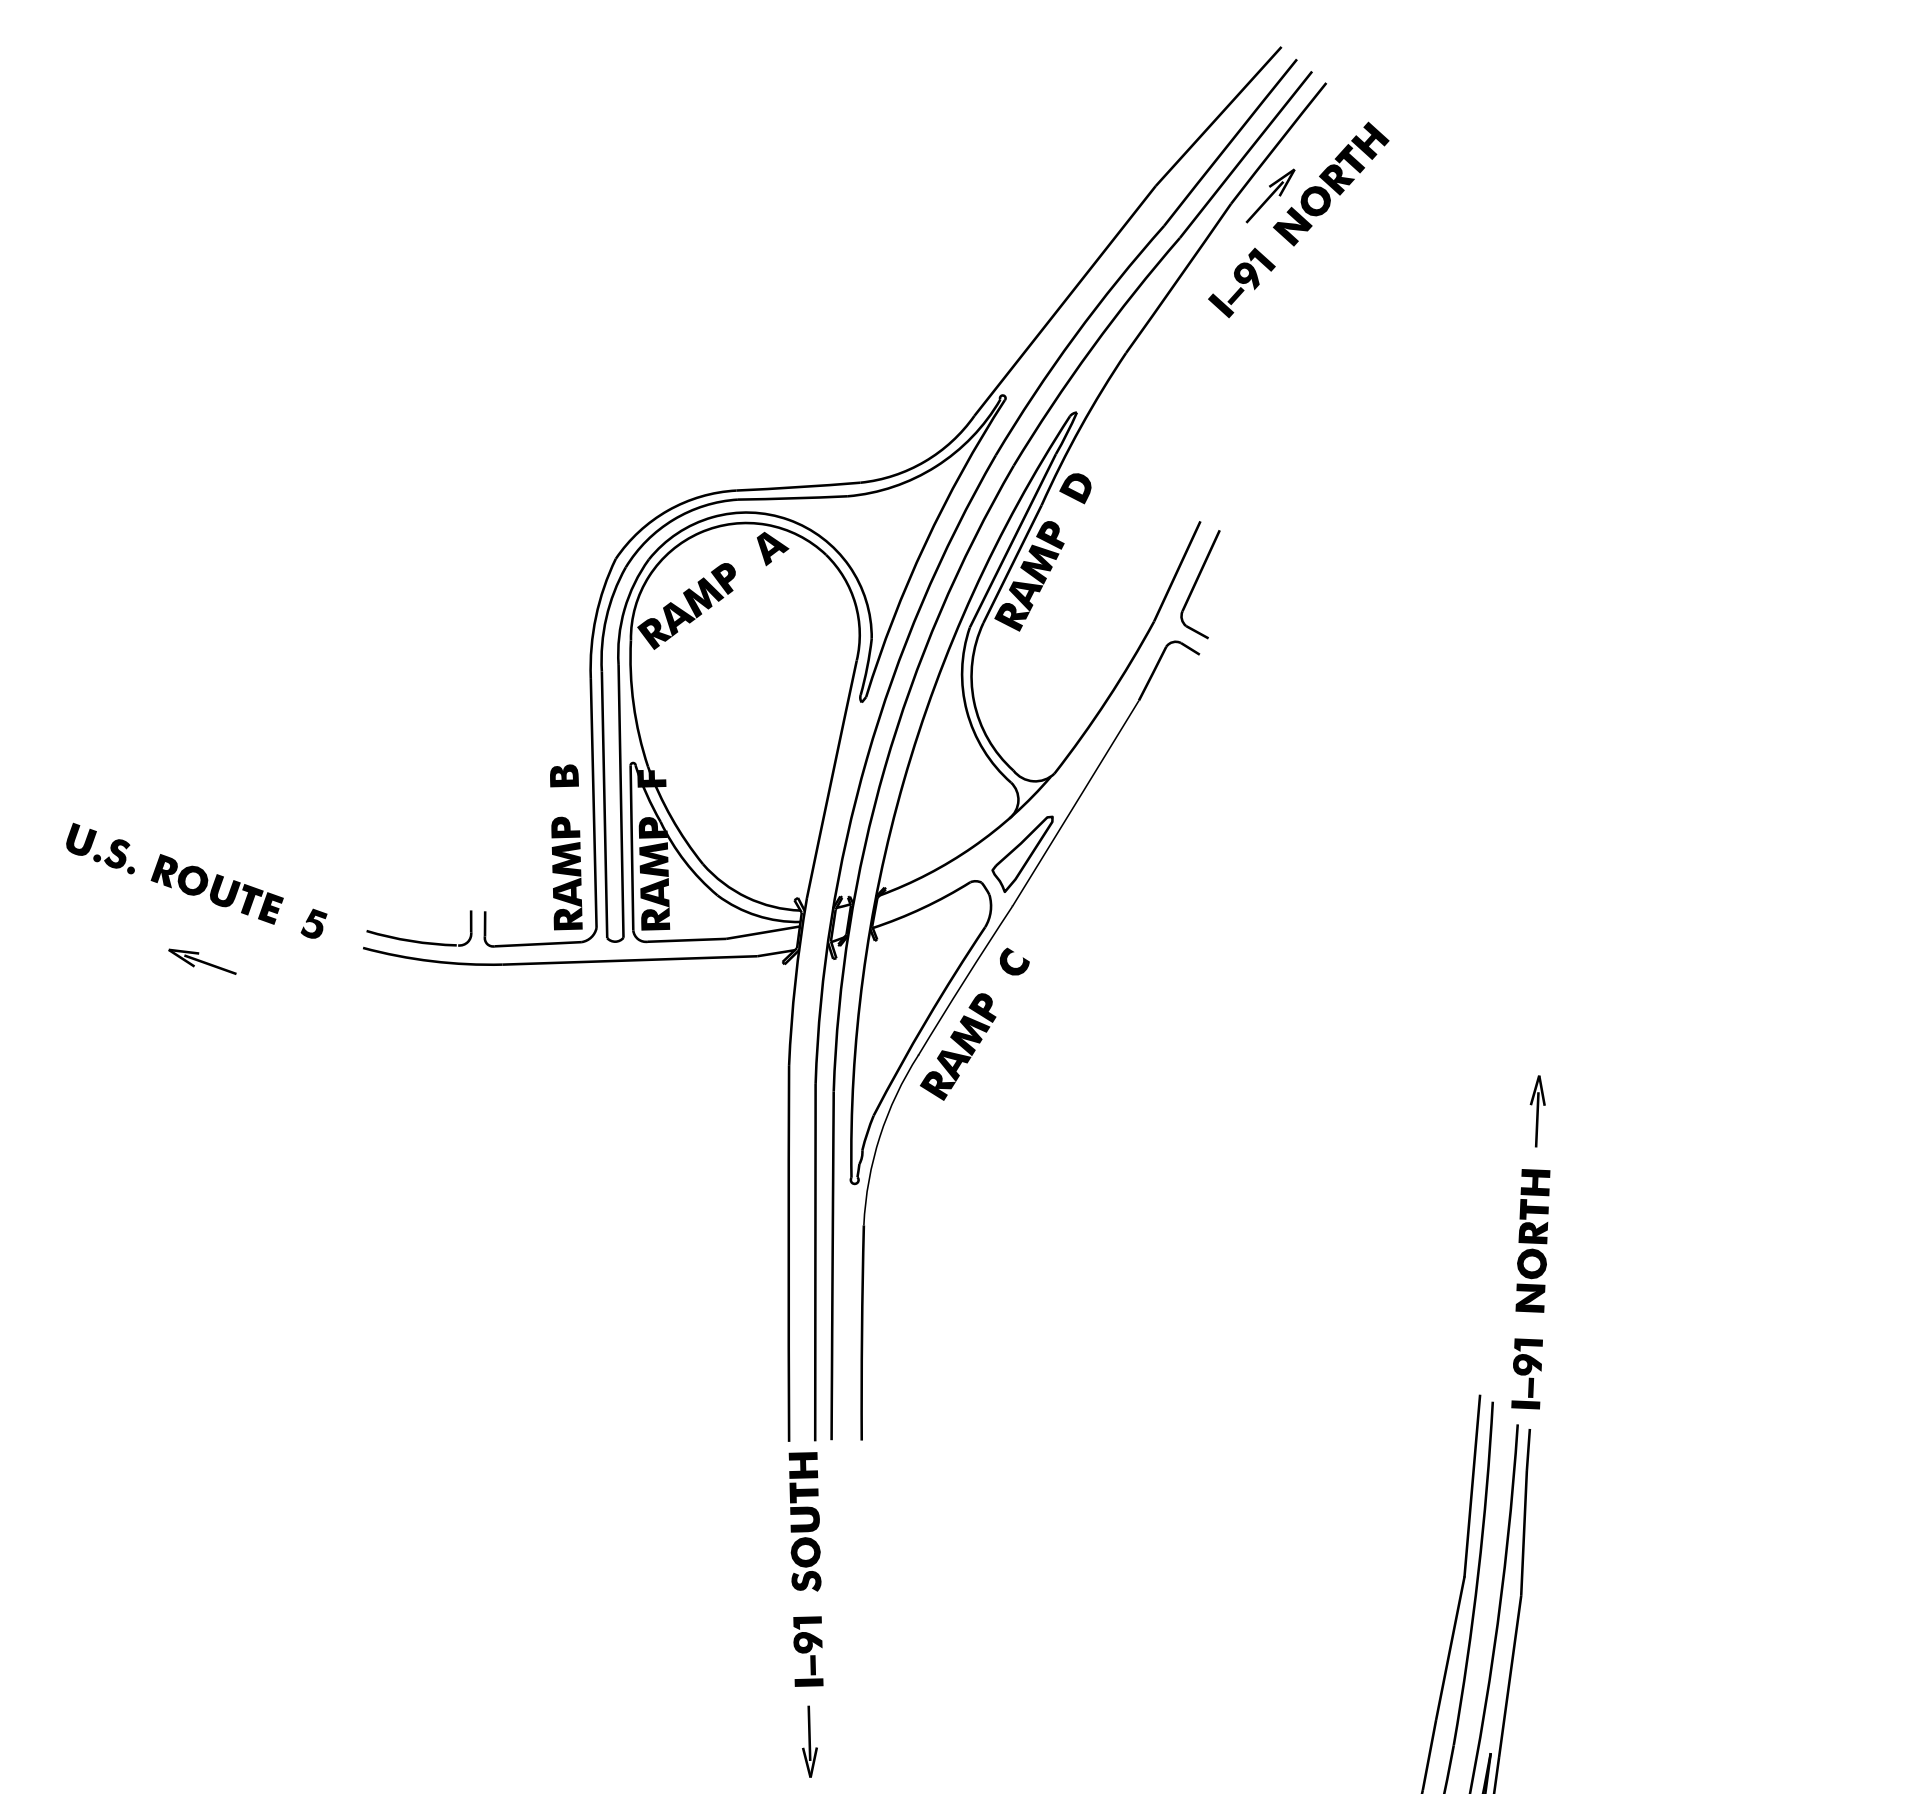


EXIT 11 LAYOUT

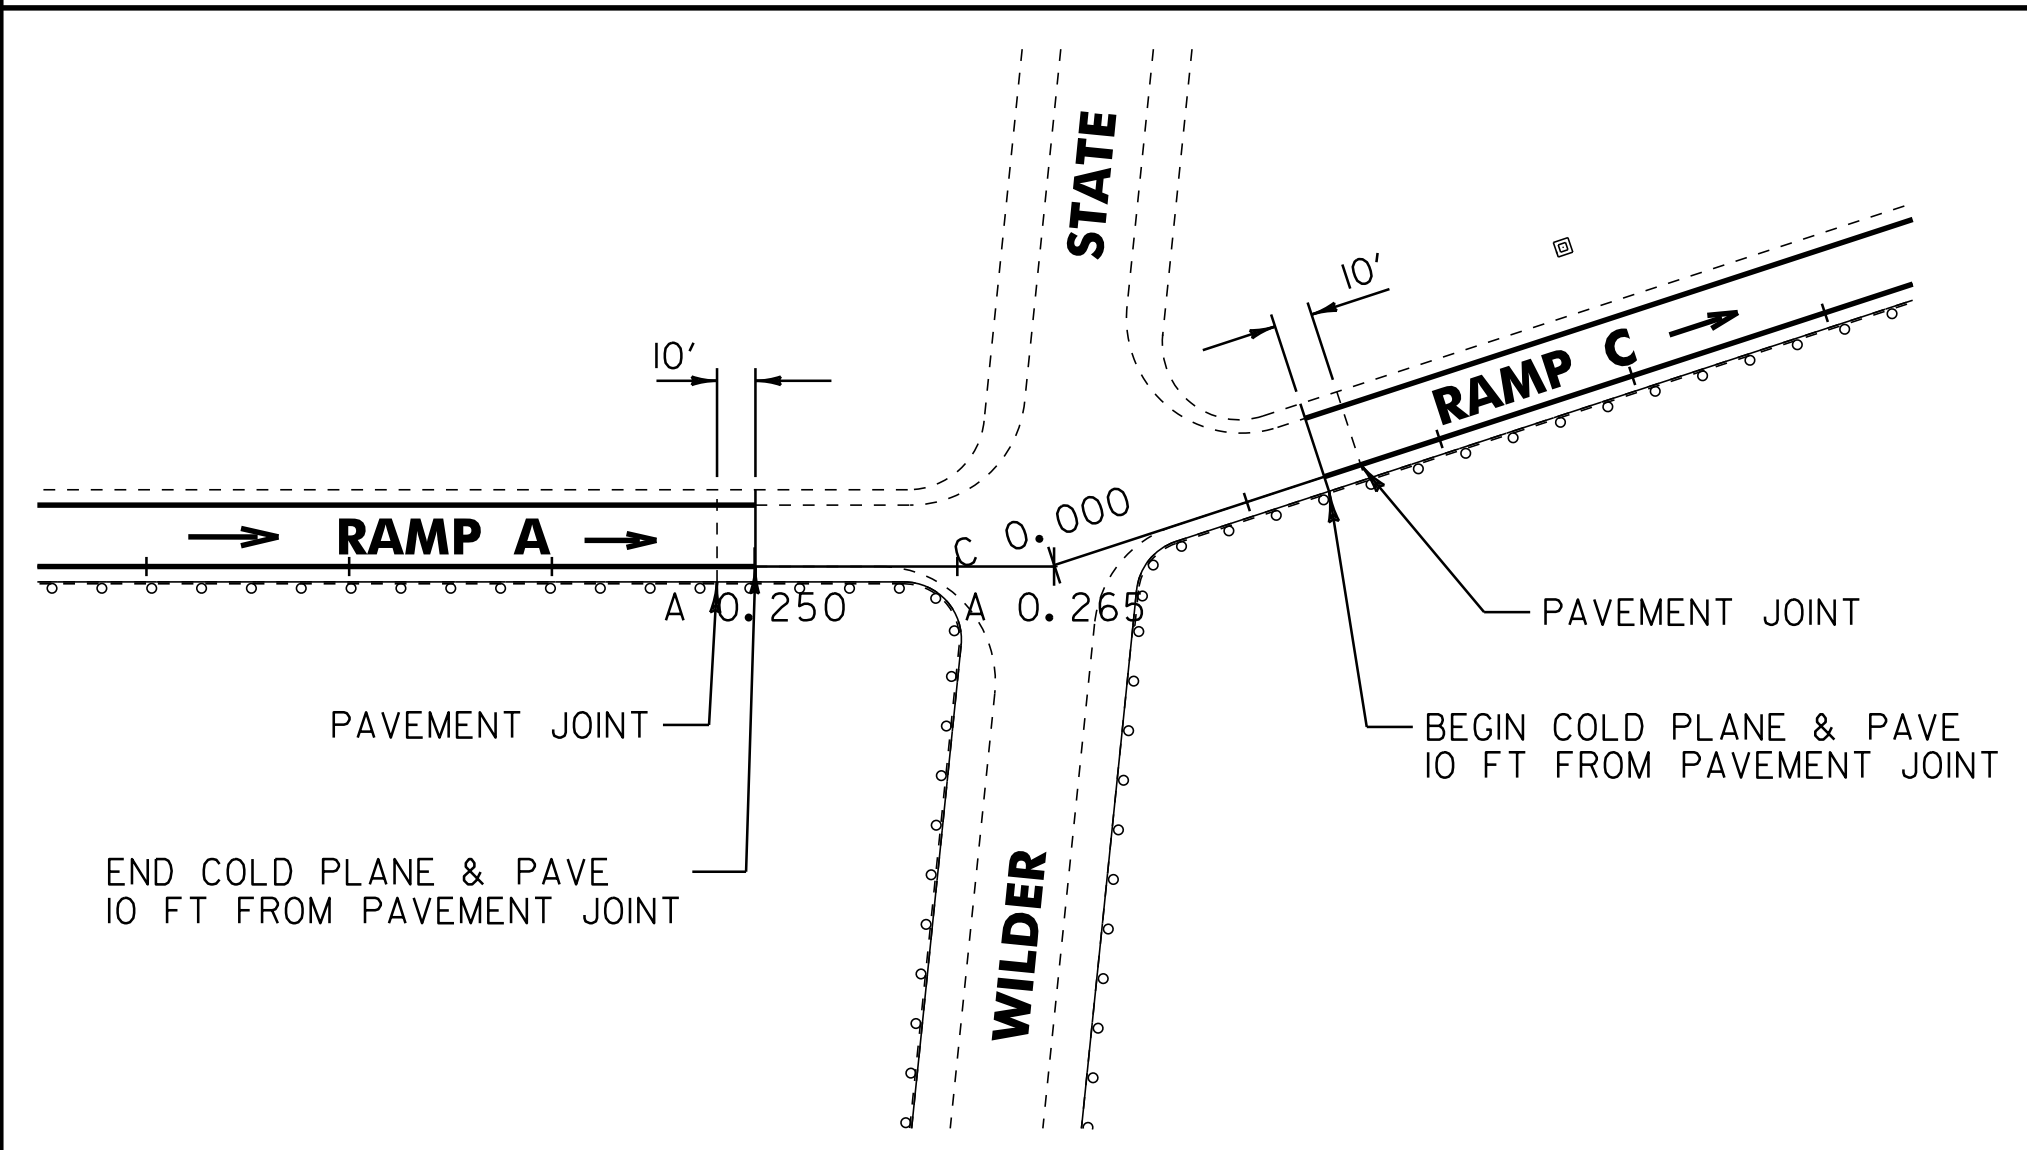

**EXIT 12 - RAMPS A & C
NORTHBOUND OFF & ON RAMPS**

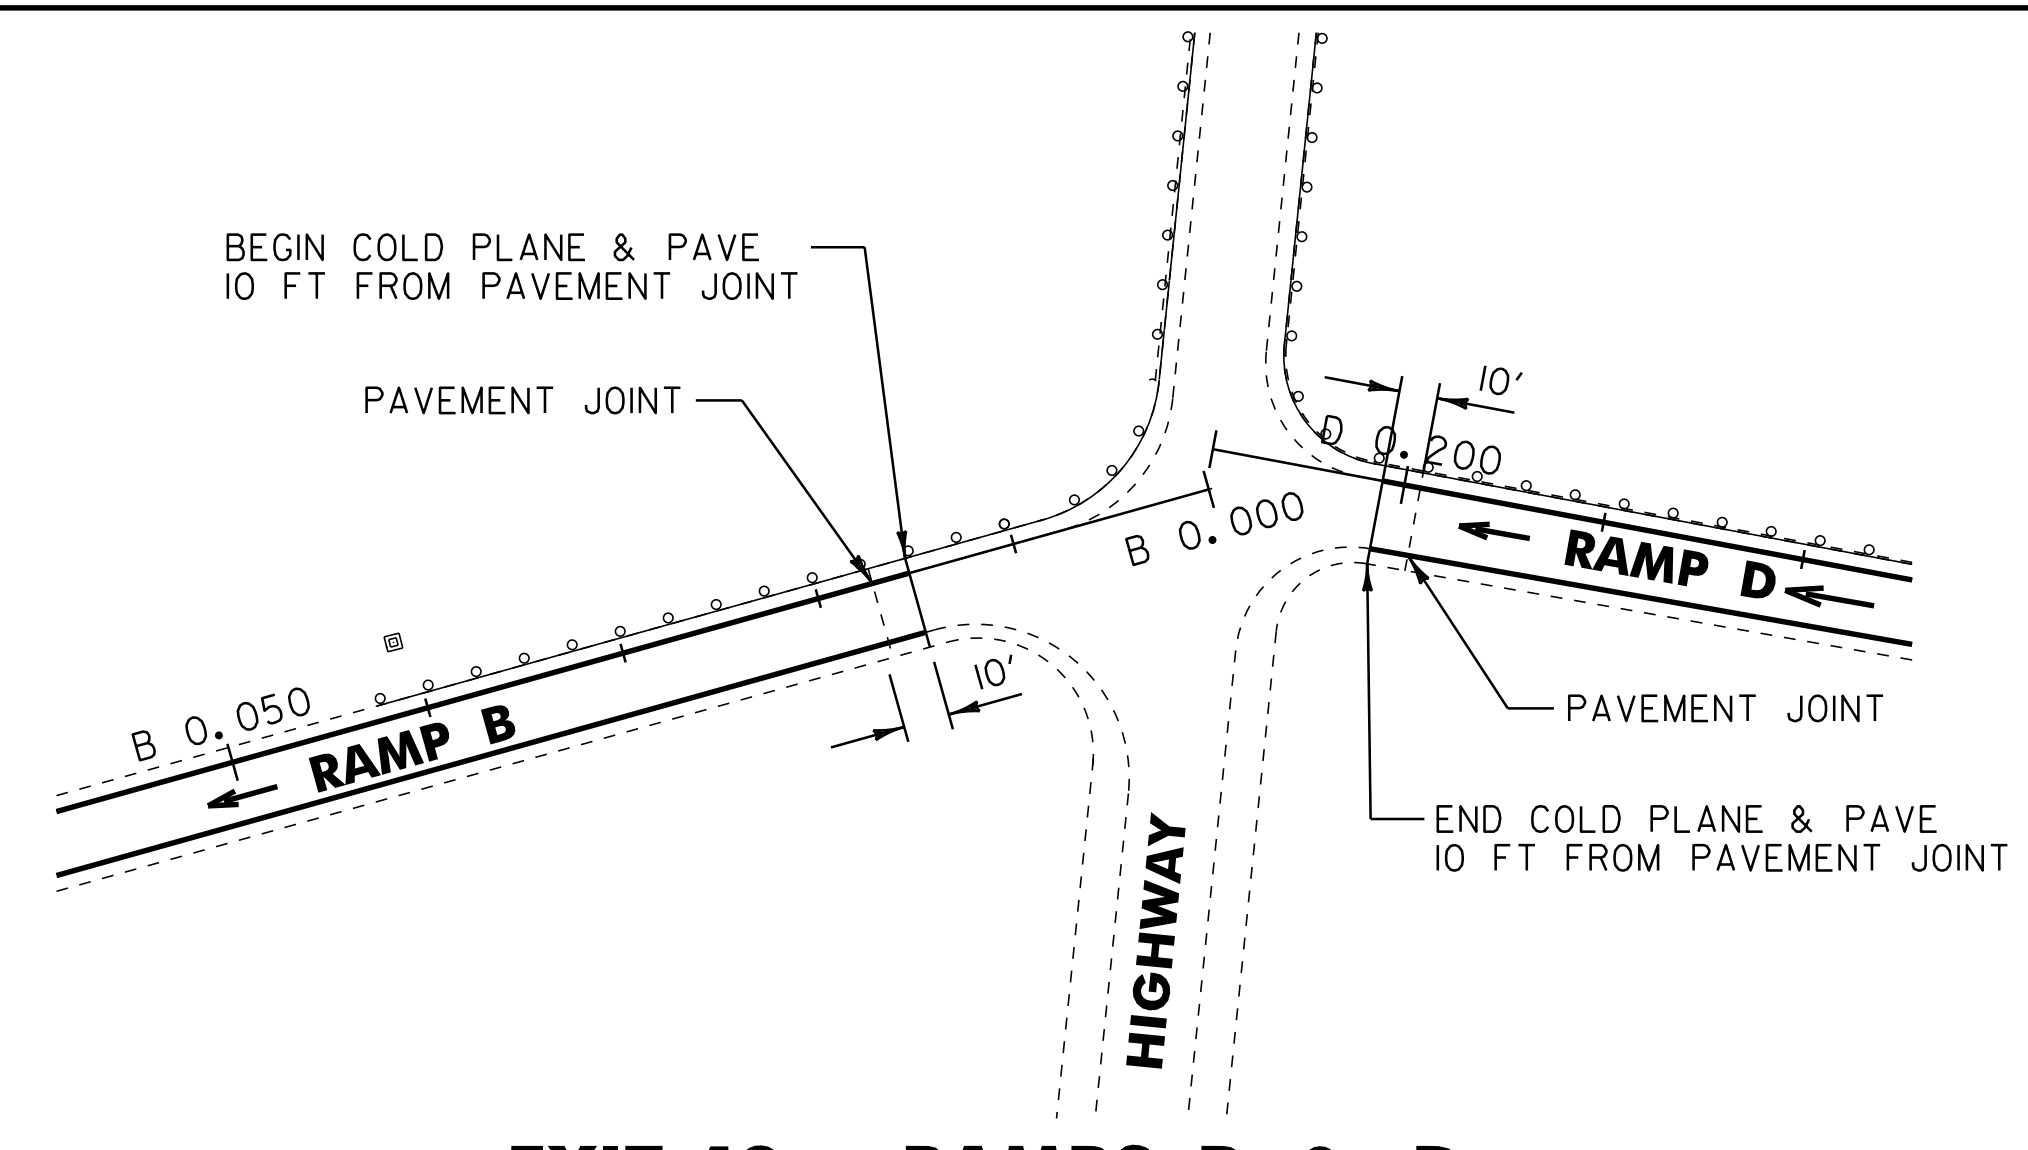

**EXIT 12 - RAMPS B & D
SOUTHBOUND ON & OFF RAMPS**

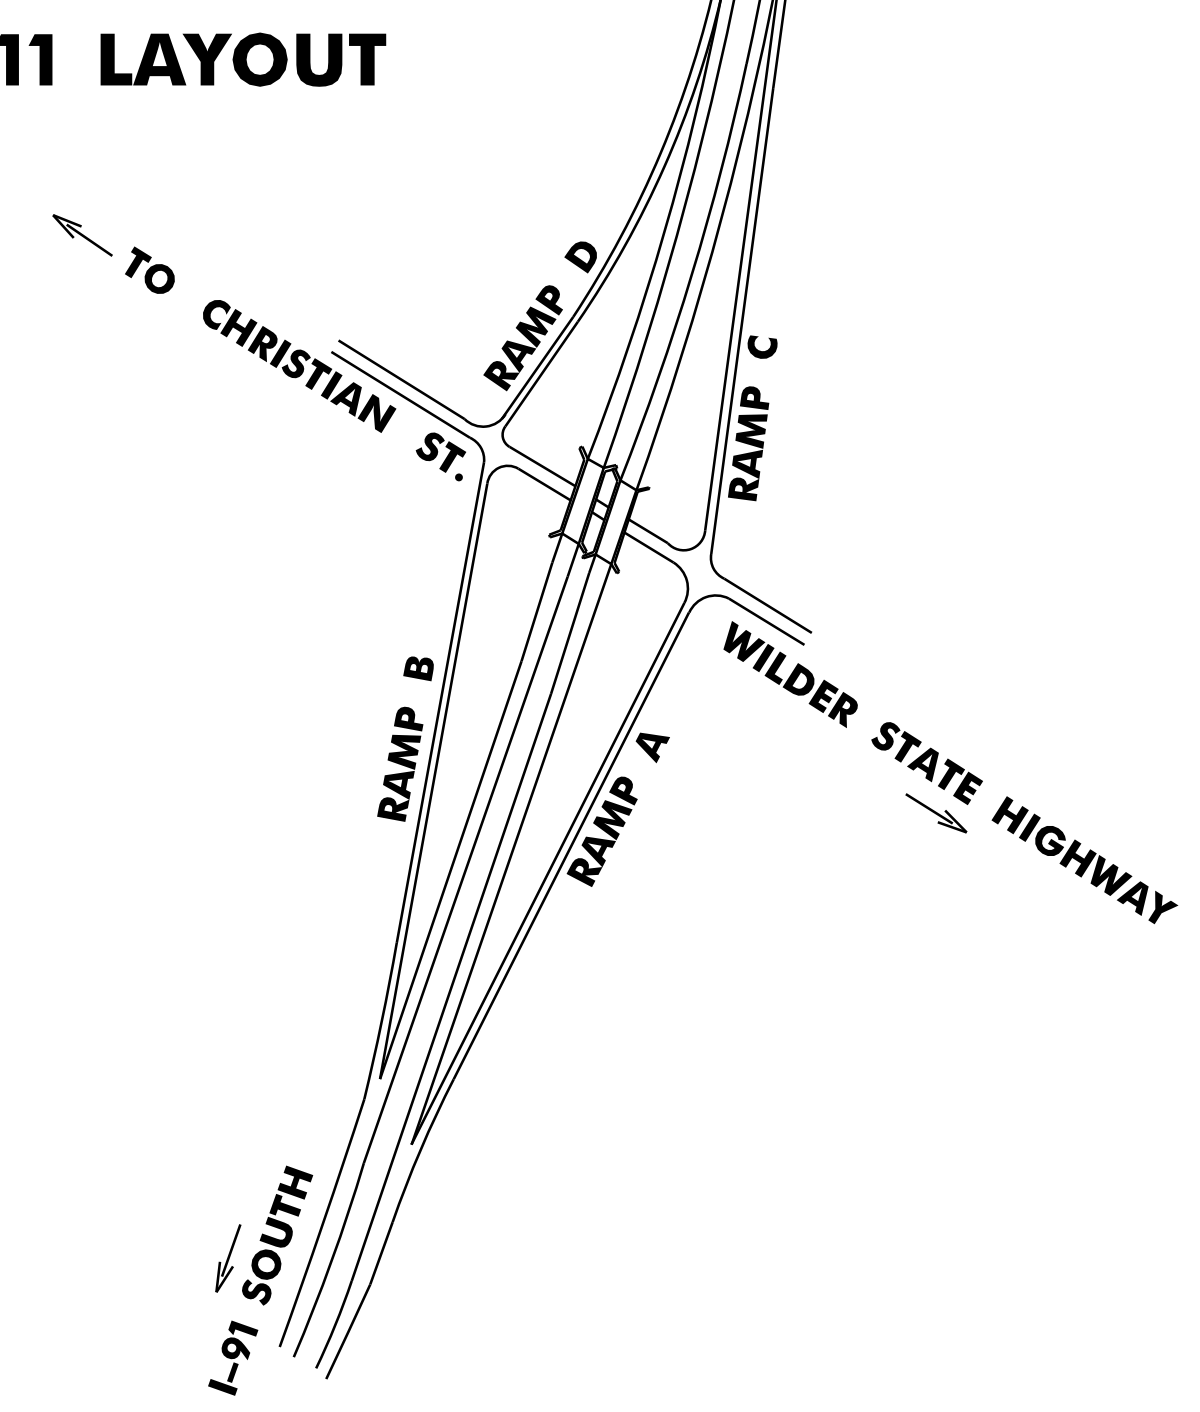

EXIT 12 LAYOUT

EXIT 11 & 12 TIE SHEET

PROJECT NAME:	HARTLAND-NORWICH		
PROJECT NUMBER:	IM 091-I(59)		
FILE NAME:	/pave/06a202/p06a202.dgn	PLOT DATE:	21-NOV-2012 11:44
PROJECT LEADER:	PTS	DRAWN BY:	MWS
DESIGNED BY:	NLL	CHECKED BY:	PTS
IPARM FILE NAME:	06A202_06	SHEET	6 OF 60

NOT TO SCALE