


INTERSTATE ROUTE 91 SB
MM 66.453 66.459
BEGIN PROJECT
HARTLAND-NORWICH
IM 091-1(59)

INTERSTATE ROUTE 91 SB
MM 76.450
END PROJECT
HARTLAND-NORWICH
IM 091-1(59)

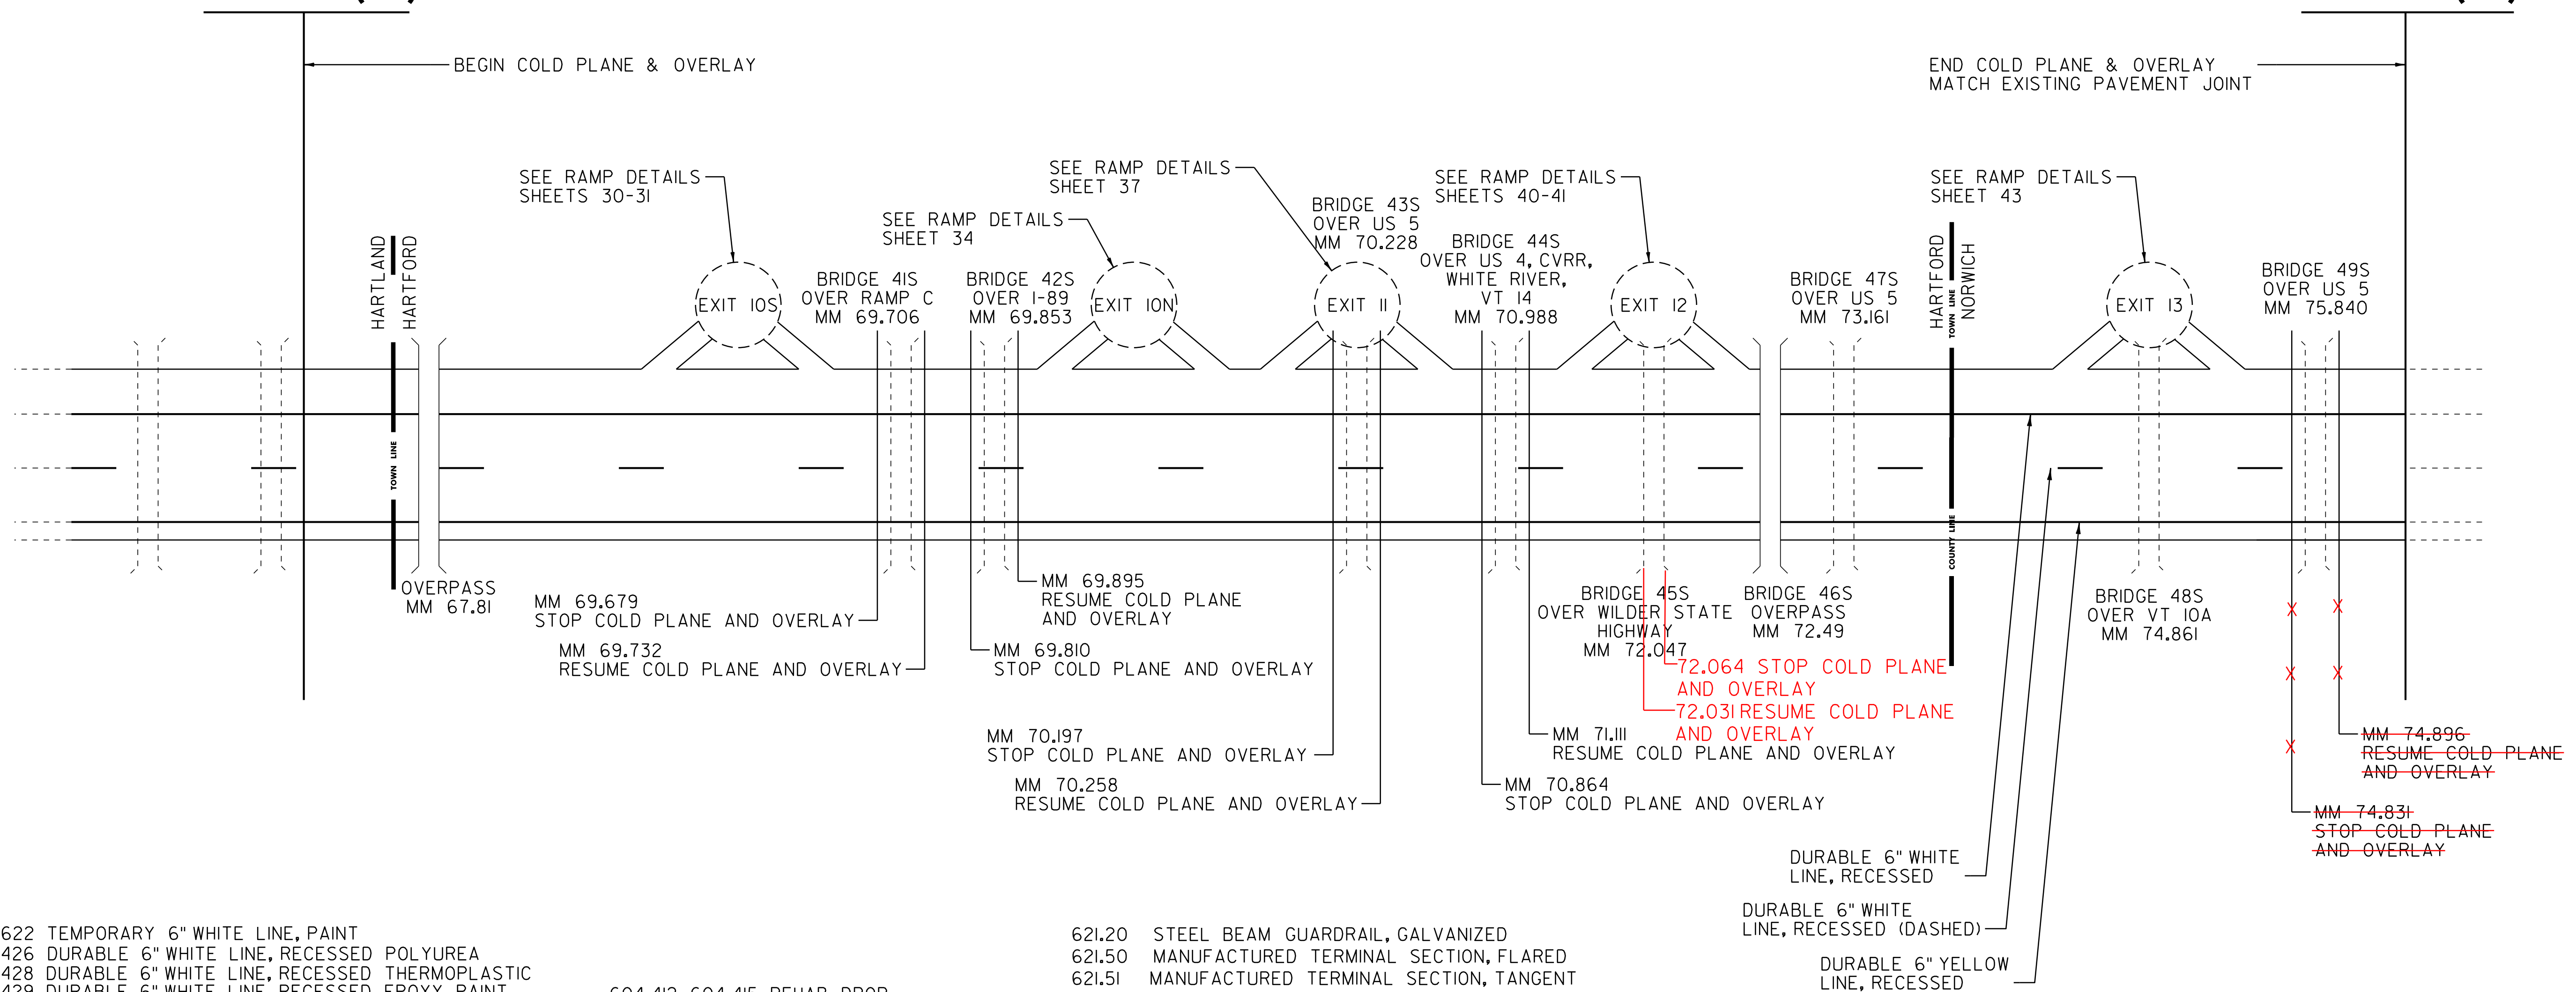

- 646.622 TEMPORARY 6" WHITE LINE, PAINT
- 646.426 DURABLE 6" WHITE LINE, RECESSED POLYUREA
- 646.428 DURABLE 6" WHITE LINE, RECESSED THERMOPLASTIC
- 646.429 DURABLE 6" WHITE LINE, RECESSED EPOXY PAINT
- 66.453 TO 76.450 SOLID LT
- 66.453 TO 76.450 DASHED CL
- 646.632 TEMPORARY 6" YELLOW LINE, PAINT
- 646.436 DURABLE 6" YELLOW LINE, RECESSED POLYUREA
- 646.438 DURABLE 6" YELLOW LINE, RECESSED THERMOPLASTIC
- 646.439 DURABLE 6" YELLOW LINE, RECESSED EPOXY PAINT
- 66.453 TO 76.450 SOLID RT
- *REFERENCE COMP. BINDER SECTION 646.XXX FOR PAINT SUMMARY
- 201.3 THINNING AND TRIMMING FOR SIGNS
- 72.399 LT
- 72.874 LT
- 73.395 LT
- 75.703 LT

- 604.412, 604.415 REHAB. DROP INLETS, CATCH BASINS, OR MANHOLES, CLASS I OR CLASS II
- 66.497 LT (DI)
- 66.510 LT (DI)
- 66.552 LT (DI)
- 66.717 LT (DI)
- 66.754 LT (DI)
- 66.800 LT (DI)
- 67.520 LT (DI)
- 69.239 LT (DI)
- 69.881 LT (DI)
- 70.203 RT (DI)
- 70.255 RT (DI)
- 71.105 RT (DI)
- 72.045 LT (DI)
- 72.066 LT & RT (DI)
- 72.102 LT (DI)
- 73.137 LT (DI)
- 73.185 LT & RT (DI)
- 73.203 LT (DI)
- 73.447 LT (DI)
- 73.513 LT (DI)
- 73.674 LT (DI)
- 73.729 LT (DI)
- 73.777 LT (DI)
- 74.754 LT (DI)
- 74.802 LT (DI)
- 74.832 LT & RT (DI)
- 74.889 LT (DI)
- 75.870 LT (DI)

- 621.20 STEEL BEAM GUARDRAIL, GALVANIZED
- 621.50 MANUFACTURED TERMINAL SECTION, FLARED
- 621.51 MANUFACTURED TERMINAL SECTION, TANGENT
- 621.60 ANCHOR FOR STEEL BEAM RAIL
- 621.74 ALUMINUM APPROACH RAILING
- 621.75 REMOVE AND RESET GUARDRAIL
- 621.76 REPLACE GUARDRAIL POST ASSEMBLY
- 621.77 REPLACE GUARDRAIL BEAM UNIT
- 621.79 ADJUST HEIGHT OF GUARDRAIL
- 621.80 REMOVAL AND DISPOSAL OF GUARDRAIL
- 676.J2 REMOVAL OF EXISTING DELINEATOR
- 900.620 SPECIAL PROVISION (STEEL BEAM GUARDRAIL DELINEATOR)
- 900.620 SPECIAL PROVISION (STEEL BEAM GUARDRAIL OFFSET BLOCK)
- 900.620 SPECIAL PROVISION (DELINEATOR WITH STEEL POST)
- SEE ITEM DETAIL SUMMARY SHEETS
- *REFERENCE COMP. BINDER SECTION 621.XXX FOR GUARDRAIL SUMMARY
- 613.I0 STONE FILL, TYPE I
- SEE DITCH CLEANING SHEET

- 620.75 SNOW BARRIER, GALVANIZED
- 70.228 LT & RT (140') BRIDGE 43 S 156'
- 70.948 LT & RT (222') BRIDGE 44 S 472'

PAVEMENT CORES IN 10 FT SHOULDER

#	MM	DEPTH	PCC
24	76.35	6"	NO
25	74.15	6"	NO
26	72.75	5.5"	NO
27	70.30	3.75"	NO
28	69.10	3.5"	NO
29	68.05	7"	NO
30	66.85	4"	NO

*REFERENCE COMP. BINDER SECTION 604.XXX FOR REHAB DIQUANTITIY AND LOCATION

NOT TO SCALE

SB MAINLINE LAYOUT

PROJECT NAME: HARTLAND-NORWICH	FILE NAME: /pave/06a202/p06a202.dgn	PLOT DATE: 21-NOV-2012 11:45
PROJECT NUMBER: IM 091-1(59)	PROJECT LEADER: PTS	DRAWN BY: WWG
	DESIGNED BY: NULL	CHECKED BY: PTS
	IPARM FILE NAME: 06A202_27	SHEET 27 OF 60