
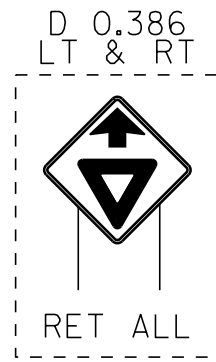


MATCH LINE D0.200
SEE SHEET 28

646.622 TEMPORARY 6" WHITE LINE, PAINT
 646.426 DURABLE 6" WHITE LINE, RECESSED POLYUREA
 646.428 DURABLE 6" WHITE LINE, RECESSED THERMOPLASTIC
 646.429 DURABLE 6" WHITE LINE, RECESSED EPOXY PAINT
 D 0.200 TO D 0.498 SOLID RT

646.632 TEMPORARY 6" YELLOW LINE, PAINT
 646.436 DURABLE 6" YELLOW LINE, RECESSED POLYUREA
 646.438 DURABLE 6" YELLOW LINE, RECESSED THERMOPLASTIC
 646.439 DURABLE 6" YELLOW LINE, RECESSED EPOXY PAINT
 D 0.200 TO D 0.498 SOLID LT

~~646.692 TEMPORARY LETTER OR SYMBOL, PAINT~~
 646.492 DURABLE LETTER OR SYMBOL, THERMOPLASTIC
 646.493 DURABLE LETTER OR SYMBOL, EPOXY PAINT
 D 0.382 LT "YIELD"
 D 0.390 LT "AHEAD"
 D 0.474 LT YIELD MARKINGS (5 EA.)

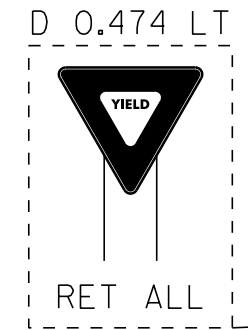

RETAIN EXISTING
GUARDRAIL

**END COLD PLANE & OVERLAY
RAMP D MM 0.498**

NOT TO SCALE

LEGEND

| | | |
|-----|---|--------------------|
| R | = | REMOVE EXISTING |
| S | = | SALVAGE |
| R&S | = | REMOVE AND SALVAGE |
| N | = | NEW |
| RET | = | RETAIN |
| B-B | = | BACK TO BACK |
| | = | EXISTING GUARDRAIL |
| | = | PROPOSED GUARDRAIL |
| YL | = | YELLOW LINE |
| WL | = | WHITE LINE |

**EXIT 10
NB OFF RAMP D DETAIL SHEET 2**

| | | |
|--------------------------------|-------------------------------------|------------------------------|
| PROJECT NAME: HARTLAND-NORWICH | FILE NAME: /pave/06a202/p06a202.dgn | PLOT DATE: 21-NOV-2012 11:45 |
| PROJECT NUMBER: IM 091-I(59) | PROJECT LEADER: PTS | DRAWN BY: WWG |
| | DESIGNED BY: NULL | CHECKED BY: PTS |
| | IPARM FILE NAME: 06A202_29 | SHEET 29 OF 60 |