

646.622 TEMPORARY 6" WHITE LINE, PAINT  
 646.426 DURABLE 6" WHITE LINE, RECESSED POLYUREA  
 646.428 DURABLE 6" WHITE LINE, RECESSED THERMOPLASTIC  
 646.429 DURABLE 6" WHITE LINE, RECESSED EPOXY PAINT

C 0.087 TO C 0.295 SOLID RT  
 C 0.324 TO C 0.480 SOLID RT  
 E 0.000 TO E 0.060 SOLID RT  
 F 0.018 TO F 0.252 SOLID RT

646.632 TEMPORARY 6" YELLOW LINE, PAINT  
 646.436 DURABLE 6" YELLOW LINE, RECESSED POLYUREA  
 646.438 DURABLE 6" YELLOW LINE, RECESSED THERMOPLASTIC  
 646.439 DURABLE 6" YELLOW LINE, RECESSED EPOXY PAINT

C 0.087 TO C 0.480 SOLID LT  
 E 0.028 TO E 0.060 SOLID LT  
 F 0.018 TO F 0.252 SOLID LT


613.10 STONE FILL, TYPE I  
 F 0.037 RT  
 F 0.071 RT  
 F 0.152 RT  
 F 0.234 RT

646.662 TEMPORARY 12" WHITE LINE, PAINT  
 646.466 DURABLE 12" WHITE LINE, RECESSED POLYUREA  
 646.469 DURABLE 12" WHITE LINE, RECESSED EPOXY PAINT

C 0.319 TO C 0.324 SOLID RT  
 E 0.023 TO E 0.028 SOLID LT  
 F 0.009 TO F 0.018 SOLID LT  
 F 0.009 TO F 0.018 SOLID LT (GORE STRIPES)  
 69.754 TO 69.773 SOLID LT

621.20 STEEL BEAM GUARDRAIL, GALVANIZED  
 621.50 MANUFACTURED TERMINAL SECTION, FLARED  
 621.80 REMOVAL AND DISPOSAL OF GUARDRAIL  
 SEE ITEM DETAIL SUMMARY SHEETS

•REFERENCE COMP. BINDER SECTION 621.XXX FOR GUARDRAIL SUMMARY

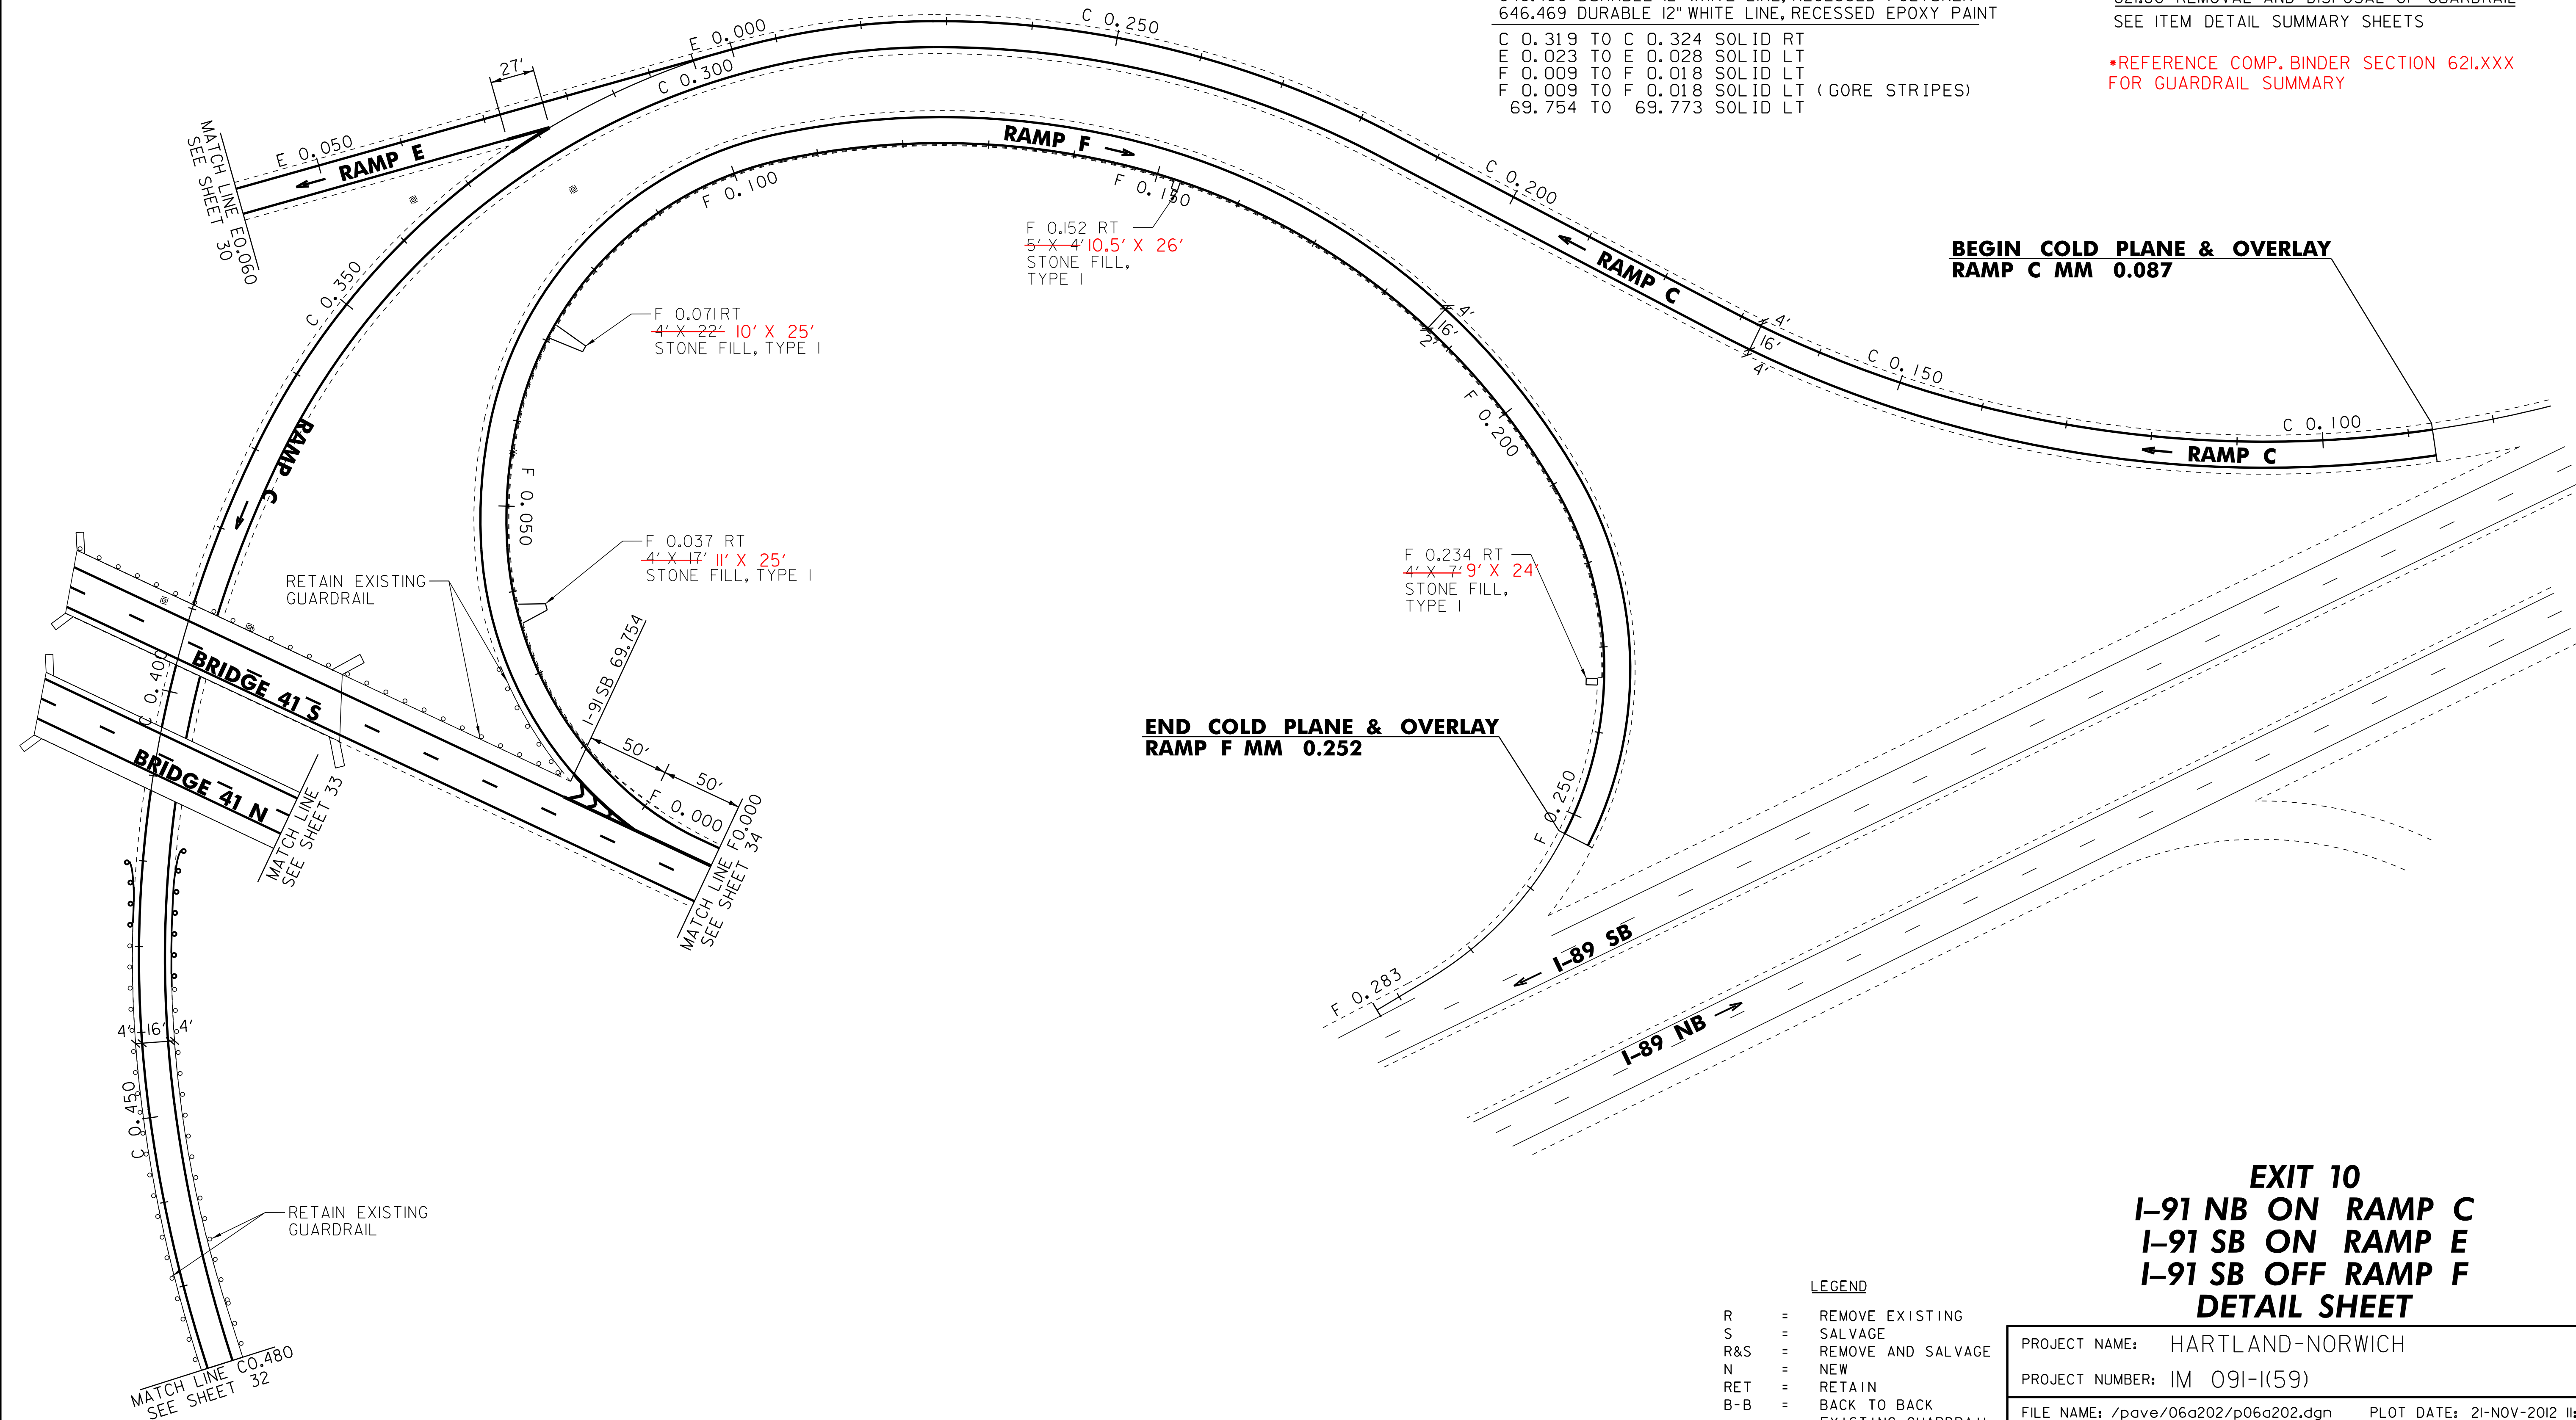

**BEGIN COLD PLANE & OVERLAY  
 RAMP C MM 0.087**

**END COLD PLANE & OVERLAY  
 RAMP F MM 0.252**

**EXIT 10  
 I-91 NB ON RAMP C  
 I-91 SB ON RAMP E  
 I-91 SB OFF RAMP F  
 DETAIL SHEET**

**LEGEND**

R	=	REMOVE EXISTING
S	=	SALVAGE
R&S	=	REMOVE AND SALVAGE
N	=	NEW
RET	=	RETAIN
B-B	=	BACK TO BACK
	=	EXISTING GUARDRAIL
	=	PROPOSED GUARDRAIL
YL	=	YELLOW LINE
WL	=	WHITE LINE

PROJECT NAME:	HARTLAND-NORWICH	
PROJECT NUMBER:	IM 091-I(59)	
FILE NAME:	/pave/06a202/p06a202.dgn	PLOT DATE: 21-NOV-2012 11:45
PROJECT LEADER:	PTS	DRAWN BY: WWG
DESIGNED BY:	NLL	CHECKED BY: PTS
IPARM FILE NAME:	06A202_31	SHEET 31 OF 60

NOT TO SCALE