


END COLD PLANE & OVERLAY
RAMP B MM 0.389

BEGIN COLD PLANE & OVERLAY
RAMP F MM 0.009

BEGIN COLD PLANE & OVERLAY
RAMP A MM 0.047

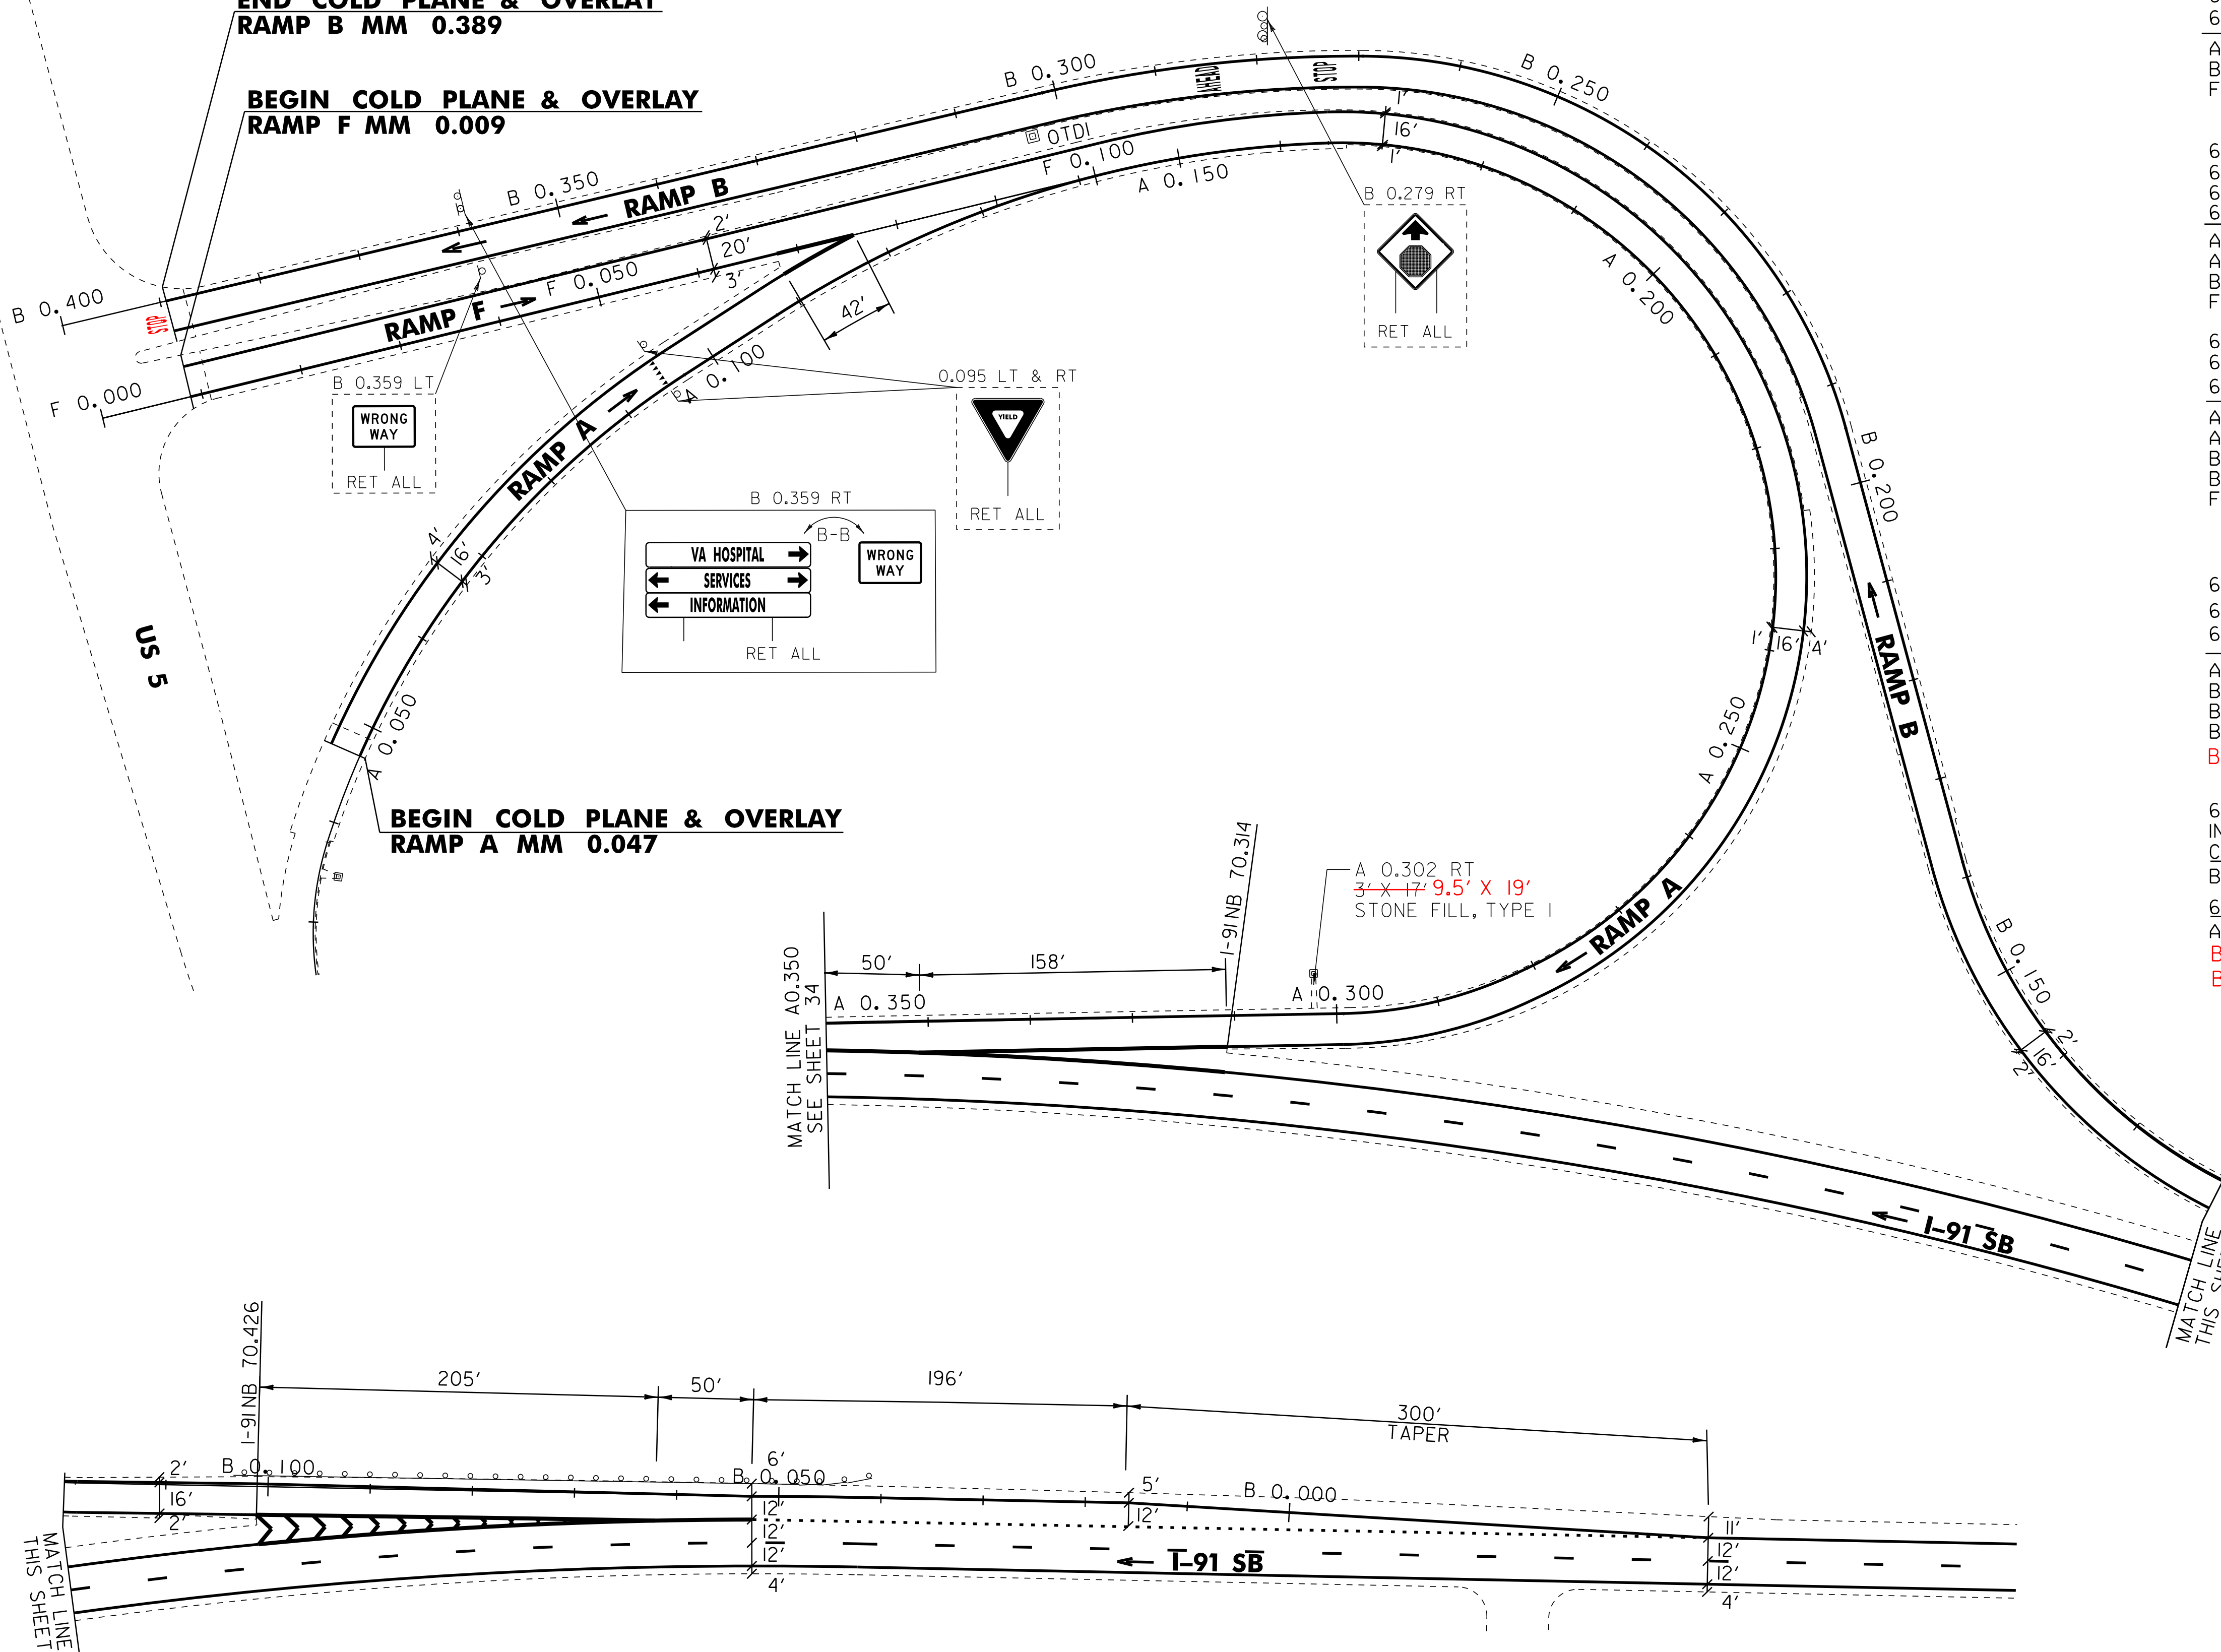

- 646.622 TEMPORARY 6" WHITE LINE, PAINT
- 646.426 DURABLE 6" WHITE LINE, RECESSED POLYUREA
- 646.428 DURABLE 6" WHITE LINE, RECESSED THERMOPLASTIC
- 646.429 DURABLE 6" WHITE LINE, RECESSED EPOXY PAINT

- A 0.047 TO A 0.311 SOLID RT
- B 0.101 TO B 0.389 SOLID RT
- F 0.009 TO F 0.068 SOLID RT
- 70.474 TO 70.568 DOTTED LT

- 646.632 TEMPORARY 6" YELLOW LINE, PAINT
- 646.436 DURABLE 6" YELLOW LINE, RECESSED POLYUREA
- 646.438 DURABLE 6" YELLOW LINE, RECESSED THERMOPLASTIC
- 646.439 DURABLE 6" YELLOW LINE, RECESSED EPOXY PAINT

- A 0.047 TO A 0.110 SOLID LT
- A 0.142 TO A 0.311 SOLID LT
- B 0.101 TO B 0.389 SOLID LT
- F 0.009 TO F 0.100 SOLID LT

- 646.662 TEMPORARY 12" WHITE LINE, PAINT
- 646.466 DURABLE 12" WHITE LINE, RECESSED POLYUREA
- 646.469 DURABLE 12" WHITE LINE, RECESSED EPOXY PAINT


- A 0.110 TO A 0.118 SOLID LT
- A 0.311 TO A 0.341 SOLID LT
- B 0.062 TO B 0.101 SOLID LT
- B 0.062 TO B 0.101 SOLID LT (GORE STRIPES)
- F 0.068 TO F 0.076 SOLID RT
- 70.275 TO 70.314 SOLID LT
- 70.426 TO 70.474 SOLID LT

- 646.692 ~~TEMPORARY LETTER OR SYMBOL, PAINT~~
- 646.492 DURABLE LETTER OR SYMBOL, THERMOPLASTIC
- 646.493 DURABLE LETTER OR SYMBOL, EPOXY PAINT

- A 0.095 LT YIELD MARKINGS (5 EA)
- B 0.274 LT "STOP"
- B 0.282 LT "AHEAD"
- B 0.359 LT WRONG WAY ARROW
- B X.XXX LT "STOP"

- 604.412, 604.415 REHAB. DROP INLETS, CATCH BASINS, OR MANHOLES, CLASS I OR CLASS II
- 604.XXX FOR REHAB DILOCATIONS

- 613.10 STONE FILL, TYPE I
- A 0.302 RT (RAMP A)
- B X.XXX RT RAMP B
- B X.XXX RT RAMP B

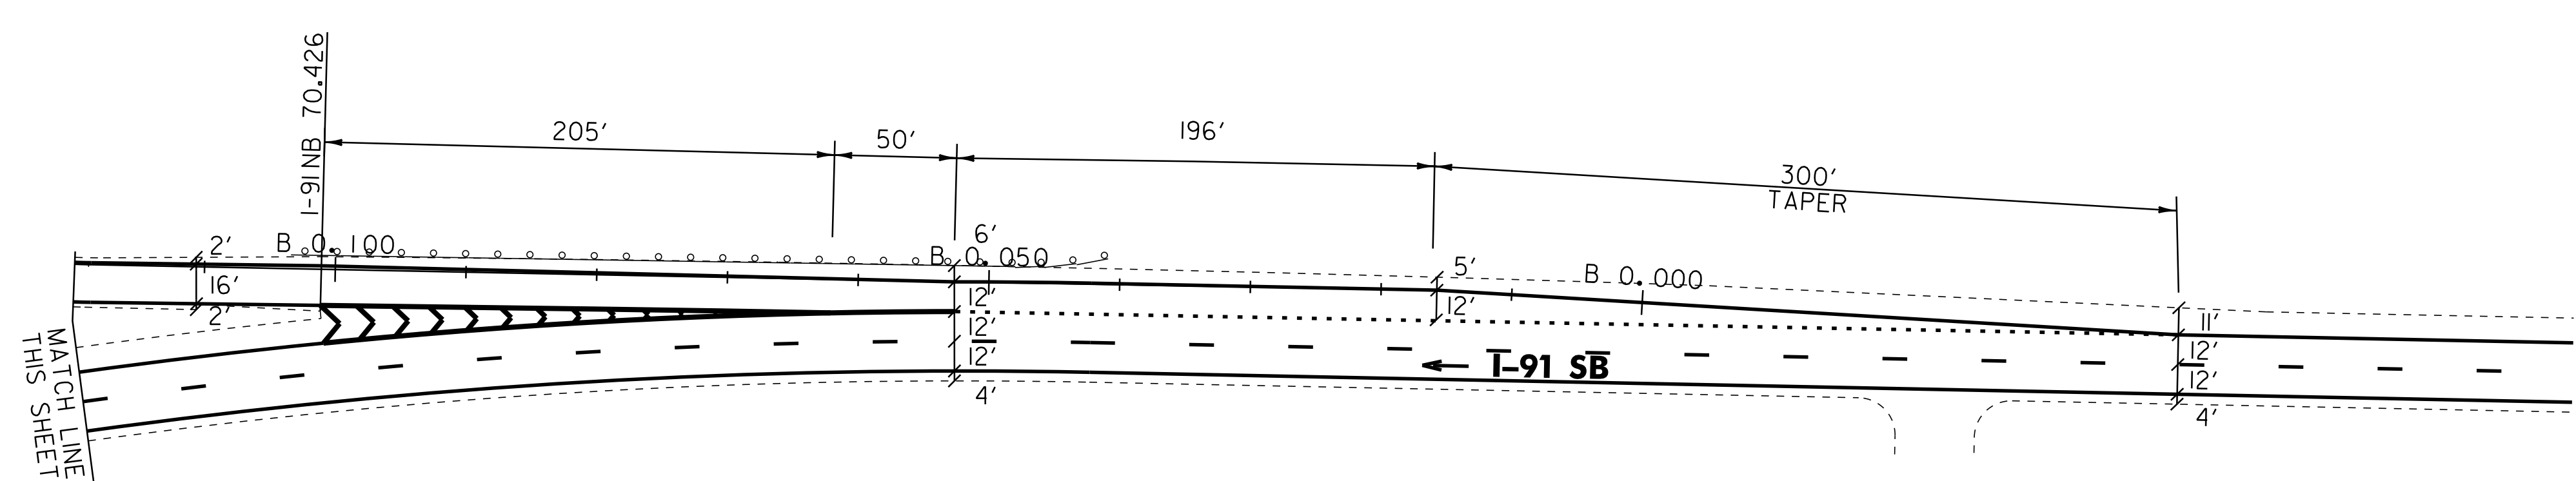

LEGEND

R	=	REMOVE EXISTING
S	=	SALVAGE
R&S	=	REMOVE AND SALVAGE
N	=	NEW
RET	=	RETAIN
B-B	=	BACK TO BACK
	=	EXISTING GUARDRAIL
	=	PROPOSED GUARDRAIL
YL	=	YELLOW LINE
WL	=	WHITE LINE

**EXIT 11
SB OFF RAMP B
SB ON RAMPS A&F DETAIL SHEET**

PROJECT NAME: HARTLAND-NORWICH	FILE NAME: /pave/06a202/p06a202.dgn	PLOT DATE: 21-NOV-2012 11:45
PROJECT NUMBER: IM 091-1(59)	PROJECT LEADER: PTS	DRAWN BY: WWG
	DESIGNED BY: NLL	CHECKED BY: PTS
	IPARM FILE NAME: 06A202_37	SHEET 37 OF 60

NOT TO SCALE