

646.622 TEMPORARY 6" WHITE LINE, PAINT  
 646.426 DURABLE 6" WHITE LINE, RECESSED POLYUREA  
 646.428 DURABLE 6" WHITE LINE, RECESSED THERMOPLASTIC  
 646.429 DURABLE 6" WHITE LINE, RECESSED EPOXY PAINT

A 0.058 TO A 0.250 SOLID RT  
 71.638 TO 71.712 DOTTED RT

646.632 TEMPORARY 6" YELLOW LINE, PAINT  
 646.436 DURABLE 6" YELLOW LINE, RECESSED POLYUREA  
 646.438 DURABLE 6" YELLOW LINE, RECESSED THERMOPLASTIC  
 646.439 DURABLE 6" YELLOW LINE, RECESSED EPOXY PAINT

A 0.058 TO A 0.250 SOLID LT



646.662 TEMPORARY 12" WHITE LINE, PAINT  
 646.466 DURABLE 12" WHITE LINE, RECESSED POLYUREA  
 646.469 DURABLE 12" WHITE LINE, RECESSED EPOXY PAINT

A 0.011 TO A 0.058 SOLID LT  
 A 0.011 TO A 0.058 SOLID LT (GORE STRIPES)  
 71.706 TO 71.768 SOLID RT

646.692 TEMPORARY LETTER OR SYMBOL, PAINT  
 646.492 DURABLE LETTER OR SYMBOL, THERMOPLASTIC  
 646.493 DURABLE LETTER OR SYMBOL, EPOXY PAINT

A 0.126 LT "STOP"  
 A 0.134 LT "AHEAD"  
 A 0.224 LT WRONG WAY ARROW

A X.XXX LT "STOP"

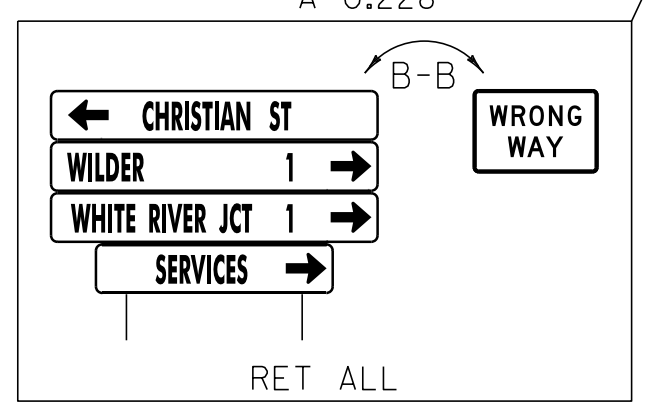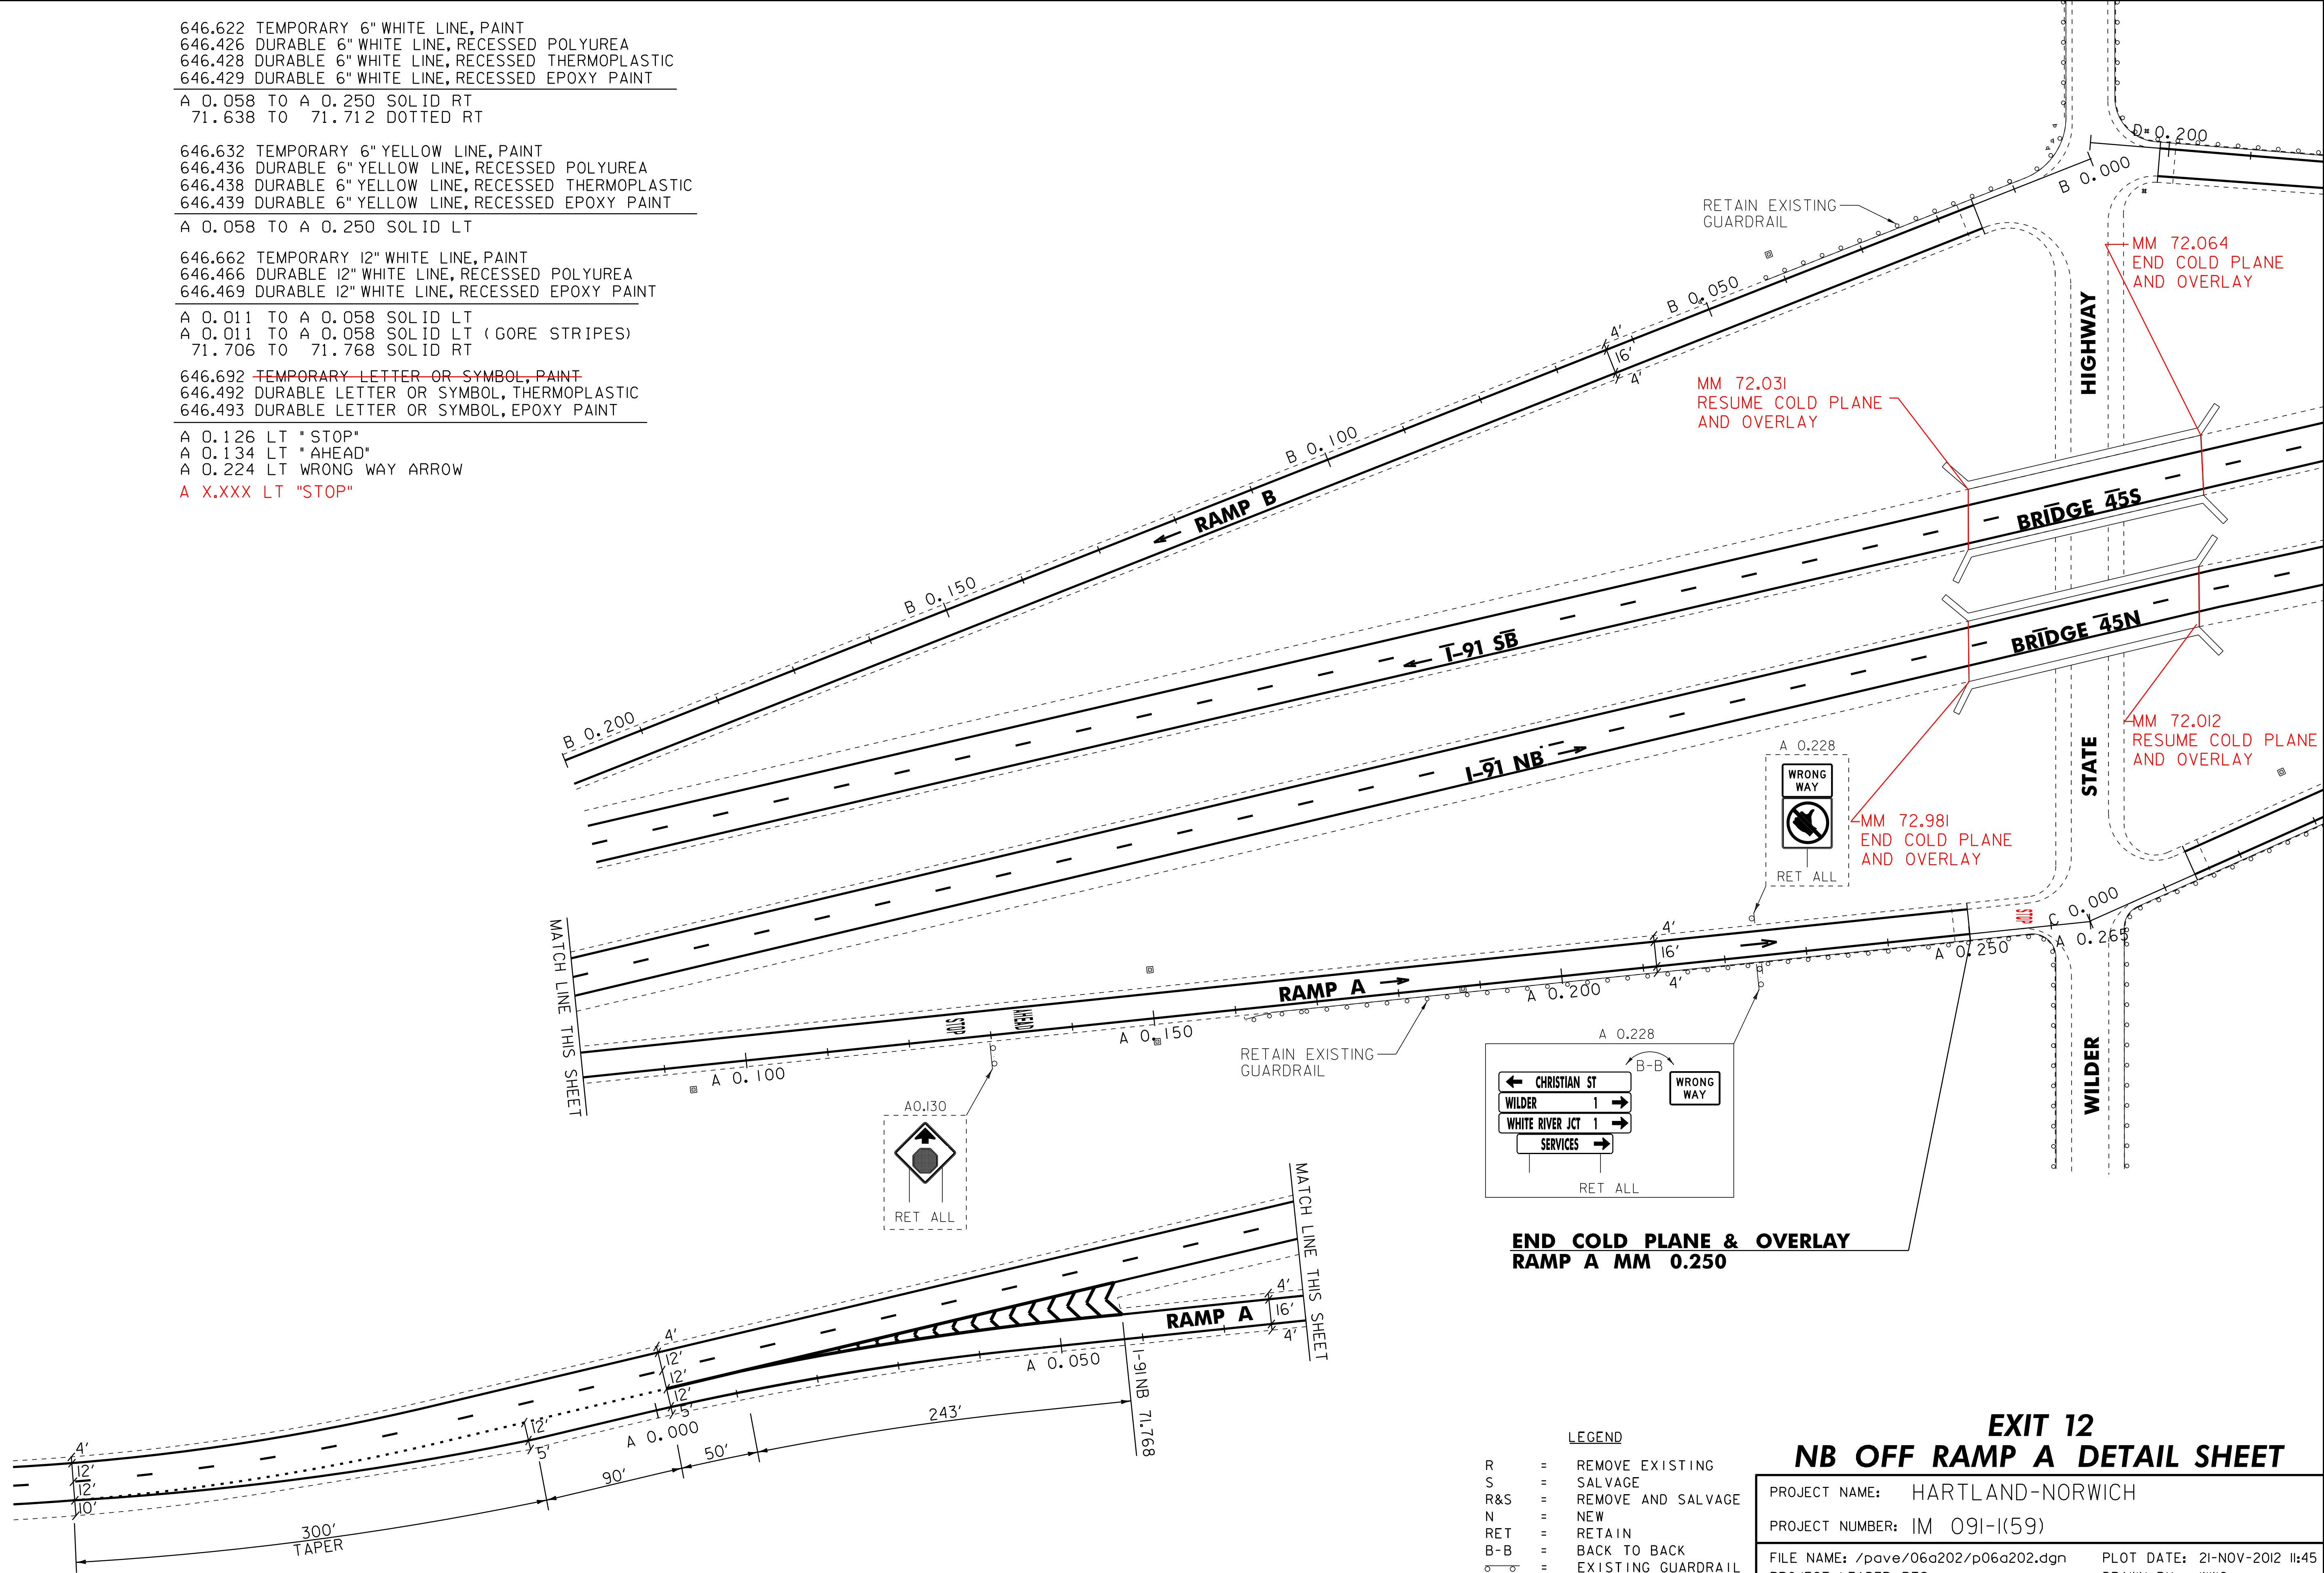

**END COLD PLANE & OVERLAY  
 RAMP A MM 0.250**

**LEGEND**

- R = REMOVE EXISTING
- S = SALVAGE
- R&S = REMOVE AND SALVAGE
- N = NEW
- RET = RETAIN
- B-B = BACK TO BACK
- = EXISTING GUARDRAIL
- - - = PROPOSED GUARDRAIL
- YL = YELLOW LINE
- WL = WHITE LINE

**EXIT 12  
 NB OFF RAMP A DETAIL SHEET**

PROJECT NAME: HARTLAND-NORWICH	FILE NAME: /pave/06a202/p06a202.dgn	PLOT DATE: 21-NOV-2012 11:45
PROJECT NUMBER: IM 091-I(59)	PROJECT LEADER: PTS	DRAWN BY: WGW
	DESIGNED BY: NLL	CHECKED BY: PTS
	IPARM FILE NAME: 06A202_38	SHEET 38 OF 60

NOT TO SCALE