


- 646.622 TEMPORARY 6" WHITE LINE, PAINT
- 646.426 DURABLE 6" WHITE LINE, RECESSED POLYUREA
- 646.428 DURABLE 6" WHITE LINE, RECESSED THERMOPLASTIC
- 646.429 DURABLE 6" WHITE LINE, RECESSED EPOXY PAINT
- C 0.014 TO C 0.179 SOLID RT
- 72.203 TO 72.360 DOTTED RT
- 646.632 TEMPORARY 6" YELLOW LINE, PAINT
- 646.436 DURABLE 6" YELLOW LINE, RECESSED POLYUREA
- 646.438 DURABLE 6" YELLOW LINE, RECESSED THERMOPLASTIC
- 646.439 DURABLE 6" YELLOW LINE, RECESSED EPOXY PAINT
- C 0.014 TO C 0.179 SOLID LT
- 646.662 TEMPORARY 12" WHITE LINE, PAINT
- 646.466 DURABLE 12" WHITE LINE, RECESSED POLYUREA
- 646.469 DURABLE 12" WHITE LINE, RECESSED EPOXY PAINT
- C 0.179 TO C 0.231 SOLID LT
- 72.141 TO 72.203 SOLID RT

- 604.412, 604.415 REHAB. DROP INLETS, CATCH BASINS, OR MANHOLES, CLASS I OR CLASS II
- C 0.067 RT
- C 0.171 RT
- 613.10 STONE FILL, TYPE I
- ~~C 0.016 RT (RAMP C)~~
- * REFERENCE COMP. BINDER SECTION 604.XXX FOR REHAB DILOCATIONS

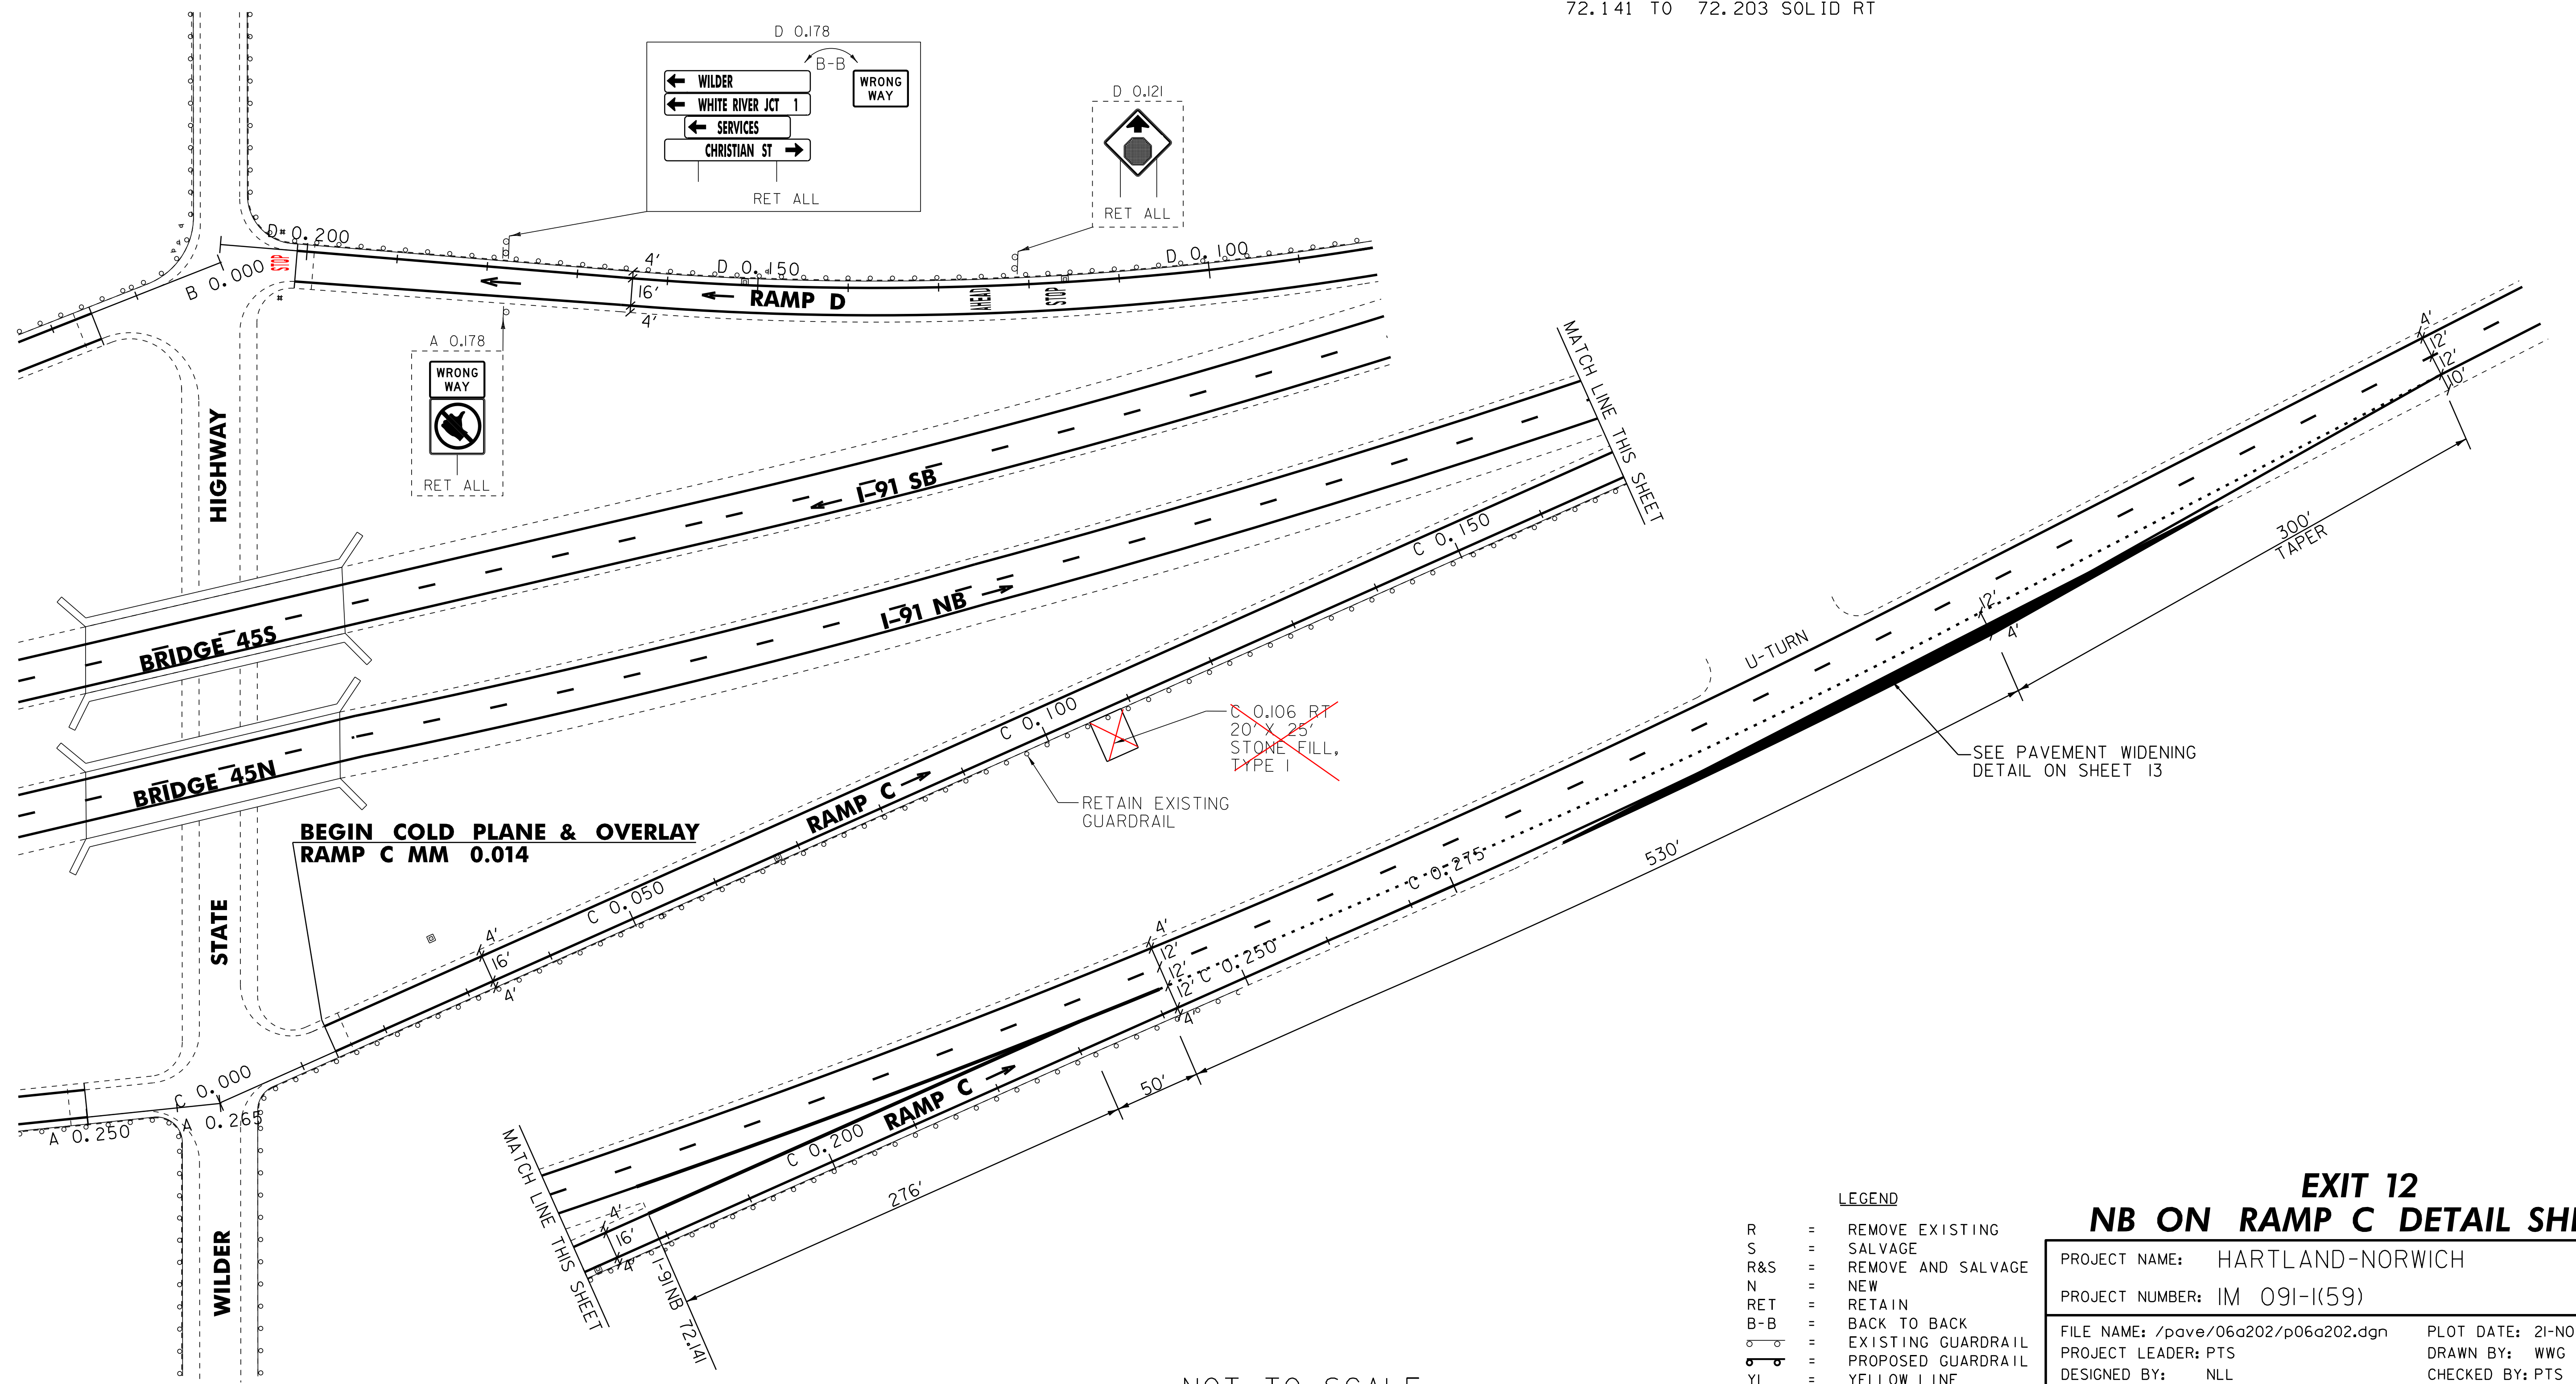

NOT TO SCALE

LEGEND

R	=	REMOVE EXISTING
S	=	SALVAGE
R&S	=	REMOVE AND SALVAGE
N	=	NEW
RET	=	RETAIN
B-B	=	BACK TO BACK
	=	EXISTING GUARDRAIL
	=	PROPOSED GUARDRAIL
YL	=	YELLOW LINE
WL	=	WHITE LINE

**EXIT 12
NB ON RAMP C DETAIL SHEET**

PROJECT NAME: HARTLAND-NORWICH	FILE NAME: /pave/06a202/p06a202.dgn	PLOT DATE: 21-NOV-2012 11:45
PROJECT NUMBER: IM 091-I(59)	PROJECT LEADER: PTS	DRAWN BY: WWG
	DESIGNED BY: NULL	CHECKED BY: PTS
	IPARM FILE NAME: 06A202_39	SHEET 39 OF 60