


GUARDRAIL TREATMENT AT BULLNOSE LOCATION - BRIDGE 39 N&S


INTERSTATE 91 OVER US ROUTE 5

NOTE
I. SEE NOTE 16 ON SHEET 8.

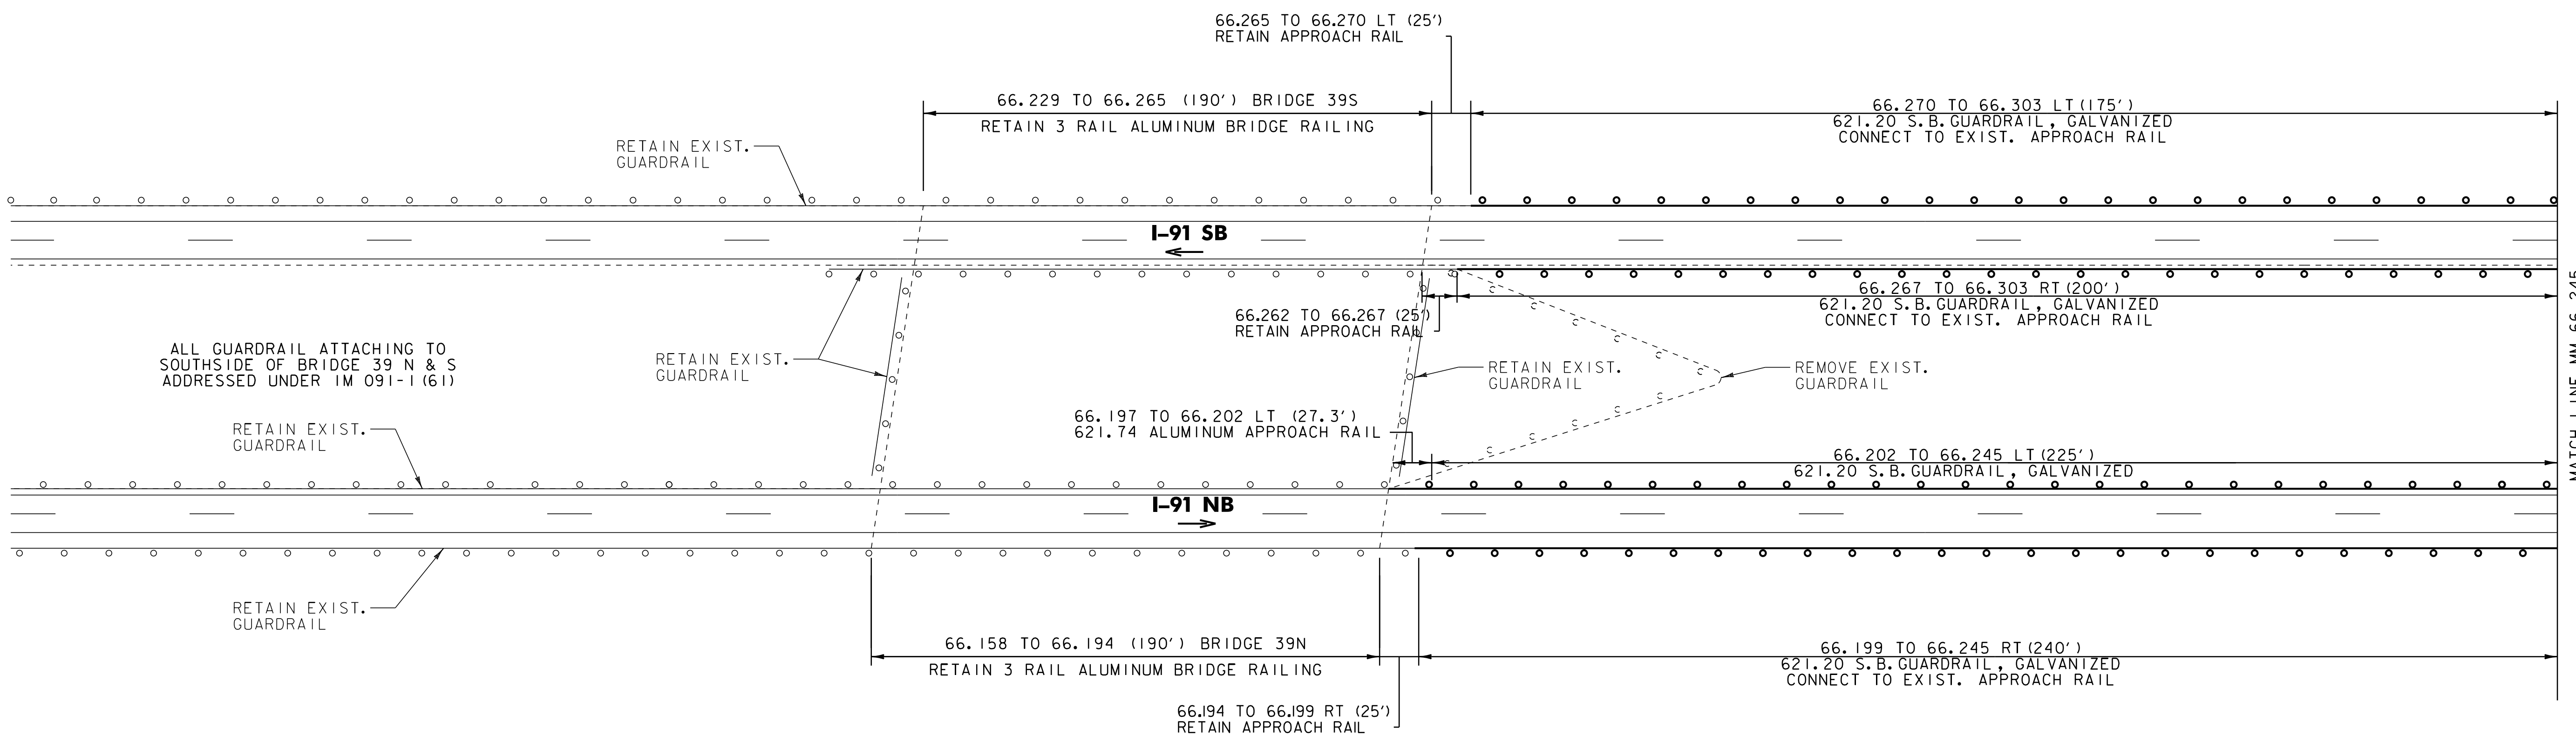

GUARDRAIL TREATMENT AT BULLNOSE LOCATION - BRIDGE 40 N&S

INTERSTATE 91 OVER OTTAUQUECHEE RIVER

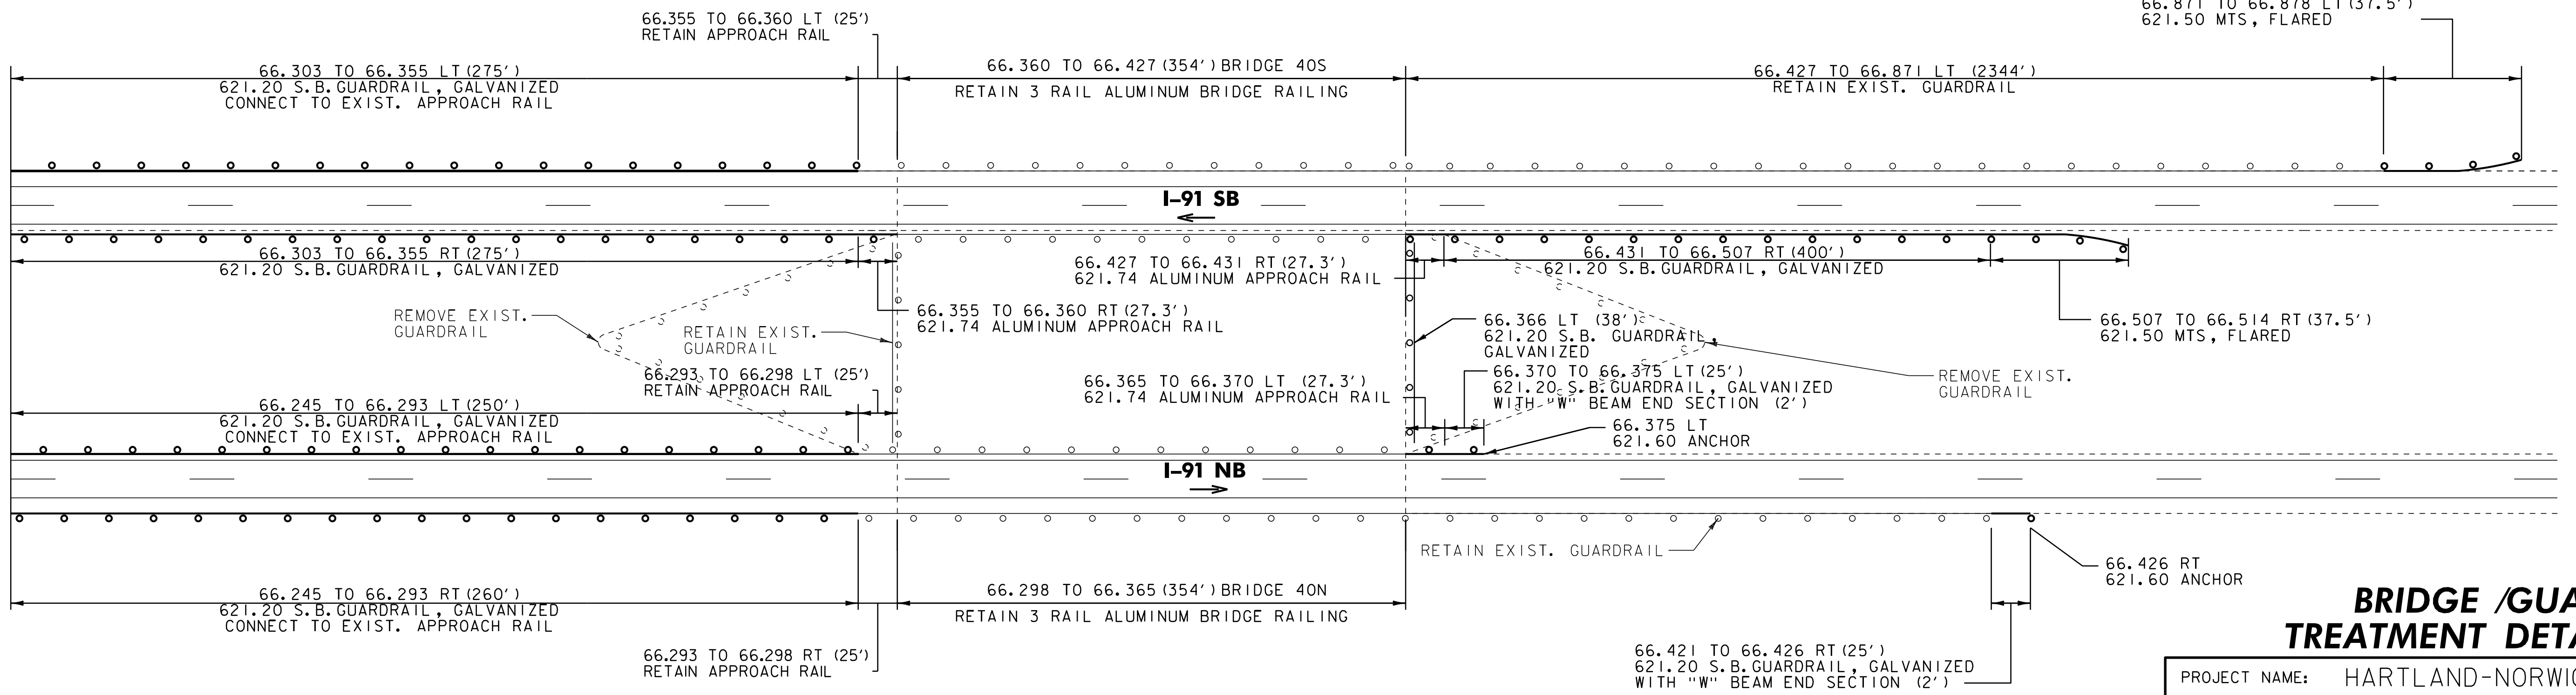

BRIDGE / GUARDRAIL TREATMENT DETAIL SHEET 1

PROJECT NAME: HARTLAND-NORWICH	FILE NAME: /pave/06a202/p06a202.dgn	PLOT DATE: 21-NOV-2012 11:45
PROJECT NUMBER: IM 091-1(59)	PROJECT LEADER: PTS	DRAWN BY: WWG
	DESIGNED BY: NLL	CHECKED BY: PTS
	IPARM FILE NAME: 06A202-47	SHEET 47 OF 60

* REFERENCE COMP. BINDER SECTION 621.XXX
FOR GUARDRAIL SUMMARY SHEET

NOT TO SCALE