


GUARDRAIL TREATMENT - BRIDGE 41 N&S


INTERSTATE 91 OVER INTERCHANGE 10 RAMP C

NOTE
I. SEE NOTE 16 ON SHEET 8.

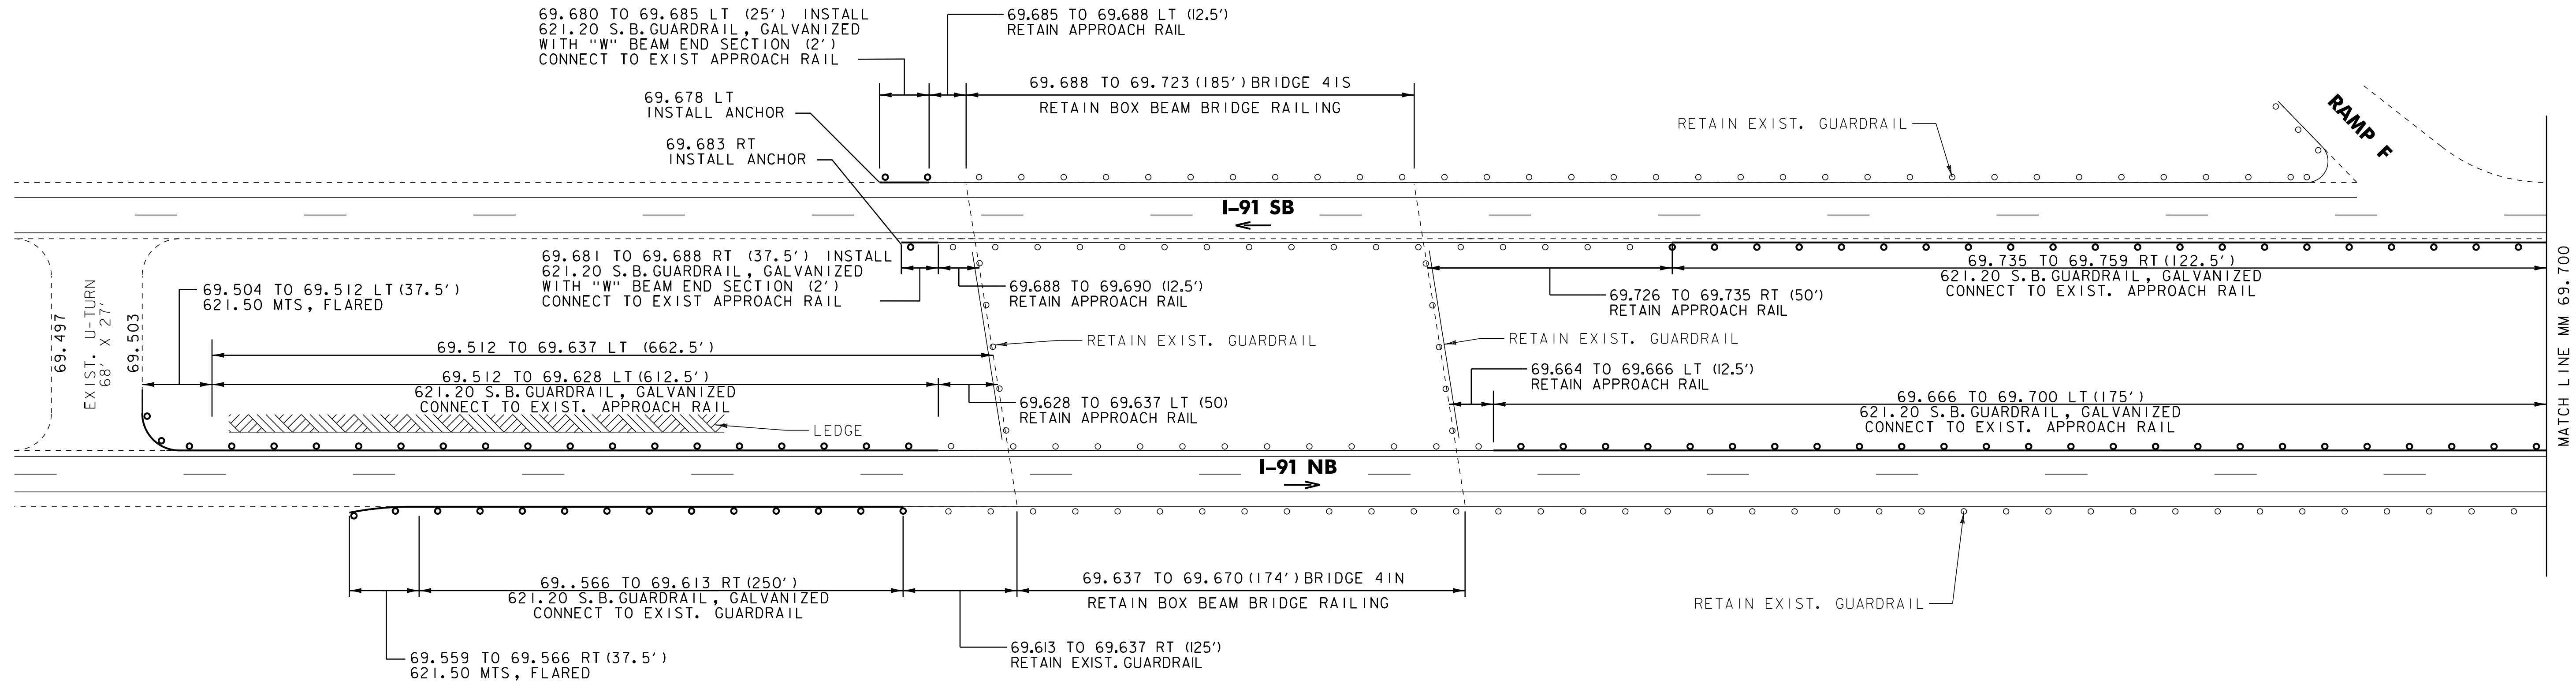

GUARDRAIL TREATMENT - BRIDGE 42 N&S

INTERSTATE 91 OVER INTERSTATE 89

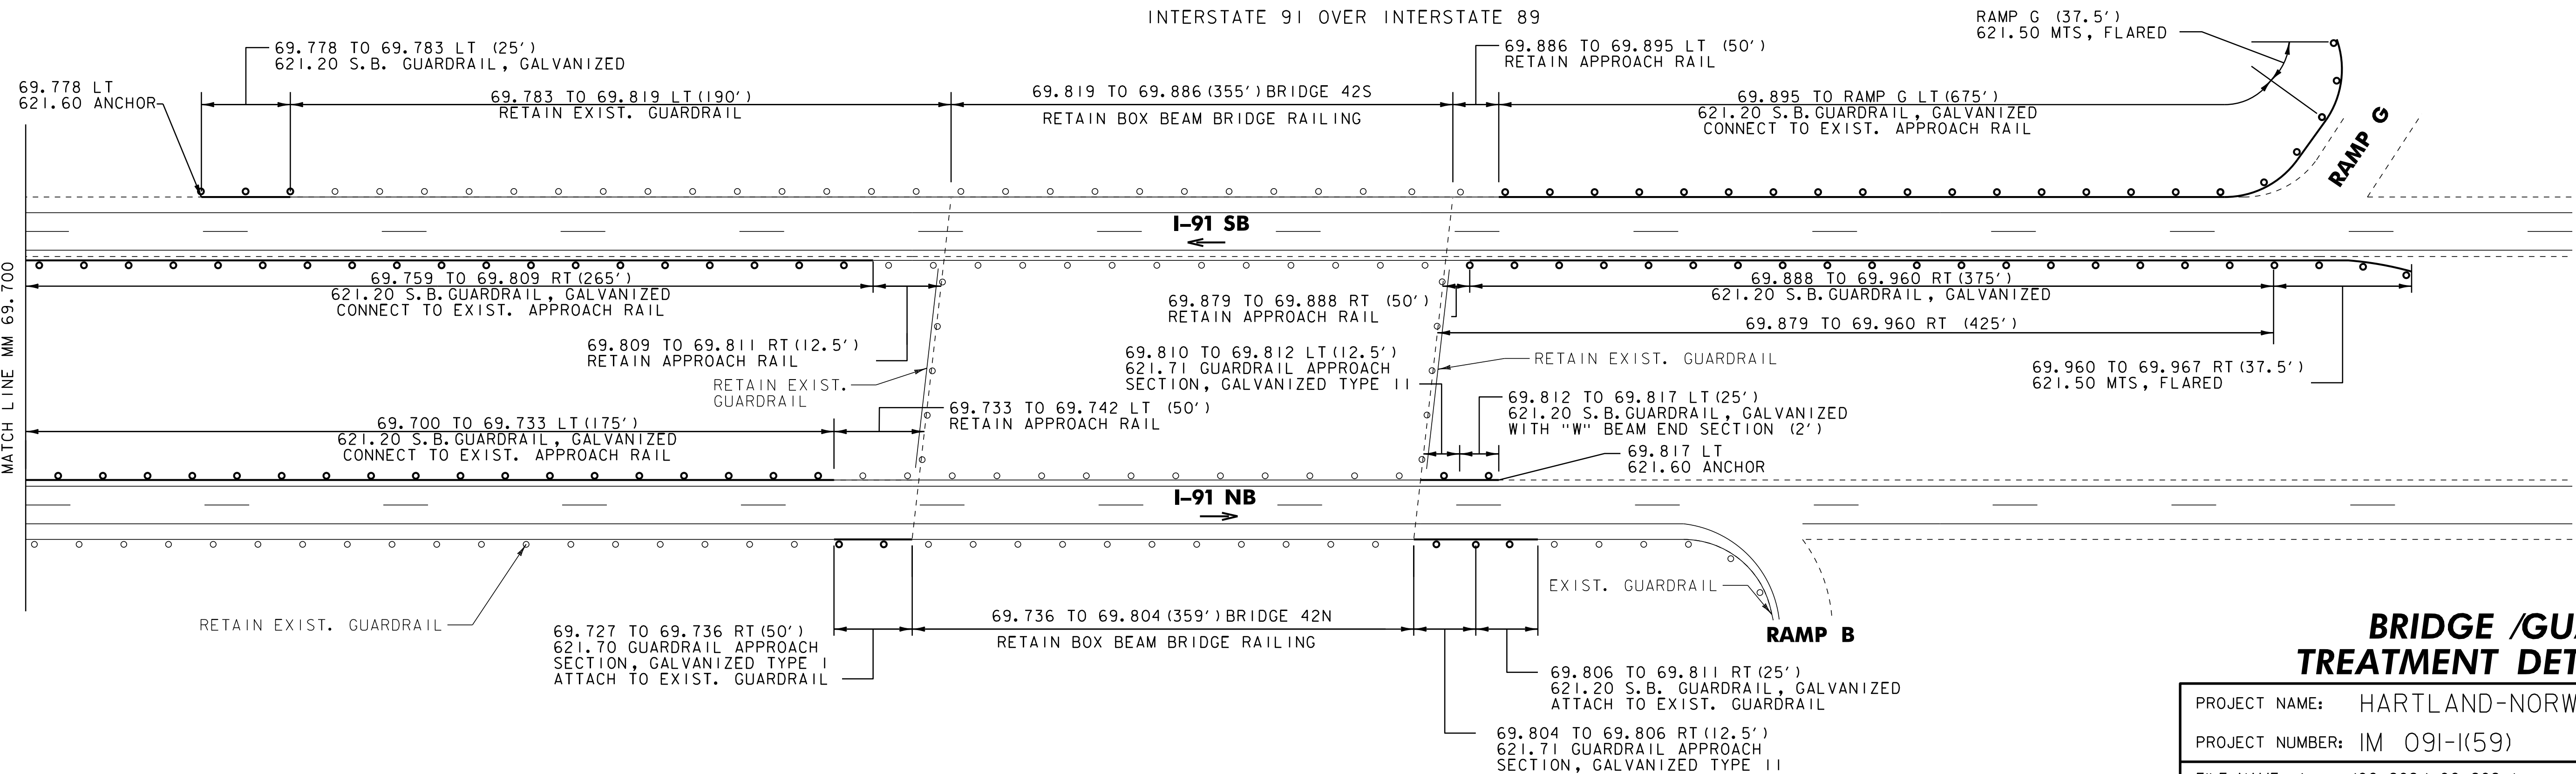

BRIDGE / GUARDRAIL TREATMENT DETAIL SHEET 2

PROJECT NAME: HARTLAND-NORWICH	FILE NAME: /pave/06a202/p06a202.dgn	PLOT DATE: 21-NOV-2012 11:45
PROJECT NUMBER: IM 091-I(59)	PROJECT LEADER: PTS	DRAWN BY: WWG
	DESIGNED BY: NULL	CHECKED BY: PTS
	IPARM FILE NAME: 06A202-48	SHEET 48 OF 60

• REFERENCE COMP. BINDER SECTION 621.XXX FOR GUARDRAIL SUMMARY SHEET

NOT TO SCALE