


GUARDRAIL TREATMENT - BRIDGE 48S

INTERSTATE 91 OVER VT ROUTE 10A


NOTE

I. SEE NOTE 16 ON SHEET 8.

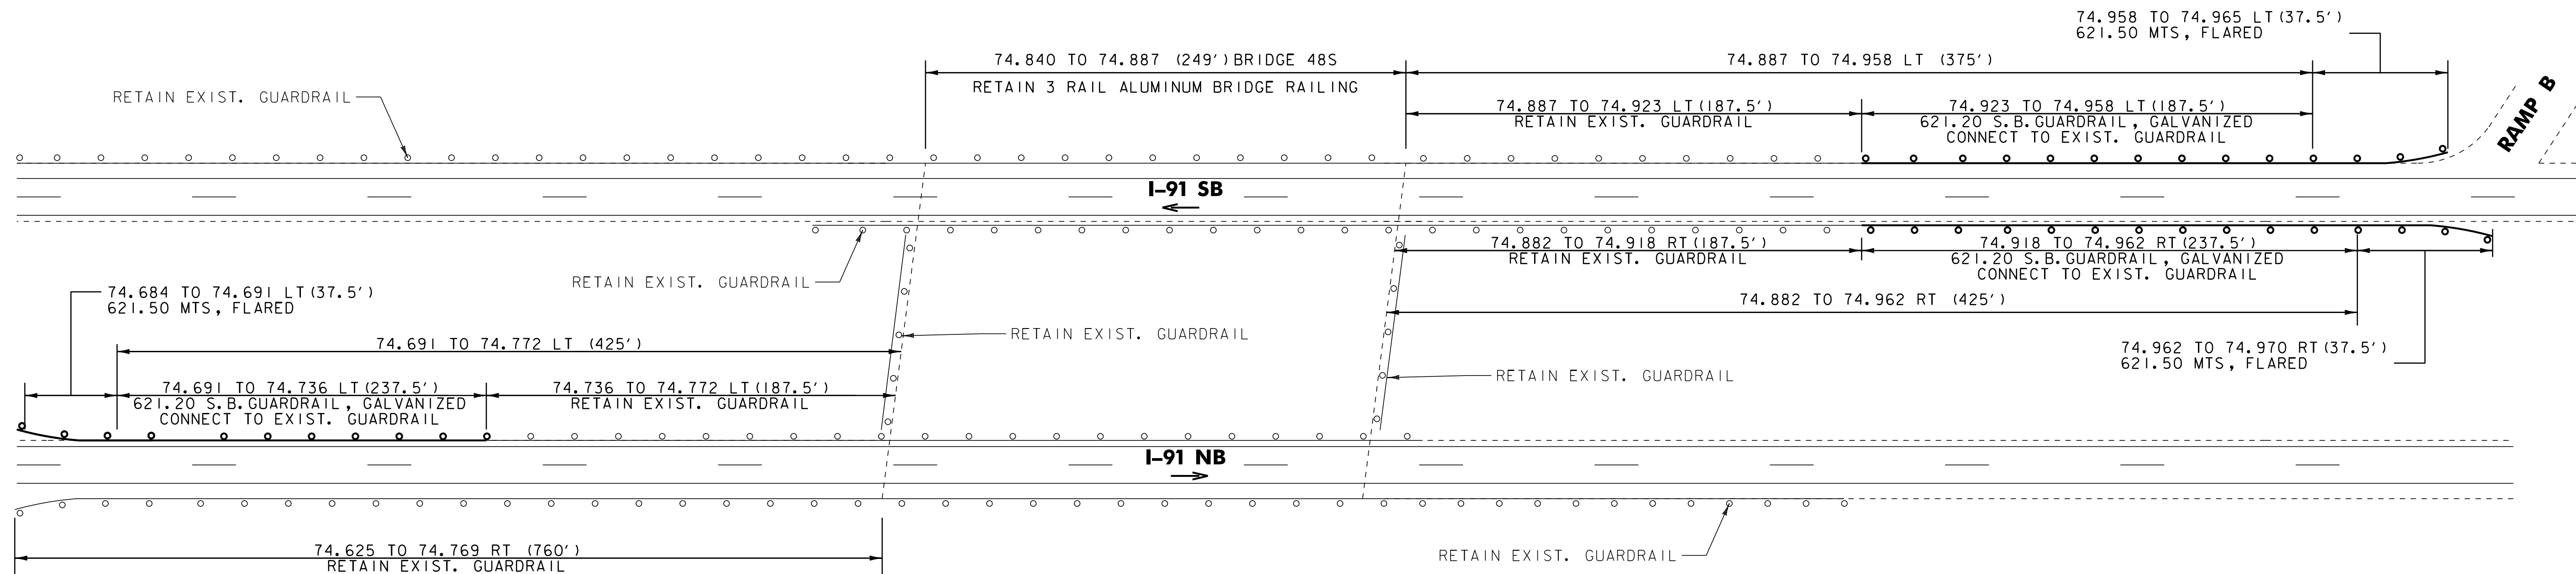

GUARDRAIL TREATMENT - BRIDGE 49S

INTERSTATE 91 OVER US ROUTE 5

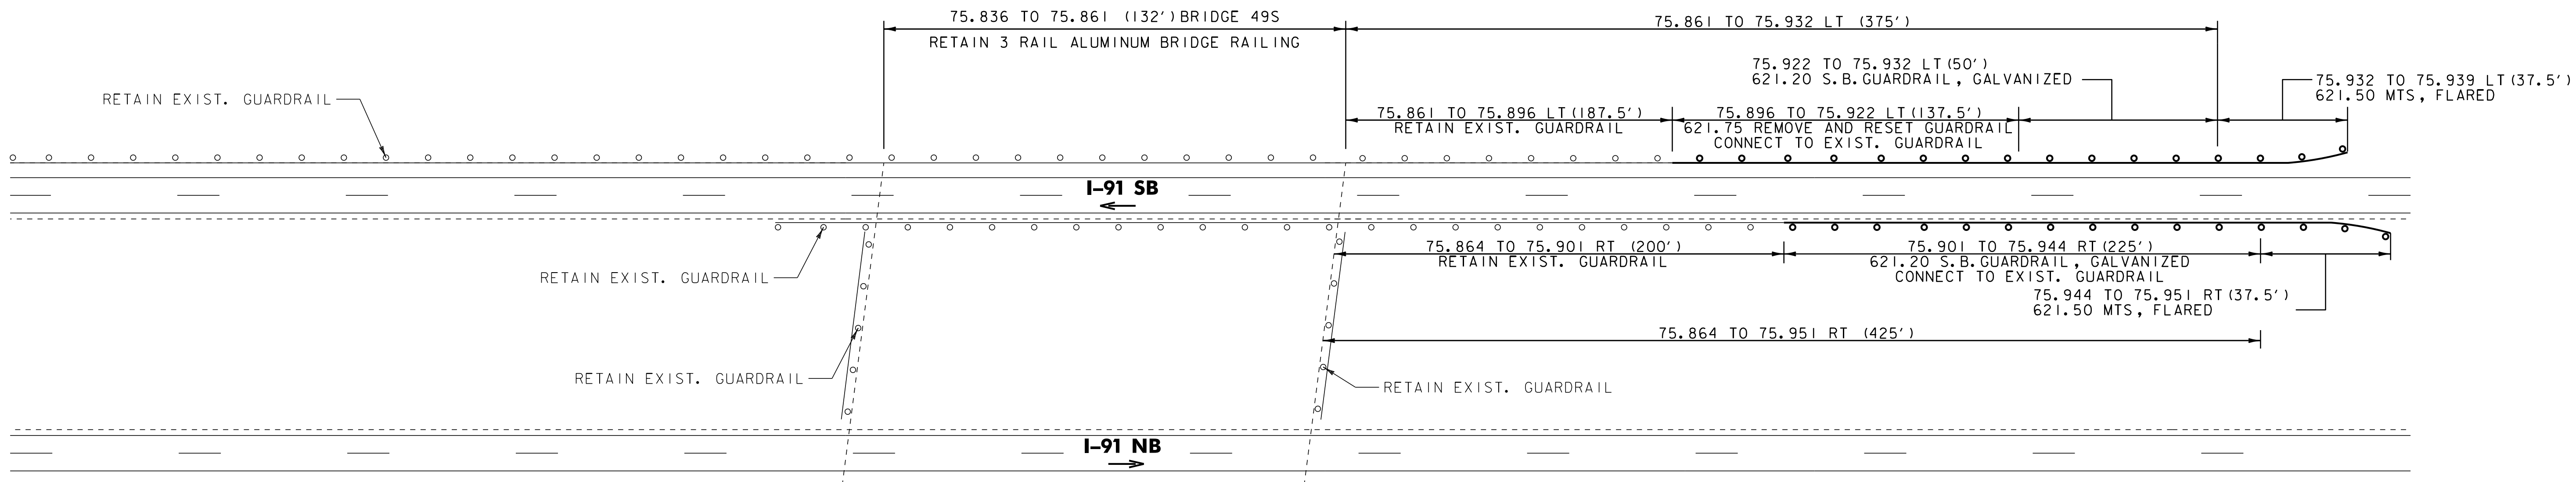

BRIDGE / GUARDRAIL TREATMENT DETAIL SHEET 5

PROJECT NAME: HARTLAND-NORWICH

PROJECT NUMBER: IM 091-I(59)

FILE NAME: /pave/06a202/p06a202.dgn

PLOT DATE: 21-NOV-2012 11:45

PROJECT LEADER: PTS

DRAWN BY: WWG

DESIGNED BY: NULL

CHECKED BY: PTS

IPARM FILE NAME: 06A202_51

SHEET 51 OF 60

* REFERENCE COMP. BINDER SECTION 621.XXX
FOR GUARDRAIL SUMMARY SHEET

NOT TO SCALE