


INTERSTATE ROUTE 91 NB
MM ~~66.195~~ 66.218
BEGIN PROJECT
HARTLAND-NORWICH
IM 091-1(59)

INTERSTATE ROUTE 91 NB
MM 74.762
END PROJECT
HARTLAND-NORWICH
IM 091-1(59)

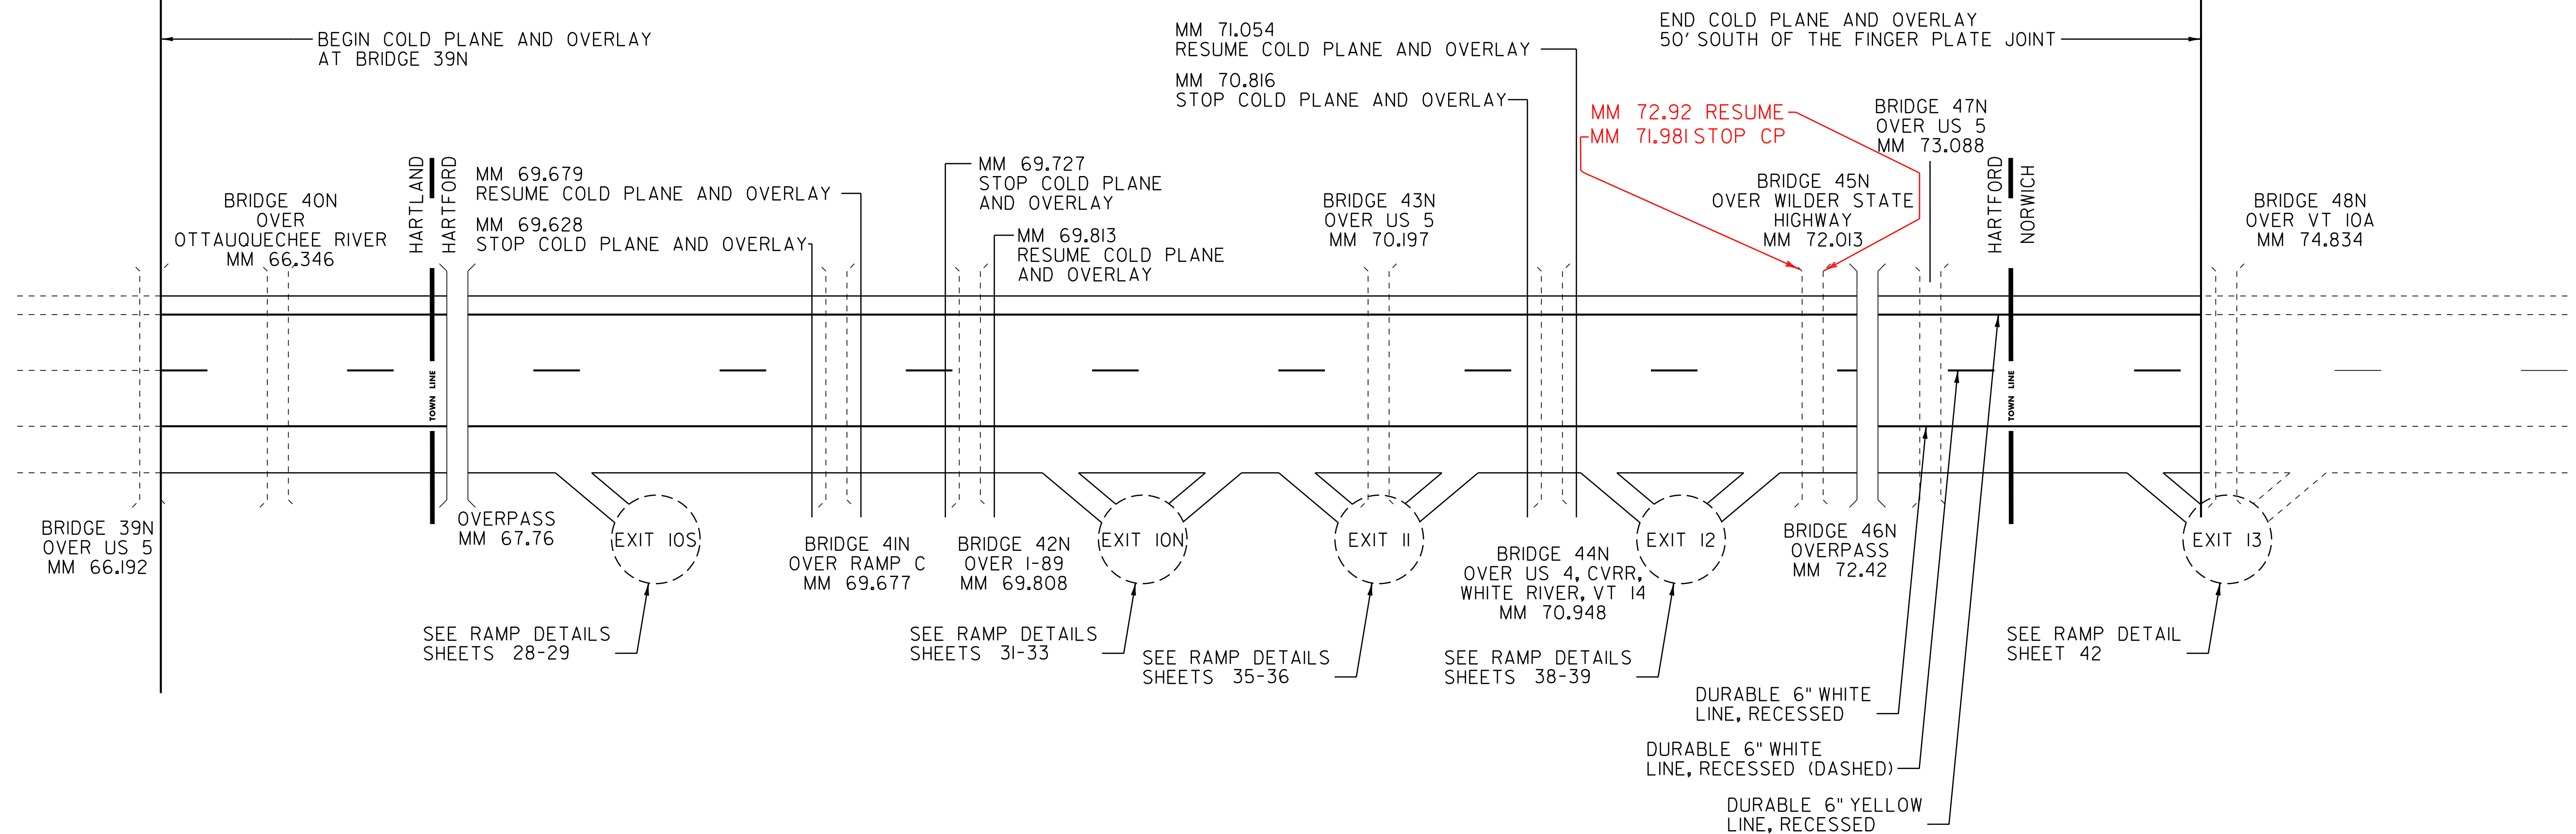

PAVEMENT CORES IN 10 FT SHOULDER

#	MM	DEPTH	PCC
1	66.45	1.75"	NO
2	68.45	2"	NO
3	70.75	4.75"	NO
4	71.45	6"	NO
5	72.30	5"	NO
6	73.05	5.0"	NO
7	73.15	4.0"	NO
8	73.25	5.0"	NO
9	73.35	5.25"	NO
10	73.45	5.75"	NO
11	73.55	4.875"	NO
12	73.65	3.25"	NO
13	73.75	3.375"	NO
14	73.85	3.375"	NO
15	73.95	3.25"	NO
16	74.05	3.375"	NO
17	74.15	3.75"	NO
18	74.25	3.5"	NO
19	74.35	3.625"	NO
20	74.45	3.375"	NO
21	74.525	3.5"	NO
22	74.70	3.0"	NO
23	74.80	8.5"	NO

201.31 THINNING AND TRIMMING FOR SIGNS

- 69.080 RT
- 72.715 RT
- 68.720 RT

604.412, 604.415 REHAB. DROP INLETS, CATCH BASINS, OR MANHOLES, CLASS I OR CLASS II

- 66.203 RT (DI)
- 66.851 RT (DI)
- 67.941 RT (DI)
- 67.993 RT (DI)
- 69.186 RT (DI)
- 69.683 RT (DI)
- 69.750 RT (DI)
- 69.804 RT (DI)
- 70.219 RT (DI)
- 71.228 RT (DI)
- 72.003 RT (DI)
- 72.743 RT (DI)
- 72.977 RT (DI)
- 73.034 RT (DI)
- 73.065 RT (DI)
- 73.112 LT & RT (DI)
- 73.145 RT (DI)
- 73.352 RT (DI)
- 73.428 RT (DI)
- 73.448 RT (DI)

*REFERENCE COMP. BINDER SECTION 604.XX FOR REHAB DI QUANTITY AND LOCATIONS

- 621.20 STEEL BEAM GUARDRAIL, GALVANIZED
- 621.205 STEEL BEAM GUARDRAIL, GALVANIZED W/8 FEET POSTS
- 621.50 MANUFACTURED TERMINAL SECTION, FLARED
- 621.51 MANUFACTURED TERMINAL SECTION, TANGENT
- 621.60 ANCHOR FOR STEEL BEAM RAIL
- 621.70 GUARDRAIL APPROACH SECTION, GALVANIZED TYPE I
- 621.71 GUARDRAIL APPROACH SECTION, GALVANIZED TYPE II
- 621.74 ALUMINUM APPROACH RAILING
- 621.75 REMOVE AND RESET GUARDRAIL
- 621.76 REPLACE GUARDRAIL POST ASSEMBLY
- 621.77 REPLACE GUARDRAIL BEAM UNIT
- 621.79 ADJUST HEIGHT OF GUARDRAIL
- 621.80 REMOVAL AND DISPOSAL OF GUARDRAIL
- 676.12 REMOVAL OF EXISTING DELINEATOR
- 900.620 SPECIAL PROVISION (STEEL BEAM GUARDRAIL DELINEATOR)
- 900.620 SPECIAL PROVISION (STEEL BEAM GUARDRAIL OFFSET BLOCK)
- 900.620 SPECIAL PROVISION (DELINEATOR WITH STEEL POST)
- SEE ITEM DETAIL SUMMARY SHEETS

*REFERENCE COMP. BINDER SECTION 621.XX FOR GUARDRAIL SUMMARY

- 646.622 TEMPORARY 6" WHITE LINE, PAINT
- 646.426 DURABLE 6" WHITE LINE, RECESSED POLYUREA
- 646.428 DURABLE 6" WHITE LINE, RECESSED THERMOPLASTIC
- 646.429 DURABLE 6" WHITE LINE, RECESSED EPOXY PAINT

- 66.195 TO 74.769 SOLID RT
- 66.195 TO 74.762 DASHED CL

- 646.632 TEMPORARY 6" YELLOW LINE, PAINT
- 646.436 DURABLE 6" YELLOW LINE, RECESSED POLYUREA
- 646.438 DURABLE 6" YELLOW LINE, RECESSED THERMOPLASTIC
- 646.439 DURABLE 6" YELLOW LINE, RECESSED EPOXY PAINT

- 66.195 TO 74.762 SOLID LT

*REFERENCE COMP. BINDER SECTION 646.XX FOR PAINT SUMMARY

613.10 STONE FILL, TYPE I

SEE DITCH CLEANING SHEET

620.75 SNOW BARRIER, GALVANIZED

- 70.197 LT & RT (140') BRIDGE 43 N 160'
- 70.948 LT & RT (222') BRIDGE 44 N 472'

NB MAINLINE LAYOUT

PROJECT NAME: HARTLAND-NORWICH
 PROJECT NUMBER: IM 091-1(59)

FILE NAME: /pave/06a202/p06a202.dgn PLOT DATE: 19-JUN-2013 09:24
 PROJECT LEADER: PTS DRAWN BY: WWG
 DESIGNED BY: NLL CHECKED BY: PTS
 IPARM FILE NAME: 06A202_26 SHEET 26 OF 60

NOT TO SCALE