


INTERSTATE ROUTE 91 SB
MM 66.453 66.459
BEGIN PROJECT
HARTLAND-NORWICH
IM 091-1(59)

INTERSTATE ROUTE 91 SB
MM 76.450
END PROJECT
HARTLAND-NORWICH
IM 091-1(59)

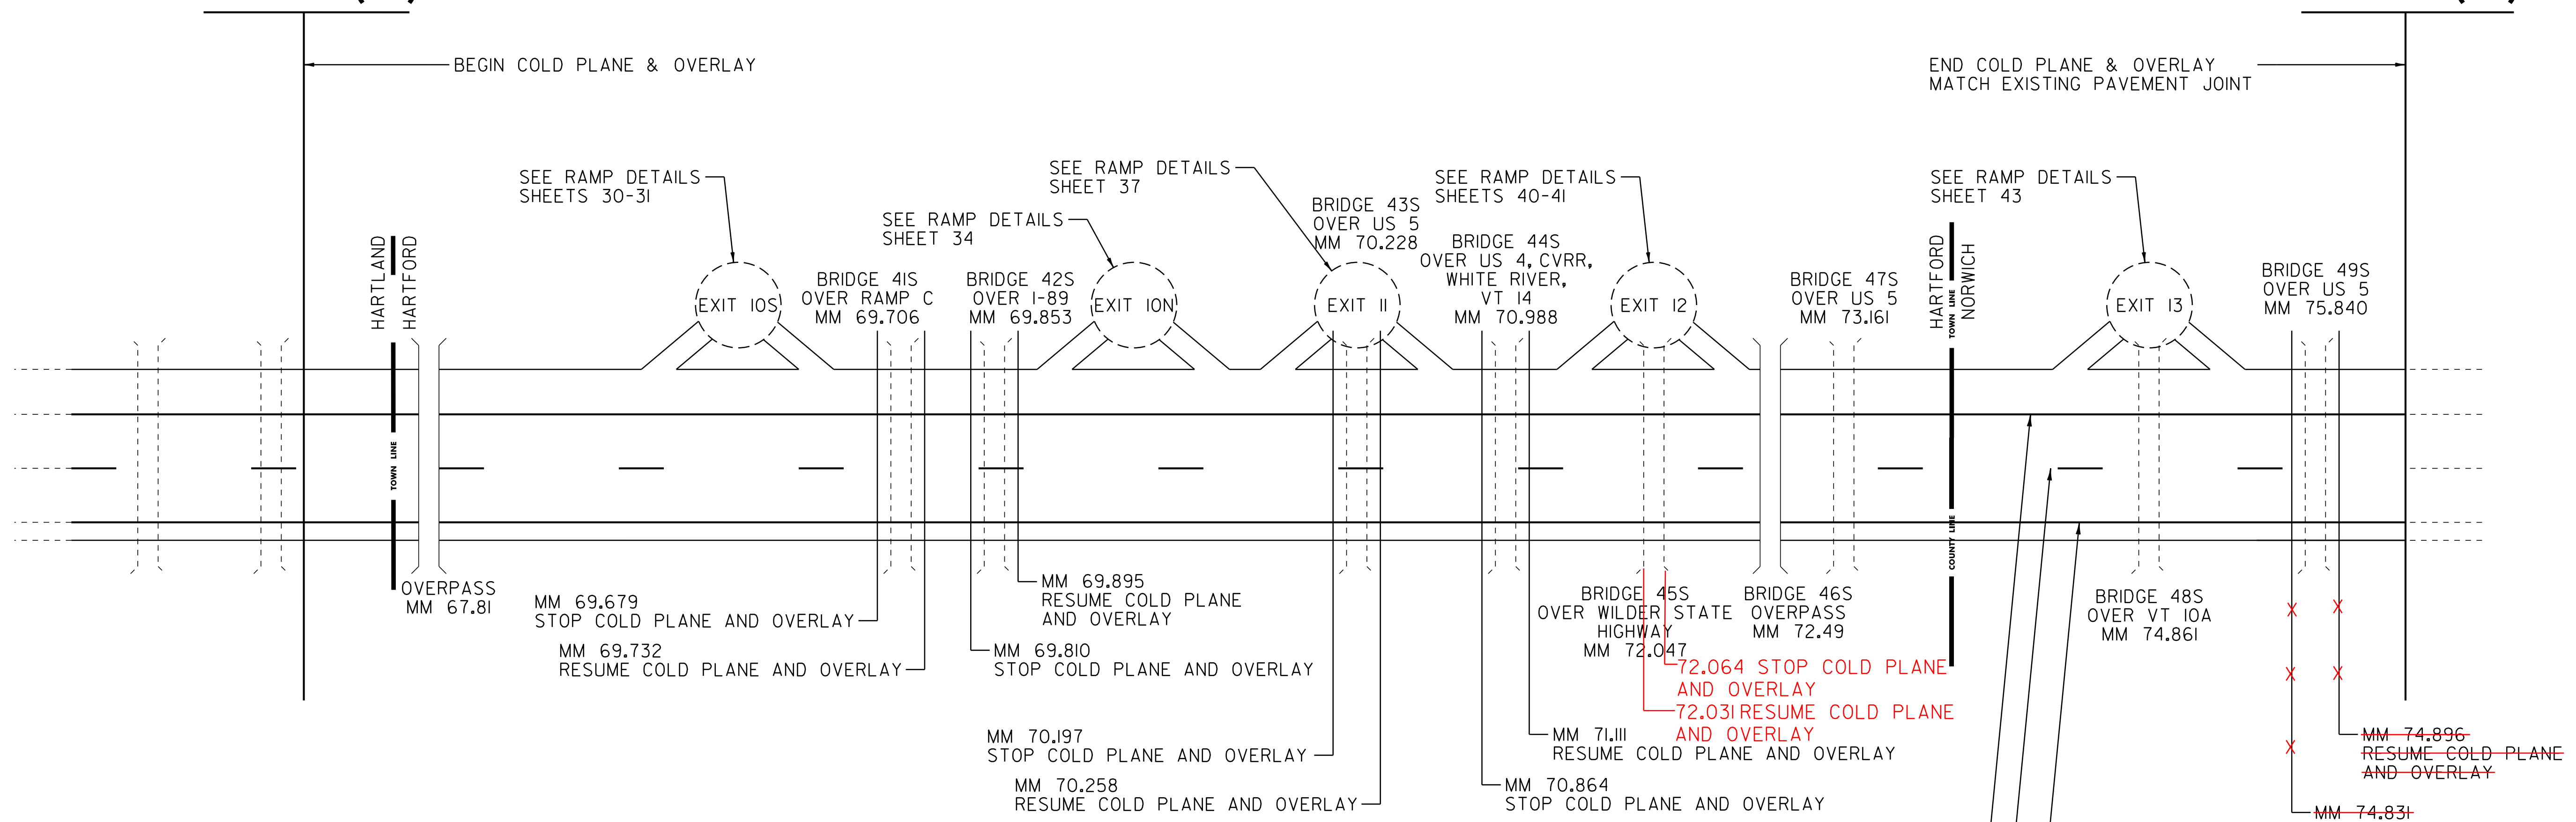

- 646.622 TEMPORARY 6" WHITE LINE, PAINT
- 646.426 DURABLE 6" WHITE LINE, RECESSED POLYUREA
- 646.428 DURABLE 6" WHITE LINE, RECESSED THERMOPLASTIC
- 646.429 DURABLE 6" WHITE LINE, RECESSED EPOXY PAINT
- 66.453 TO 76.450 SOLID LT
- 66.453 TO 76.450 DASHED CL

- 646.632 TEMPORARY 6" YELLOW LINE, PAINT
- 646.436 DURABLE 6" YELLOW LINE, RECESSED POLYUREA
- 646.438 DURABLE 6" YELLOW LINE, RECESSED THERMOPLASTIC
- 646.439 DURABLE 6" YELLOW LINE, RECESSED EPOXY PAINT
- 66.453 TO 76.450 SOLID RT

*REFERENCE COMP. BINDER SECTION 646.XXX FOR PAINT SUMMARY

201.3 THINNING AND TRIMMING FOR SIGNS

- 72.399 LT
- 72.874 LT
- 73.395 LT
- 75.703 LT

PAVEMENT CORES IN 10 FT SHOULDER

#	MM	DEPTH	PCC
24	76.35	6"	NO
25	74.15	6"	NO
26	72.75	5.5"	NO
27	70.30	3.75"	NO
28	69.10	3.5"	NO
29	68.05	7"	NO
30	66.85	4"	NO

604.412, 604.415 REHAB. DROP INLETS, CATCH BASINS, OR MANHOLES, CLASS I OR CLASS II

- 66.497 LT (DI)
- 66.510 LT (DI)
- 66.552 LT (DI)
- 66.717 LT (DI)
- 66.754 LT (DI)
- 66.800 LT (DI)
- 67.520 LT (DI)
- 69.239 LT (DI)
- 69.881 LT (DI)
- 70.203 RT (DI)
- 70.255 RT (DI)
- 71.105 RT (DI)
- 72.045 LT (DI)
- 72.066 LT & RT (DI)
- 72.102 LT (DI)
- 73.137 LT (DI)
- 73.185 LT & RT (DI)
- 73.203 LT (DI)
- 73.447 LT (DI)
- 73.513 LT (DI)
- 73.674 LT (DI)
- 73.729 LT (DI)
- 73.777 LT (DI)
- 74.754 LT (DI)
- 74.802 LT (DI)
- 74.832 LT & RT (DI)
- 74.889 LT (DI)
- 75.870 LT (DI)

*REFERENCE COMP. BINDER SECTION 604.XXX FOR REHAB DIQUANTITIES AND LOCATION

- 621.20 STEEL BEAM GUARDRAIL, GALVANIZED
- 621.50 MANUFACTURED TERMINAL SECTION, FLARED
- 621.51 MANUFACTURED TERMINAL SECTION, TANGENT
- 621.60 ANCHOR FOR STEEL BEAM RAIL
- 621.74 ALUMINUM APPROACH RAILING
- 621.75 REMOVE AND RESET GUARDRAIL
- 621.76 REPLACE GUARDRAIL POST ASSEMBLY
- 621.77 REPLACE GUARDRAIL BEAM UNIT
- 621.79 ADJUST HEIGHT OF GUARDRAIL
- 621.80 REMOVAL AND DISPOSAL OF GUARDRAIL
- 676.J2 REMOVAL OF EXISTING DELINEATOR
- 900.620 SPECIAL PROVISION (STEEL BEAM GUARDRAIL DELINEATOR)
- 900.620 SPECIAL PROVISION (STEEL BEAM GUARDRAIL OFFSET BLOCK)
- 900.620 SPECIAL PROVISION (DELINEATOR WITH STEEL POST)

SEE ITEM DETAIL SUMMARY SHEETS

*REFERENCE COMP. BINDER SECTION 621.XXX FOR GUARDRAIL SUMMARY

613.10 STONE FILL, TYPE I
 SEE DITCH CLEANING SHEET

620.75 SNOW BARRIER, GALVANIZED

- 70.228 LT & RT (140') BRIDGE 43 S 156'
- 70.948 LT & RT (222') BRIDGE 44 S 472'

NOT TO SCALE

SB MAINLINE LAYOUT

PROJECT NAME: HARTLAND-NORWICH	FILE NAME: /pave/06a202/p06a202.dgn	PLOT DATE: 19-JUN-2013 09:24
PROJECT NUMBER: IM 091-1(59)	PROJECT LEADER: PTS	DRAWN BY: WWG
	DESIGNED BY: NULL	CHECKED BY: PTS
	IPARM FILE NAME: 06A202_27	SHEET 27 OF 60