
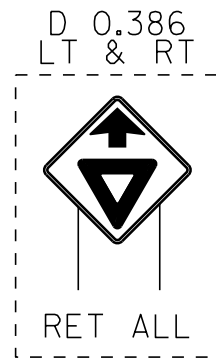


MATCH LINE D0.200  
SEE SHEET 28

646.622 TEMPORARY 6" WHITE LINE, PAINT  
 646.426 DURABLE 6" WHITE LINE, RECESSED POLYUREA  
 646.428 DURABLE 6" WHITE LINE, RECESSED THERMOPLASTIC  
 646.429 DURABLE 6" WHITE LINE, RECESSED EPOXY PAINT  
 D 0.200 TO D 0.498 SOLID RT

646.632 TEMPORARY 6" YELLOW LINE, PAINT  
 646.436 DURABLE 6" YELLOW LINE, RECESSED POLYUREA  
 646.438 DURABLE 6" YELLOW LINE, RECESSED THERMOPLASTIC  
 646.439 DURABLE 6" YELLOW LINE, RECESSED EPOXY PAINT  
 D 0.200 TO D 0.498 SOLID LT

~~646.692 TEMPORARY LETTER OR SYMBOL, PAINT~~  
 646.492 DURABLE LETTER OR SYMBOL, THERMOPLASTIC  
 646.493 DURABLE LETTER OR SYMBOL, EPOXY PAINT  
 D 0.382 LT "YIELD"  
 D 0.390 LT "AHEAD"  
 D 0.474 LT YIELD MARKINGS (5 EA.)

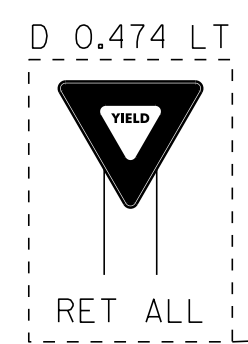

RETAIN EXISTING  
GUARDRAIL

**END COLD PLANE & OVERLAY  
RAMP D MM 0.498**

NOT TO SCALE

**LEGEND**

R	=	REMOVE EXISTING
S	=	SALVAGE
R&S	=	REMOVE AND SALVAGE
N	=	NEW
RET	=	RETAIN
B-B	=	BACK TO BACK
	=	EXISTING GUARDRAIL
	=	PROPOSED GUARDRAIL
YL	=	YELLOW LINE
WL	=	WHITE LINE

**EXIT 10  
NB OFF RAMP D DETAIL SHEET 2**

PROJECT NAME: HARTLAND-NORWICH	FILE NAME: /pave/06a202/p06a202.dgn	PLOT DATE: 19-JUN-2013 09:24
PROJECT NUMBER: IM 091-I(59)	PROJECT LEADER: PTS	DRAWN BY: WWG
	DESIGNED BY: NLL	CHECKED BY: PTS
	IPARM FILE NAME: 06A202_29	SHEET 29 OF 60