

646.622 TEMPORARY 6" WHITE LINE, PAINT
 646.426 DURABLE 6" WHITE LINE, RECESSED POLYUREA
 646.428 DURABLE 6" WHITE LINE, RECESSED THERMOPLASTIC
 646.429 DURABLE 6" WHITE LINE, RECESSED EPOXY PAINT

C 0.087 TO C 0.295 SOLID RT
 C 0.324 TO C 0.480 SOLID RT
 E 0.000 TO E 0.060 SOLID RT
 F 0.018 TO F 0.252 SOLID RT

646.632 TEMPORARY 6" YELLOW LINE, PAINT
 646.436 DURABLE 6" YELLOW LINE, RECESSED POLYUREA
 646.438 DURABLE 6" YELLOW LINE, RECESSED THERMOPLASTIC
 646.439 DURABLE 6" YELLOW LINE, RECESSED EPOXY PAINT

C 0.087 TO C 0.480 SOLID LT
 E 0.028 TO E 0.060 SOLID LT
 F 0.018 TO F 0.252 SOLID LT


613.10 STONE FILL, TYPE I
 F 0.037 RT
 F 0.071 RT
 F 0.152 RT
 F 0.234 RT

646.662 TEMPORARY 12" WHITE LINE, PAINT
 646.466 DURABLE 12" WHITE LINE, RECESSED POLYUREA
 646.469 DURABLE 12" WHITE LINE, RECESSED EPOXY PAINT

C 0.319 TO C 0.324 SOLID RT
 E 0.023 TO E 0.028 SOLID LT
 F 0.009 TO F 0.018 SOLID LT
 F 0.009 TO F 0.018 SOLID LT (GORE STRIPES)
 69.754 TO 69.773 SOLID LT

621.20 STEEL BEAM GUARDRAIL, GALVANIZED
 621.50 MANUFACTURED TERMINAL SECTION, FLARED
 621.80 REMOVAL AND DISPOSAL OF GUARDRAIL
 SEE ITEM DETAIL SUMMARY SHEETS

•REFERENCE COMP. BINDER SECTION 621.XXX
 FOR GUARDRAIL SUMMARY

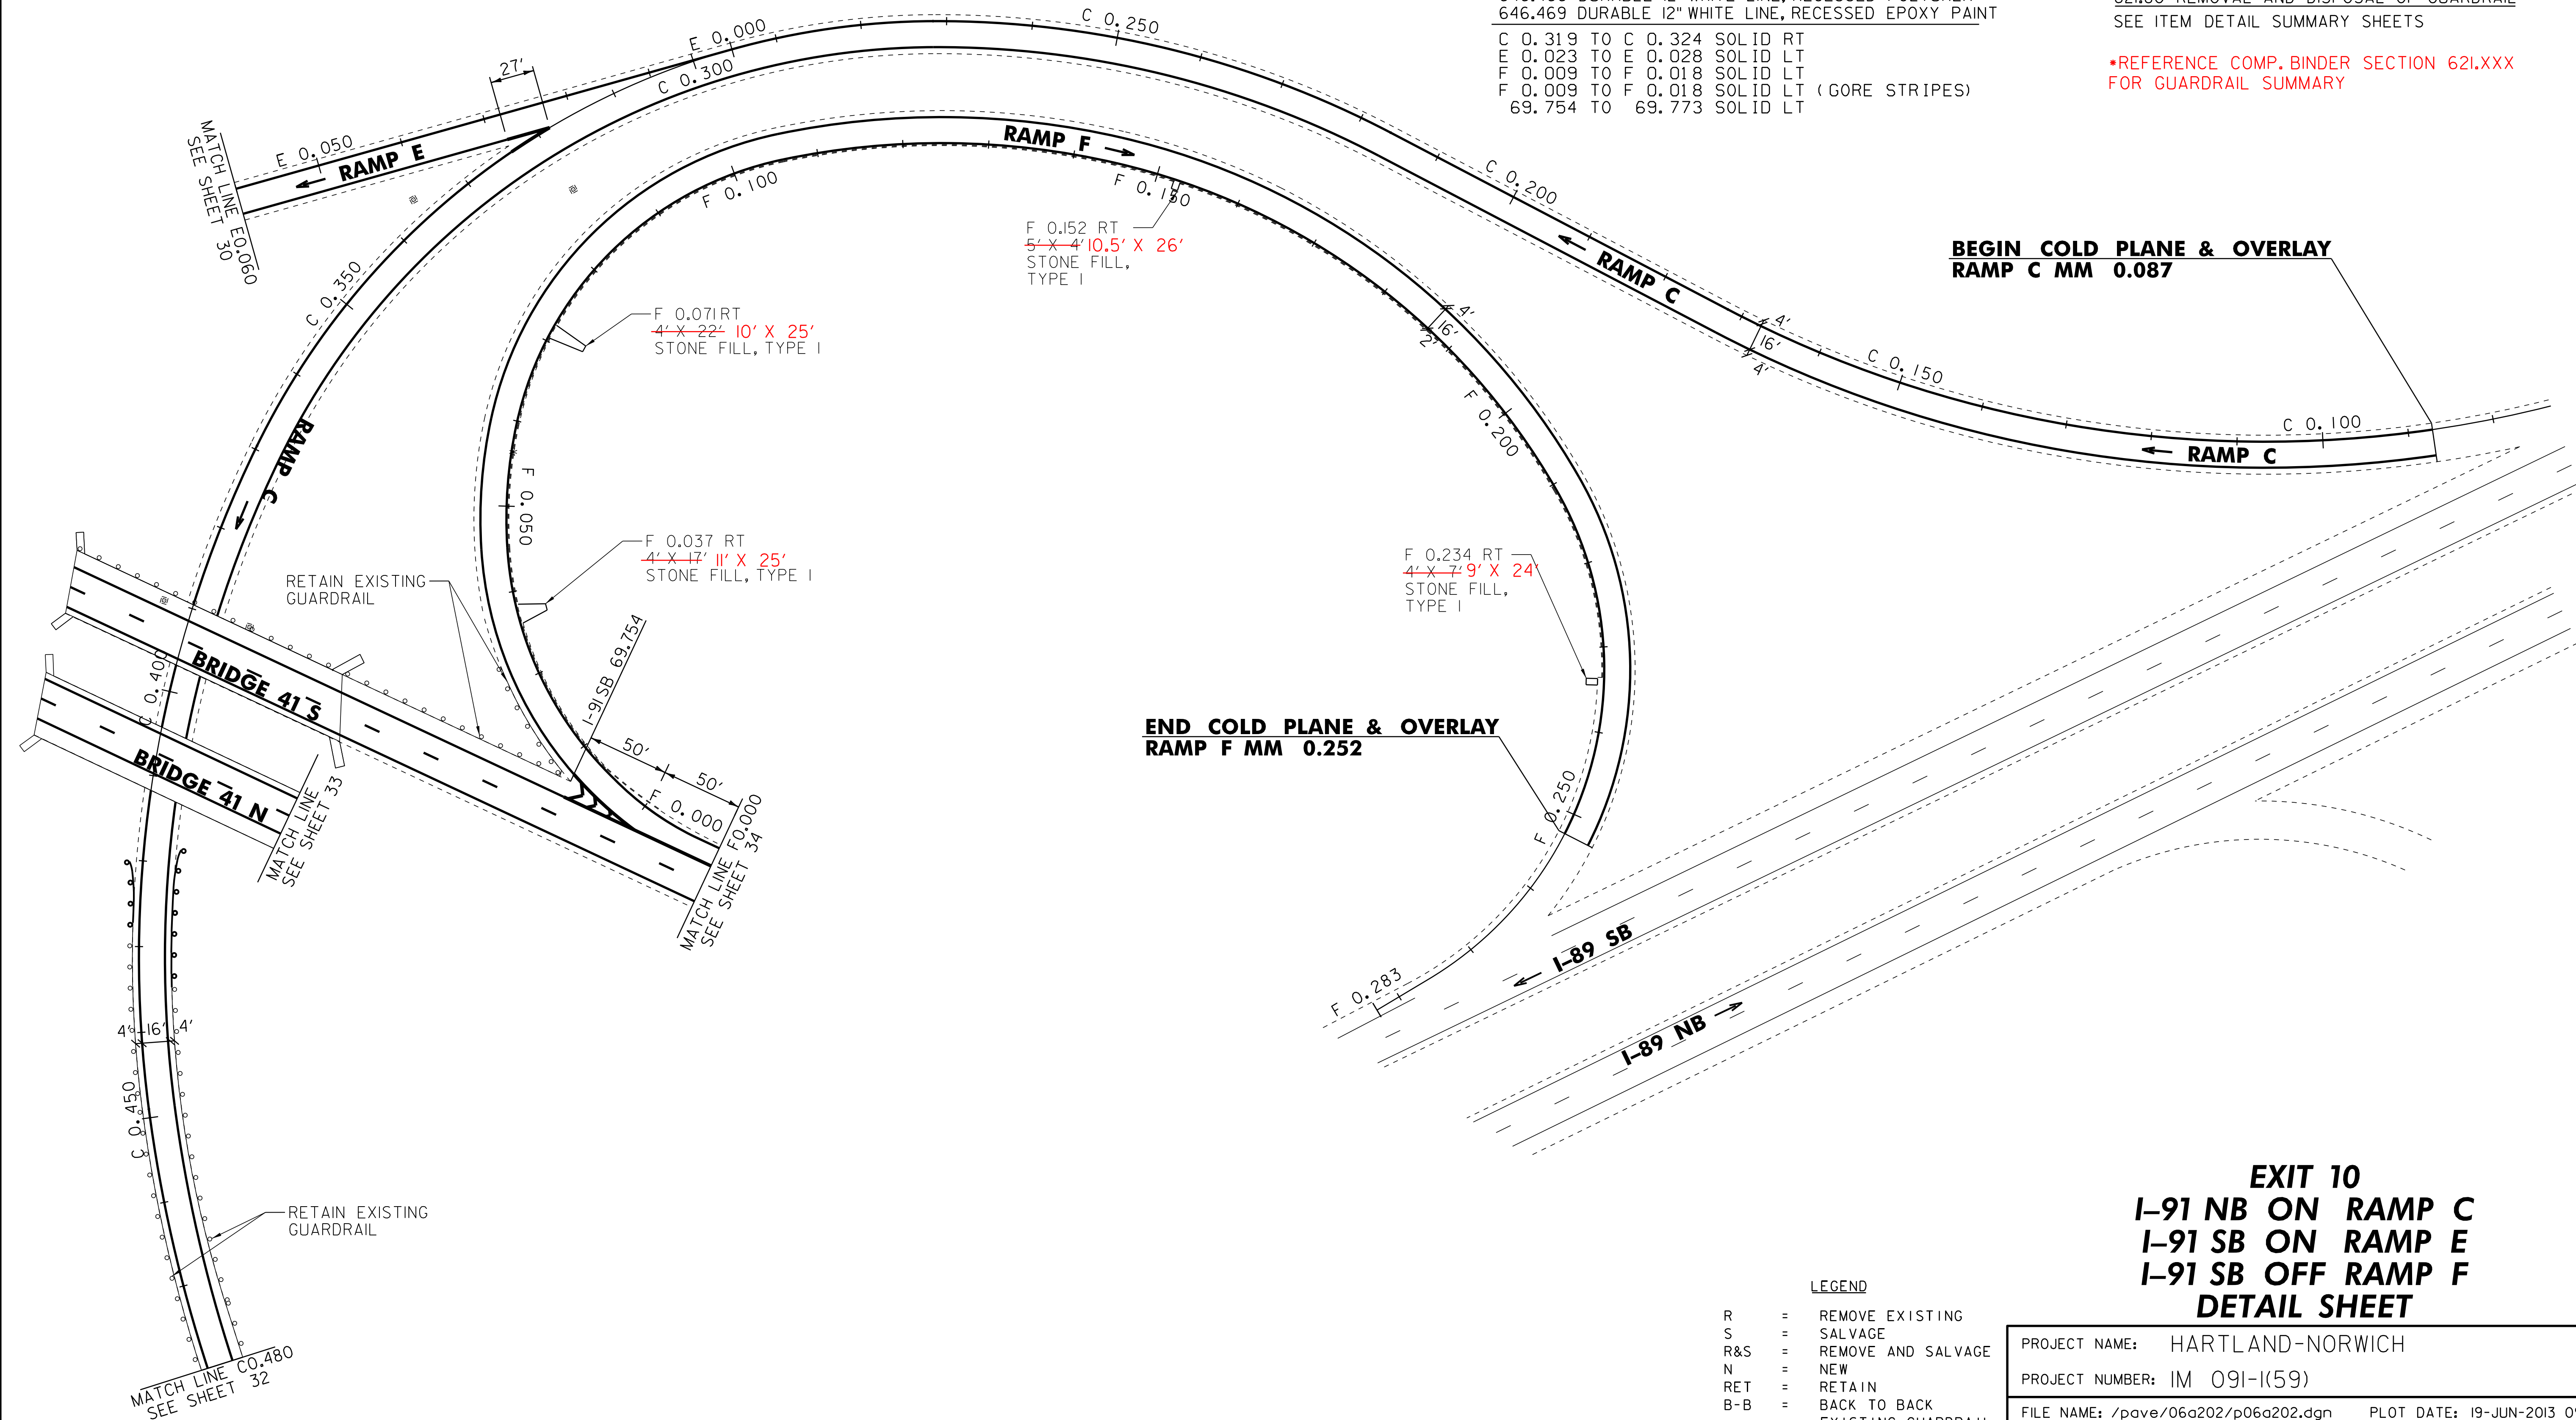

NOT TO SCALE

LEGEND

- R = REMOVE EXISTING
- S = SALVAGE
- R&S = REMOVE AND SALVAGE
- N = NEW
- RET = RETAIN
- B-B = BACK TO BACK
- = EXISTING GUARDRAIL
- = PROPOSED GUARDRAIL
- YL = YELLOW LINE
- WL = WHITE LINE

EXIT 10
I-91 NB ON RAMP C
I-91 SB ON RAMP E
I-91 SB OFF RAMP F
DETAIL SHEET

PROJECT NAME:	HARTLAND-NORWICH	
PROJECT NUMBER:	IM 091-I(59)	
FILE NAME:	/pave/06a202/p06a202.dgn	PLOT DATE: 19-JUN-2013 09:24
PROJECT LEADER:	PTS	DRAWN BY: WWG
DESIGNED BY:	NLL	CHECKED BY: PTS
IPARM FILE NAME:	06A202_31	SHEET 31 OF 60