


646.662 TEMPORARY 12" WHITE LINE, PAINT  
 646.466 DURABLE 12" WHITE LINE, RECESSED POLYUREA  
 646.466 DURABLE 12" WHITE LINE, RECESSED EPOXY PAINT  
 69.773 TO 69.952 DOTTED LT  
 69.952 TO 69.974 SOLID LT  
 69.961 TO 69.974 SOLID LT (RAMP G)  
 70.083 TO 70.115 SOLID LT  
 70.083 TO 70.106 SOLID LT (RAMP H)  
 70.083 TO 70.106 SOLID LT (GORE STRIPES)  
 70.115 TO 70.275 DOTTED LT

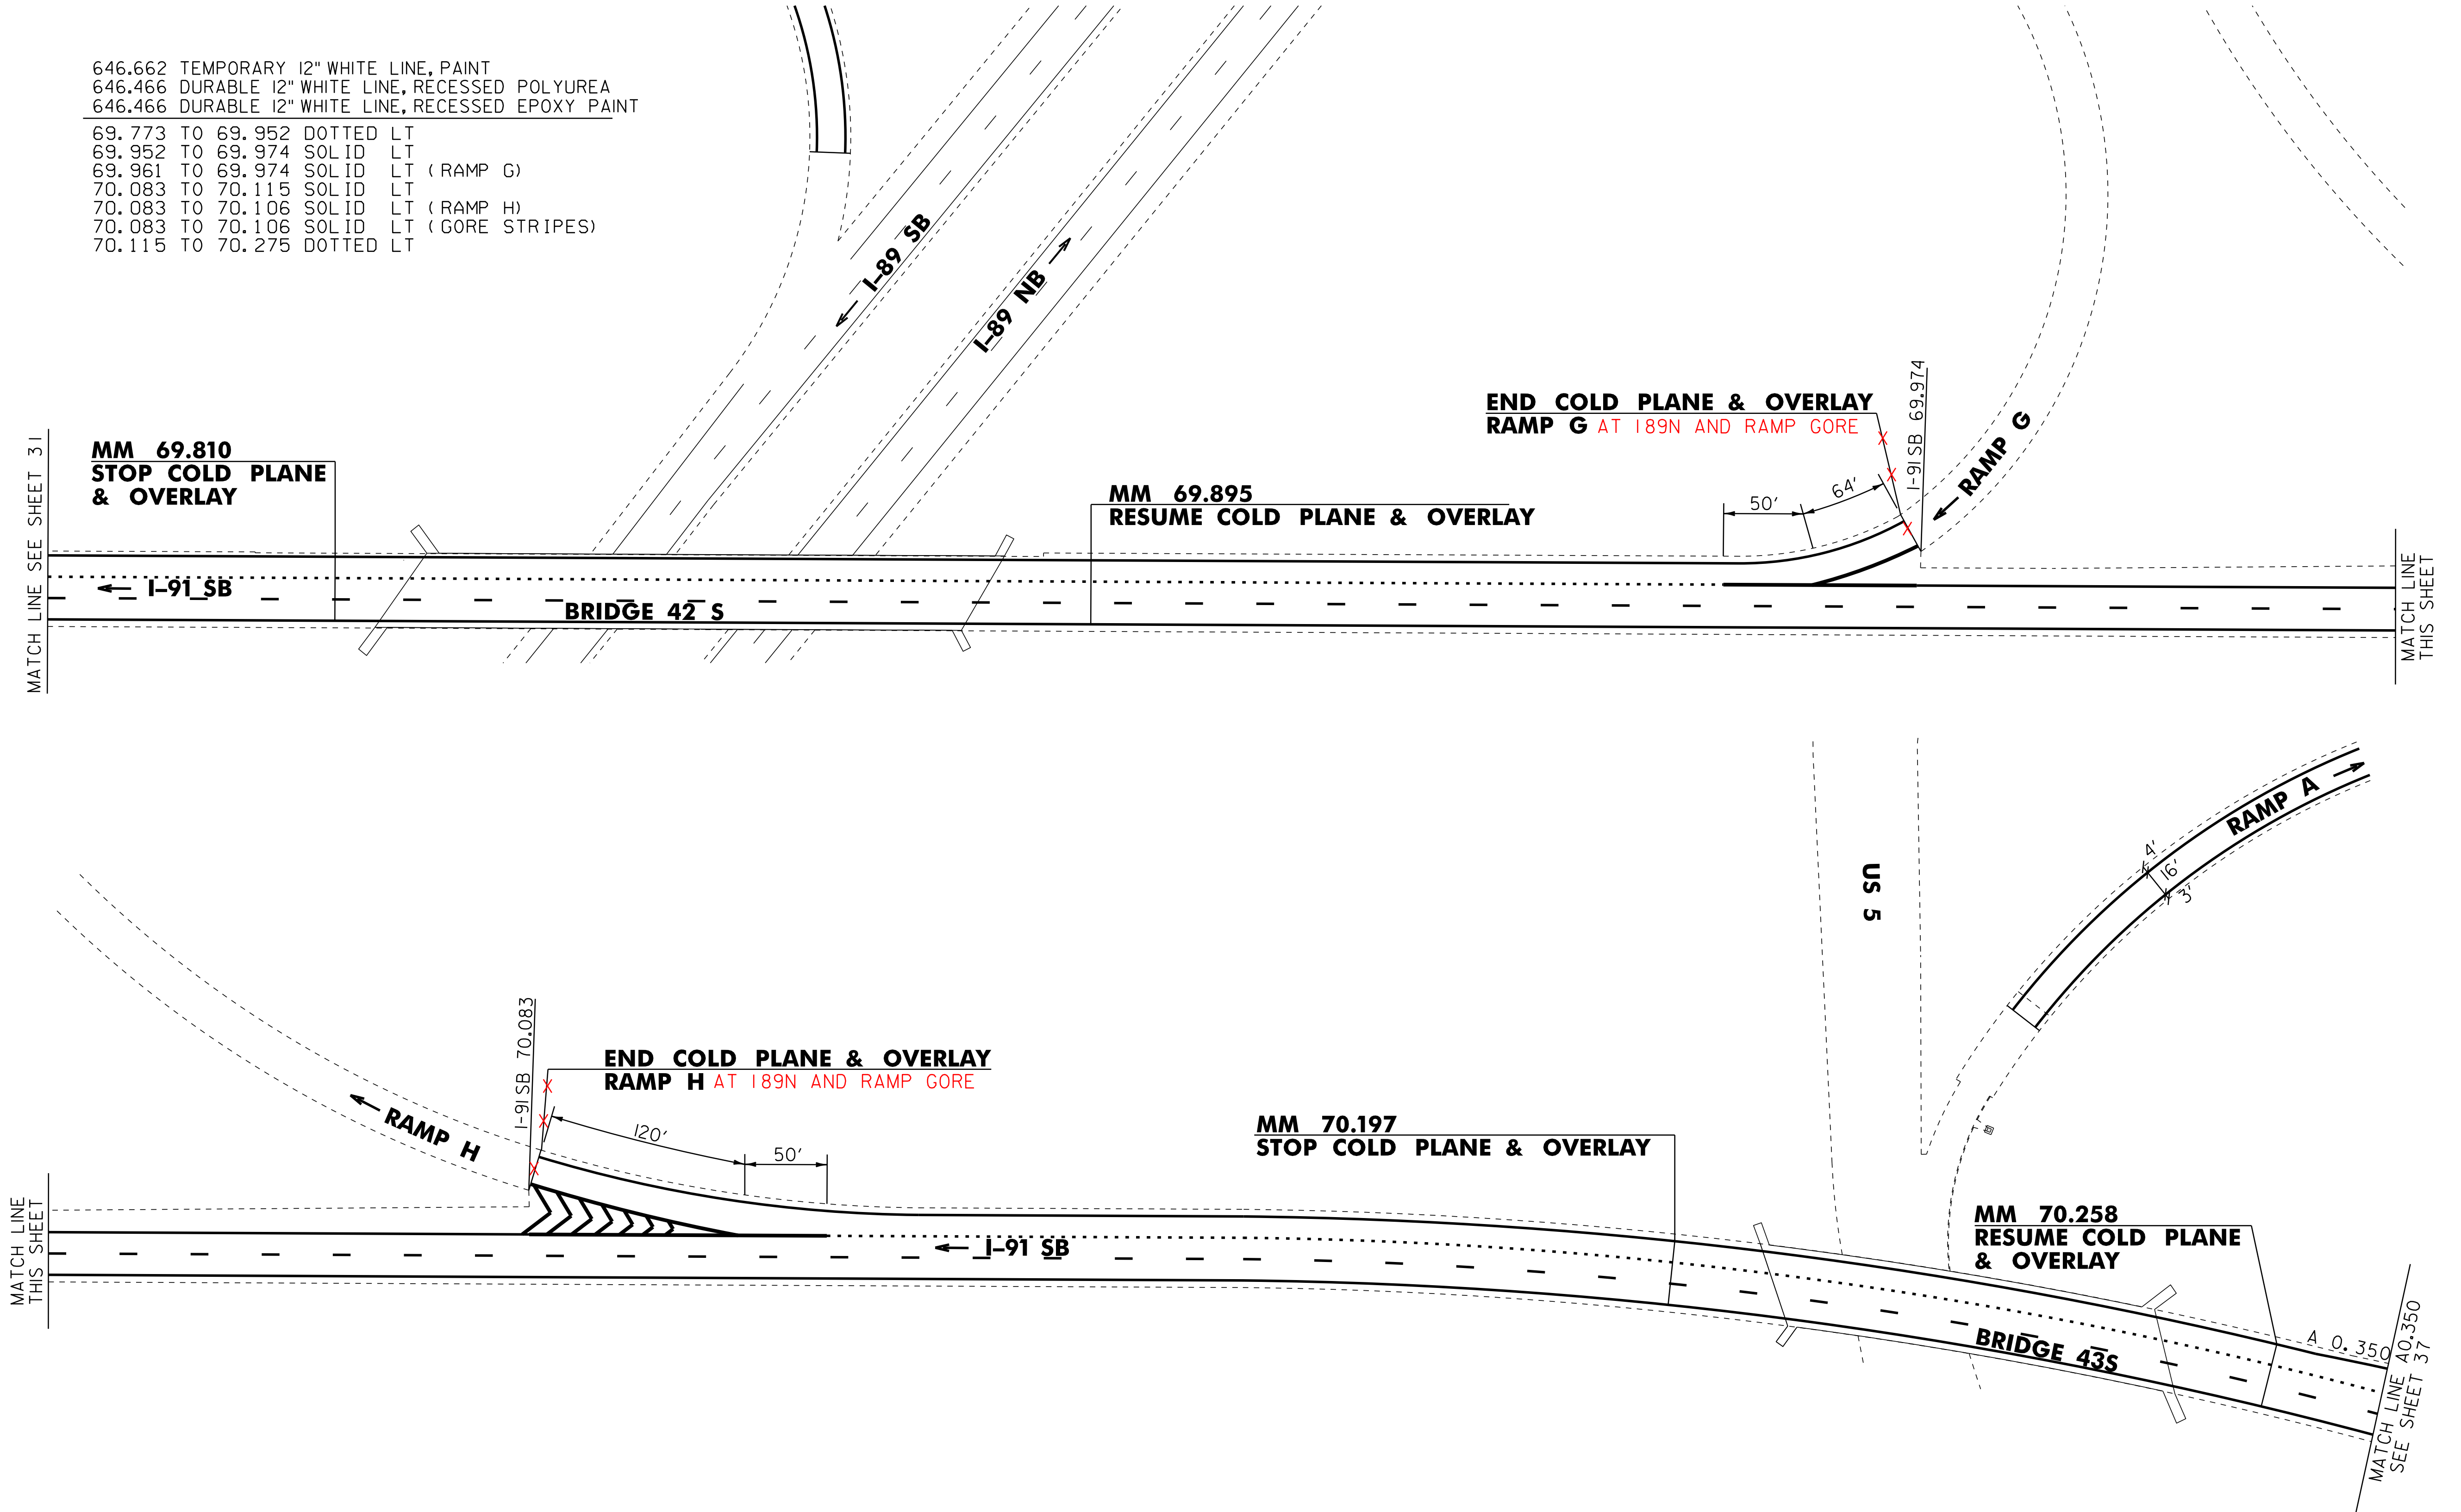

NOT TO SCALE

**LEGEND**

R	=	REMOVE EXISTING
S	=	SALVAGE
R&S	=	REMOVE AND SALVAGE
N	=	NEW
RET	=	RETAIN
B-B	=	BACK TO BACK
	=	EXISTING GUARDRAIL
	=	PROPOSED GUARDRAIL
YL	=	YELLOW LINE
WL	=	WHITE LINE

**EXIT 10 & 11  
WEAVE LANE DETAIL SHEET**

PROJECT NAME: HARTLAND-NORWICH	FILE NAME: /pave/06a202/p06a202.dgn	PLOT DATE: 19-JUN-2013 09:24
PROJECT NUMBER: IM 091-I(59)	PROJECT LEADER: PTS	DRAWN BY: WWG
	DESIGNED BY: NLL	CHECKED BY: PTS
	IPARM FILE NAME: 06A202_34	SHEET 34 OF 60