

646.622 TEMPORARY 6" WHITE LINE, PAINT
 646.426 DURABLE 6" WHITE LINE, RECESSED POLYUREA
 646.428 DURABLE 6" WHITE LINE, RECESSED THERMOPLASTIC
 646.429 DURABLE 6" WHITE LINE, RECESSED EPOXY PAINT

C 0.041 TO C 0.192 SOLID RT
 C 0.153 TO C 0.157 SOLID LT

646.632 TEMPORARY 6" YELLOW LINE, PAINT
 646.436 DURABLE 6" YELLOW LINE, RECESSED POLYUREA
 646.438 DURABLE 6" YELLOW LINE, RECESSED THERMOPLASTIC
 646.439 DURABLE 6" YELLOW LINE, RECESSED EPOXY PAINT

C 0.041 TO C 0.154 SOLID LT
 C 0.153 TO C 0.179 SOLID LT

646.662 TEMPORARY 12" WHITE LINE, PAINT
 646.466 DURABLE 12" WHITE LINE, RECESSED POLYUREA
 646.469 DURABLE 12" WHITE LINE, RECESSED EPOXY PAINT

C 0.023 TO C 0.041 SOLID LT
 C 0.139 TO C 0.153 SOLID LT
 C 0.146 TO C 0.153 SOLID LT
 C 0.146 TO C 0.153 SOLID LT (GORE STRIPES)
 69.910 TO 70.080 DOTTED RT
 70.080 TO 70.109 SOLID RT
 70.090 TO 70.109 SOLID RT (GORE STRIPES)

646.692 ~~TEMPORARY LETTER OR SYMBOL, PAINT~~
 646.492 DURABLE LETTER OR SYMBOL, THERMOPLASTIC
 646.493 DURABLE LETTER OR SYMBOL, EPOXY PAINT


C 0.132 LT WRONG WAY ARROW
 C 0.155 LT "STOP"

646.682 TEMPORARY 24" STOP BAR, PAINT
 646.482 DURABLE 24" STOP BAR, THERMOPLASTIC
 646.483 DURABLE 24" STOP BAR, EPOXY PAINT

A 0.153 TO A 0.156 LT

604.412, 604.415 REHAB.
 DROP INLETS, CATCH BASINS, OR MANHOLES,
 CLASS I OR CLASS II
 C 0.141 RT (OTDI)

* REFERENCE COMP. BINDER SECTION 604.XXX
 FOR REHAB DILOCATIONS

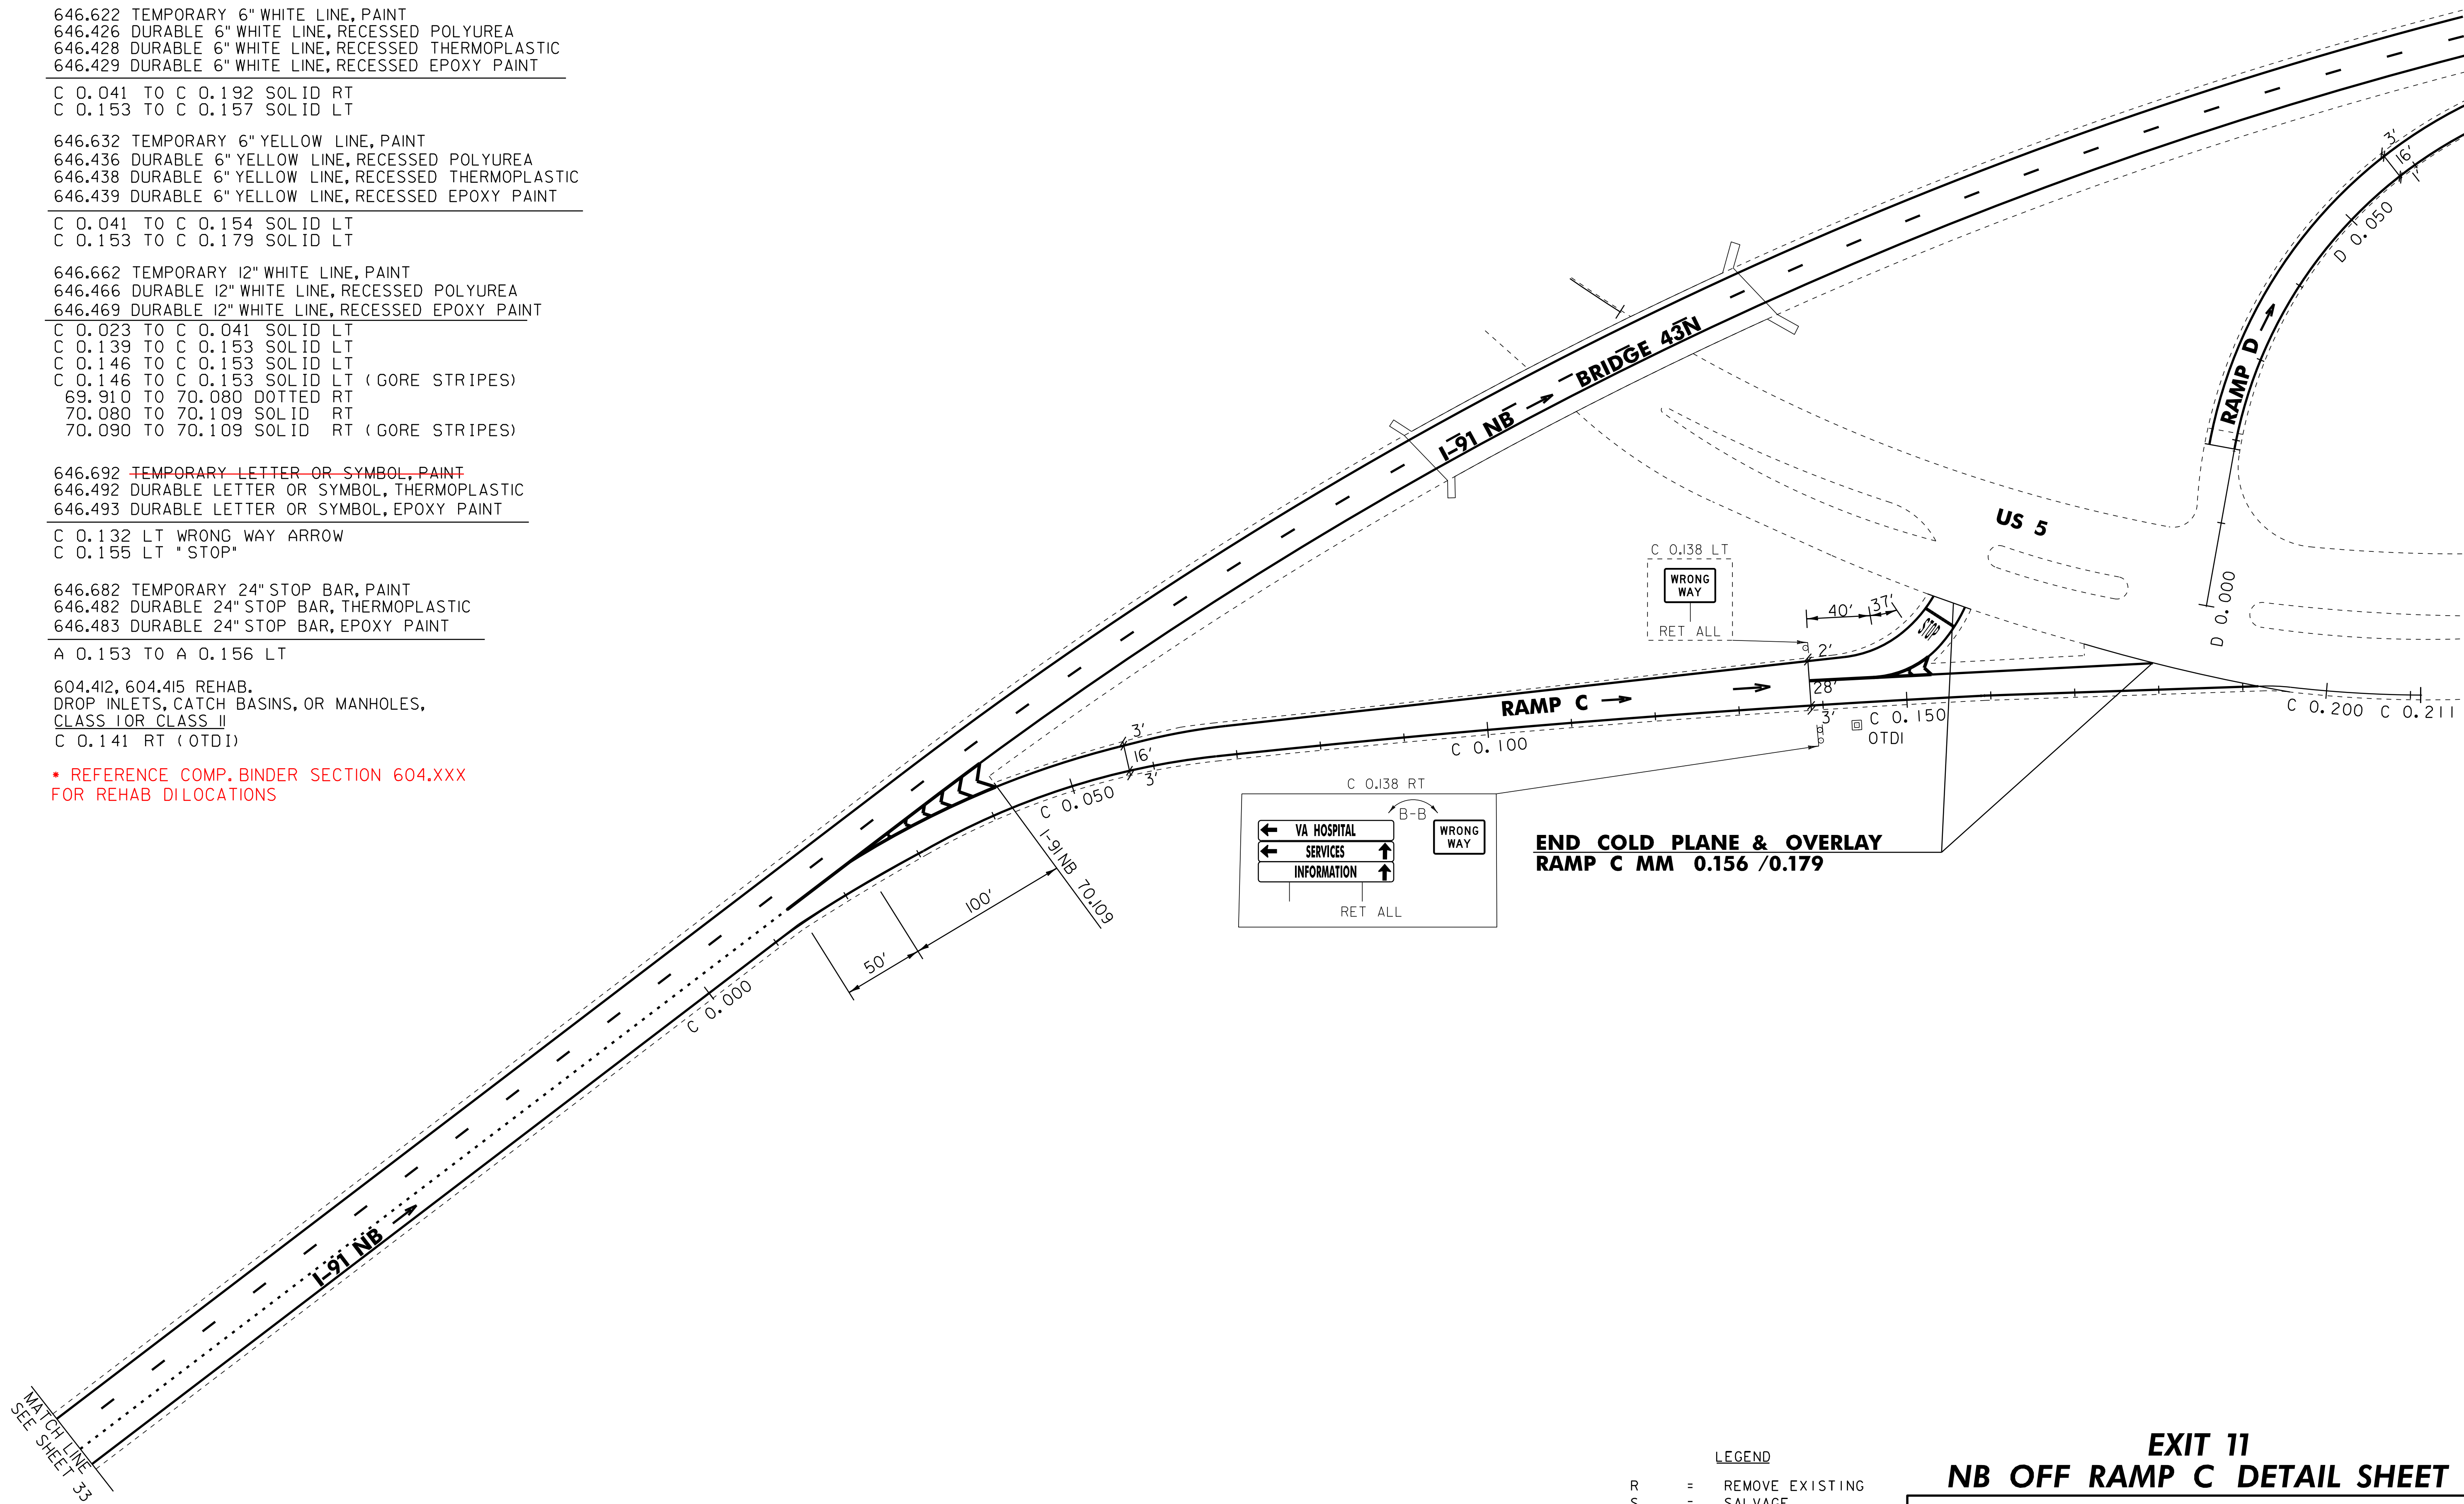

NOT TO SCALE

LEGEND

- R = REMOVE EXISTING
- S = SALVAGE
- R&S = REMOVE AND SALVAGE
- N = NEW
- RET = RETAIN
- B-B = BACK TO BACK
- = EXISTING GUARDRAIL
- = PROPOSED GUARDRAIL
- YL = YELLOW LINE
- WL = WHITE LINE

**EXIT 11
 NB OFF RAMP C DETAIL SHEET**

PROJECT NAME: HARTLAND-NORWICH	FILE NAME: /pave/06a202/p06a202.dgn	PLOT DATE: 19-JUN-2013 09:24
PROJECT NUMBER: IM 091-I(59)	PROJECT LEADER: PTS	DRAWN BY: WWG
	DESIGNED BY: NULL	CHECKED BY: PTS
	IPARM FILE NAME: 06A202_35	SHEET 35 OF 60