

646.622 TEMPORARY 6" WHITE LINE, PAINT
 646.426 DURABLE 6" WHITE LINE, RECESSED POLYUREA
 646.428 DURABLE 6" WHITE LINE, RECESSED THERMOPLASTIC
 646.429 DURABLE 6" WHITE LINE, RECESSED EPOXY PAINT

A 0.058 TO A 0.250 SOLID RT
 71.638 TO 71.712 DOTTED RT

646.632 TEMPORARY 6" YELLOW LINE, PAINT
 646.436 DURABLE 6" YELLOW LINE, RECESSED POLYUREA
 646.438 DURABLE 6" YELLOW LINE, RECESSED THERMOPLASTIC
 646.439 DURABLE 6" YELLOW LINE, RECESSED EPOXY PAINT

A 0.058 TO A 0.250 SOLID LT


646.662 TEMPORARY 12" WHITE LINE, PAINT
 646.466 DURABLE 12" WHITE LINE, RECESSED POLYUREA
 646.469 DURABLE 12" WHITE LINE, RECESSED EPOXY PAINT

A 0.011 TO A 0.058 SOLID LT
 A 0.011 TO A 0.058 SOLID LT (GORE STRIPES)
 71.706 TO 71.768 SOLID RT

646.692 TEMPORARY LETTER OR SYMBOL, PAINT
 646.492 DURABLE LETTER OR SYMBOL, THERMOPLASTIC
 646.493 DURABLE LETTER OR SYMBOL, EPOXY PAINT

A 0.126 LT "STOP"
 A 0.134 LT "AHEAD"
 A 0.224 LT WRONG WAY ARROW

A X.XXX LT "STOP"

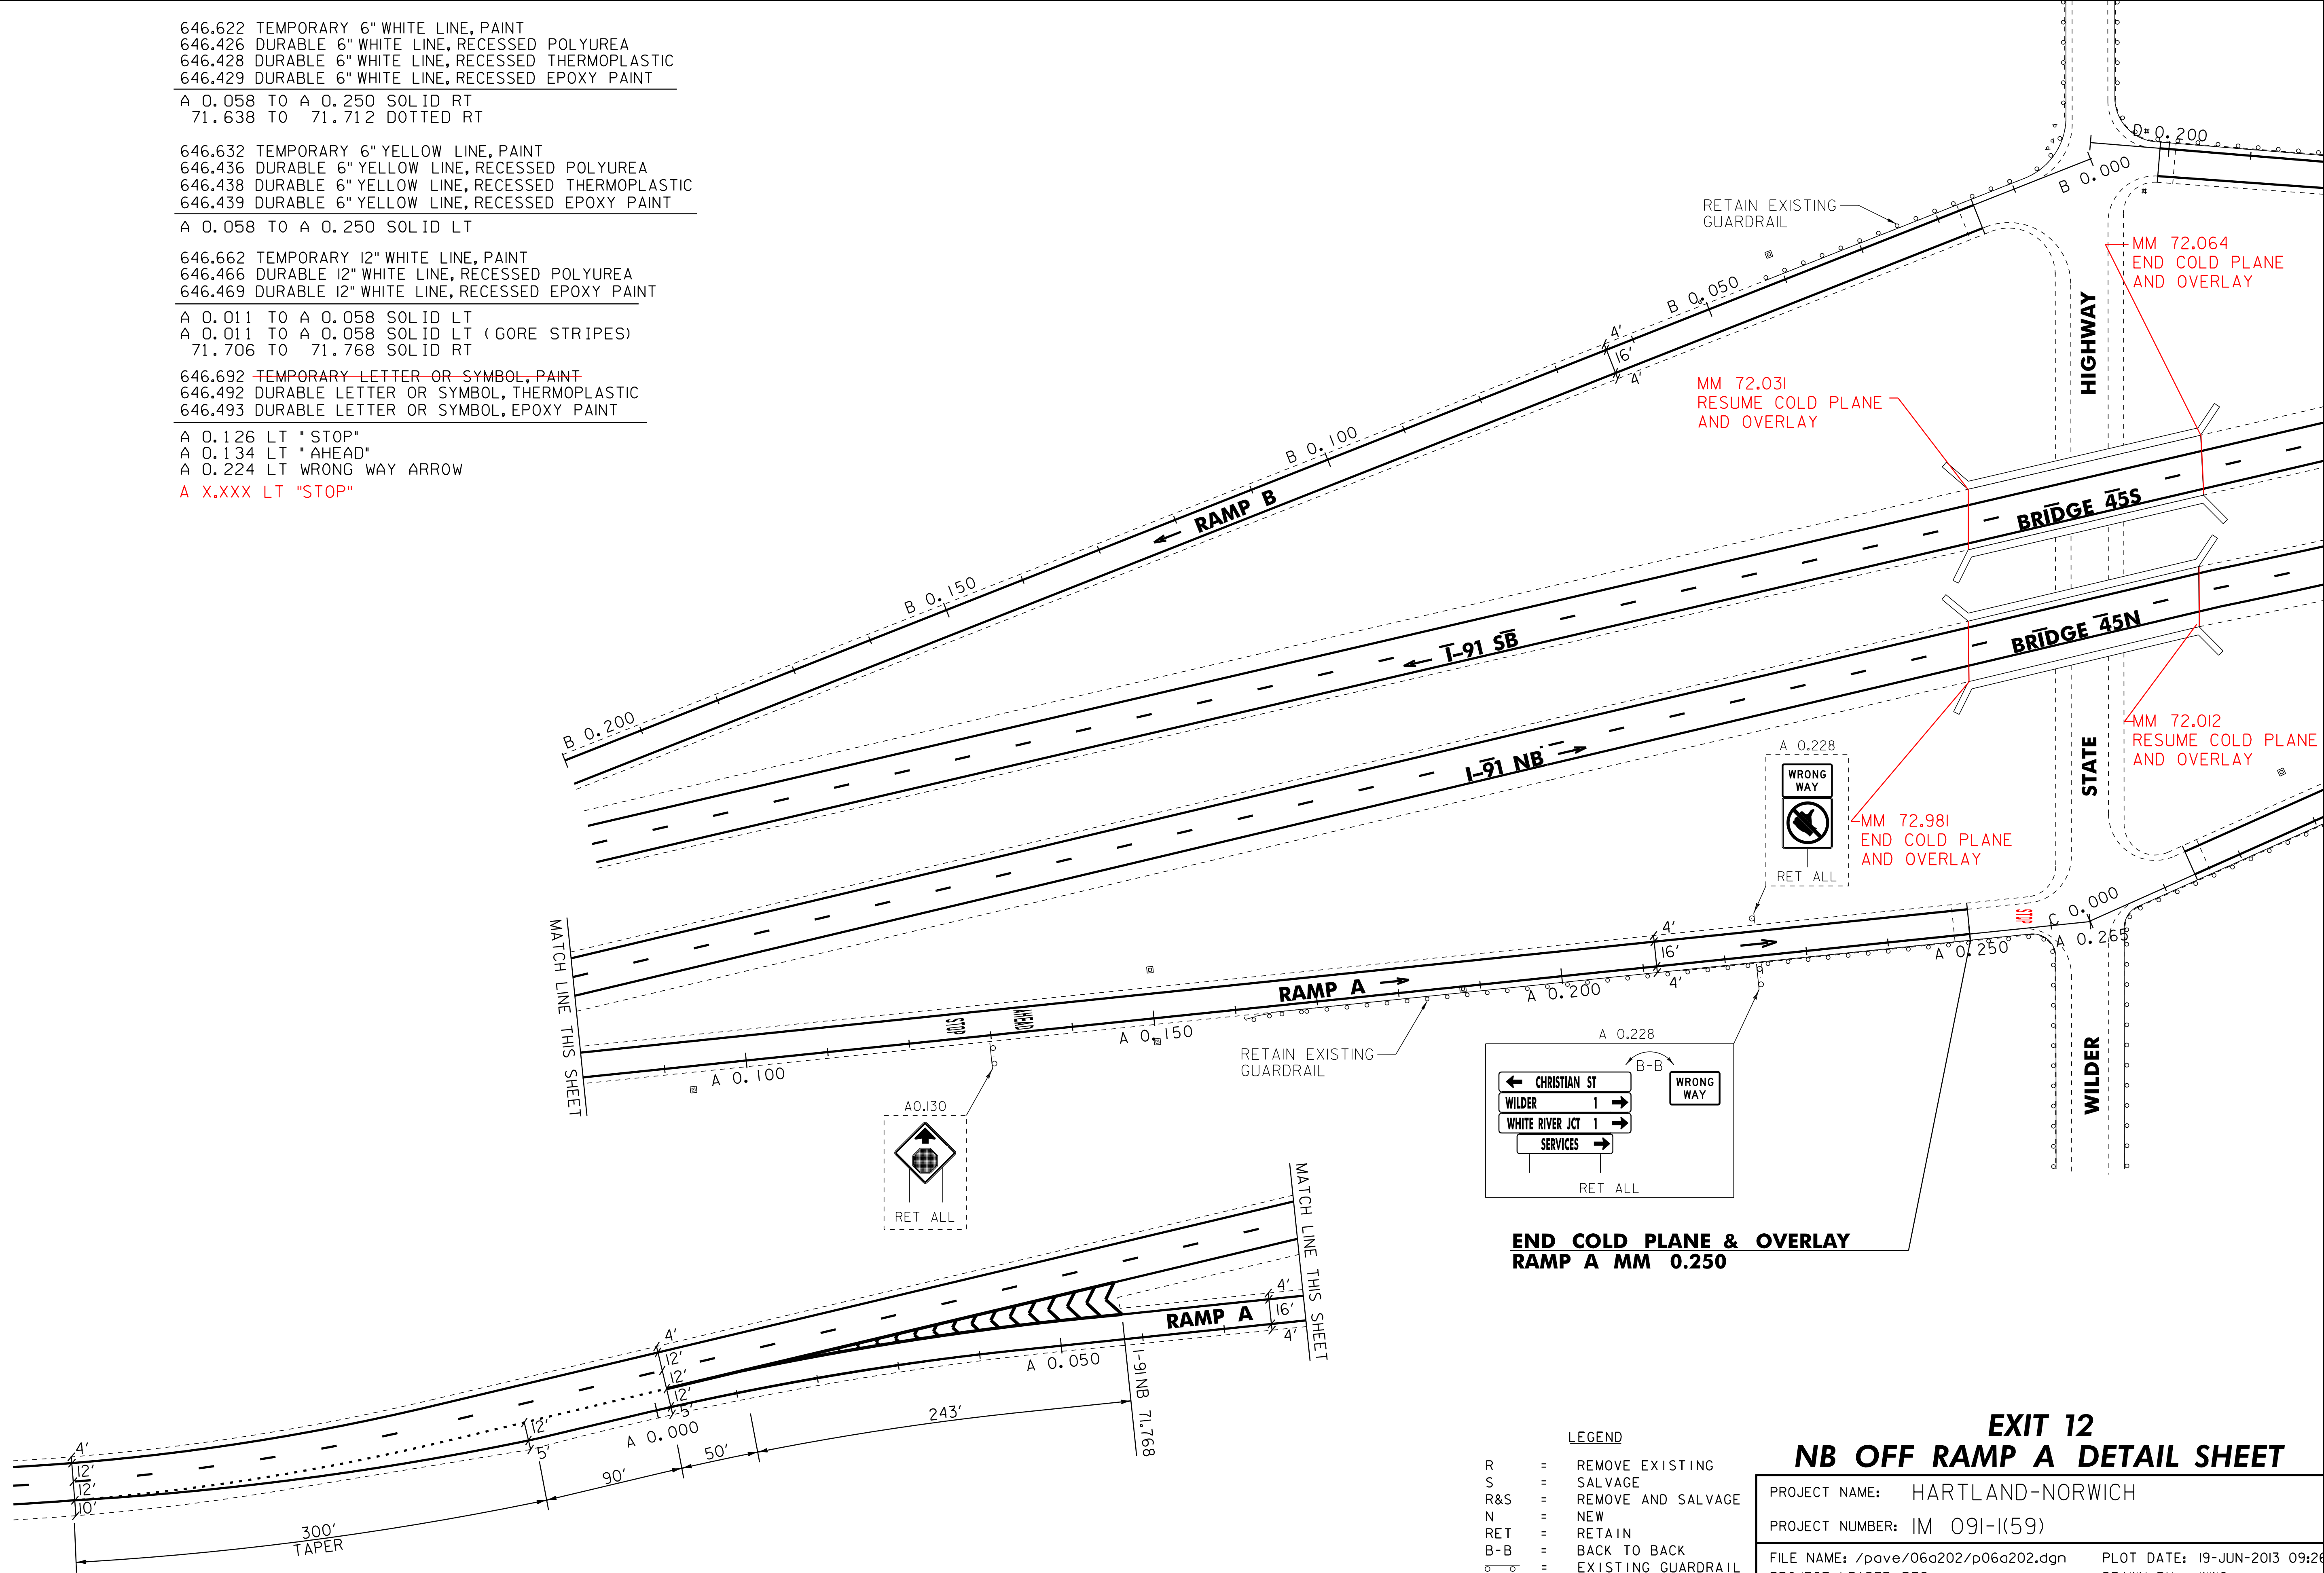

NOT TO SCALE

**END COLD PLANE & OVERLAY
 RAMP A MM 0.250**

LEGEND

R	=	REMOVE EXISTING
S	=	SALVAGE
R&S	=	REMOVE AND SALVAGE
N	=	NEW
RET	=	RETAIN
B-B	=	BACK TO BACK
	=	EXISTING GUARDRAIL
	=	PROPOSED GUARDRAIL
YL	=	YELLOW LINE
WL	=	WHITE LINE

**EXIT 12
 NB OFF RAMP A DETAIL SHEET**

PROJECT NAME: HARTLAND-NORWICH	FILE NAME: /pave/06a202/p06a202.dgn	PLOT DATE: 19-JUN-2013 09:24
PROJECT NUMBER: IM 091-I(59)	PROJECT LEADER: PTS	DRAWN BY: WWG
	DESIGNED BY: NLL	CHECKED BY: PTS
	IPARM FILE NAME: 06A202_38	SHEET 38 OF 60