

646.622 TEMPORARY 6" WHITE LINE, PAINT
 646.426 DURABLE 6" WHITE LINE, RECESSED POLYUREA
 646.428 DURABLE 6" WHITE LINE, RECESSED THERMOPLASTIC
 646.429 DURABLE 6" WHITE LINE, RECESSED EPOXY PAINT

C 0.014 TO C 0.179 SOLID RT
 72.203 TO 72.360 DOTTED RT

646.632 TEMPORARY 6" YELLOW LINE, PAINT
 646.436 DURABLE 6" YELLOW LINE, RECESSED POLYUREA
 646.438 DURABLE 6" YELLOW LINE, RECESSED THERMOPLASTIC
 646.439 DURABLE 6" YELLOW LINE, RECESSED EPOXY PAINT

C 0.014 TO C 0.179 SOLID LT


646.662 TEMPORARY 12" WHITE LINE, PAINT
 646.466 DURABLE 12" WHITE LINE, RECESSED POLYUREA
 646.469 DURABLE 12" WHITE LINE, RECESSED EPOXY PAINT

C 0.179 TO C 0.231 SOLID LT
 72.141 TO 72.203 SOLID RT

604.412, 604.415 REHAB. DROP
 INLETS, CATCH BASINS, OR MANHOLES,
 CLASS I OR CLASS II
 C 0.067 RT
 C 0.171 RT

613.10 STONE FILL, TYPE I
~~C 0.016 RT (RAMP C)~~

* REFERENCE COMP. BINDER SECTION 604.XXX
 FOR REHAB DILOCATIONS

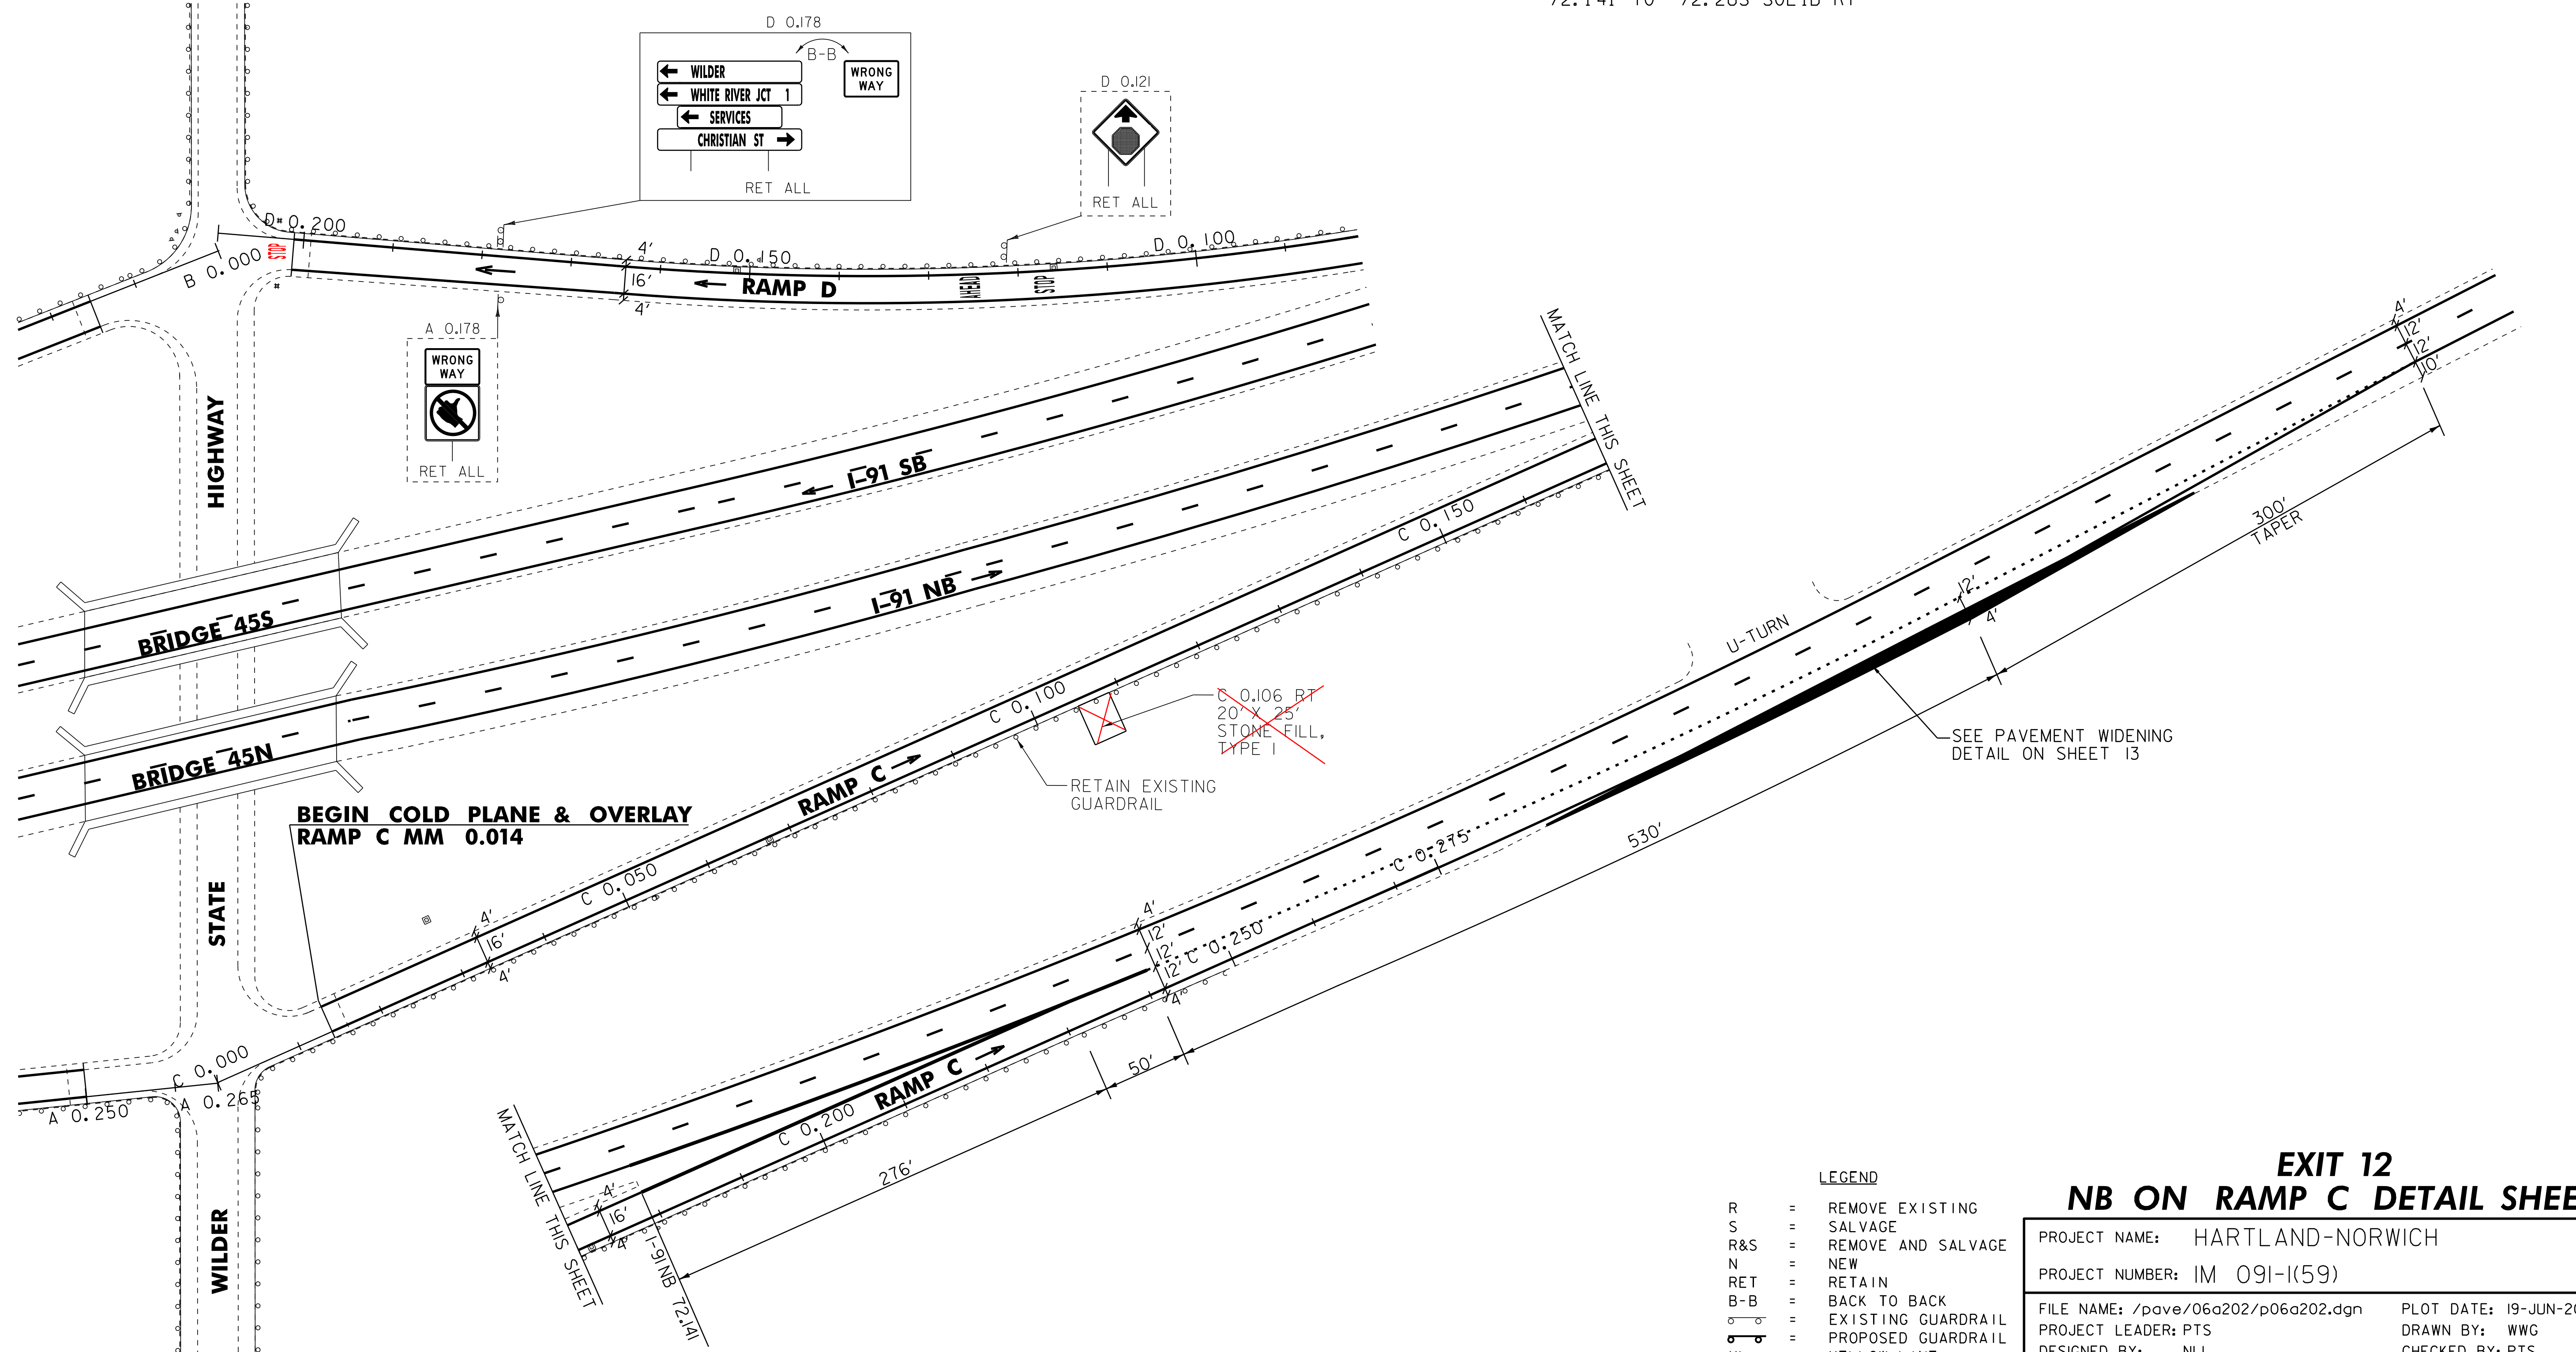

NOT TO SCALE

LEGEND

R	=	REMOVE EXISTING
S	=	SALVAGE
R&S	=	REMOVE AND SALVAGE
N	=	NEW
RET	=	RETAIN
B-B	=	BACK TO BACK
	=	EXISTING GUARDRAIL
	=	PROPOSED GUARDRAIL
YL	=	YELLOW LINE
WL	=	WHITE LINE

EXIT 12 NB ON RAMP C DETAIL SHEET

PROJECT NAME: HARTLAND-NORWICH	
PROJECT NUMBER: IM 091-I(59)	
FILE NAME: /pave/06a202/p06a202.dgn	PLOT DATE: 19-JUN-2013 09:24
PROJECT LEADER: PTS	DRAWN BY: WWG
DESIGNED BY: NLL	CHECKED BY: PTS
IPARM FILE NAME: 06A202_39	SHEET 39 OF 60