


**CURVE 1**

STATION	NORTHING	EASTING	APPROX. MILE POINT	REMARKS
PC 3881+74.92	433078.0382	1690031.1559	73.518	DESIGN SPEED 70
PT 3910+83.11	435922.2107	1690599.4446	74.069	

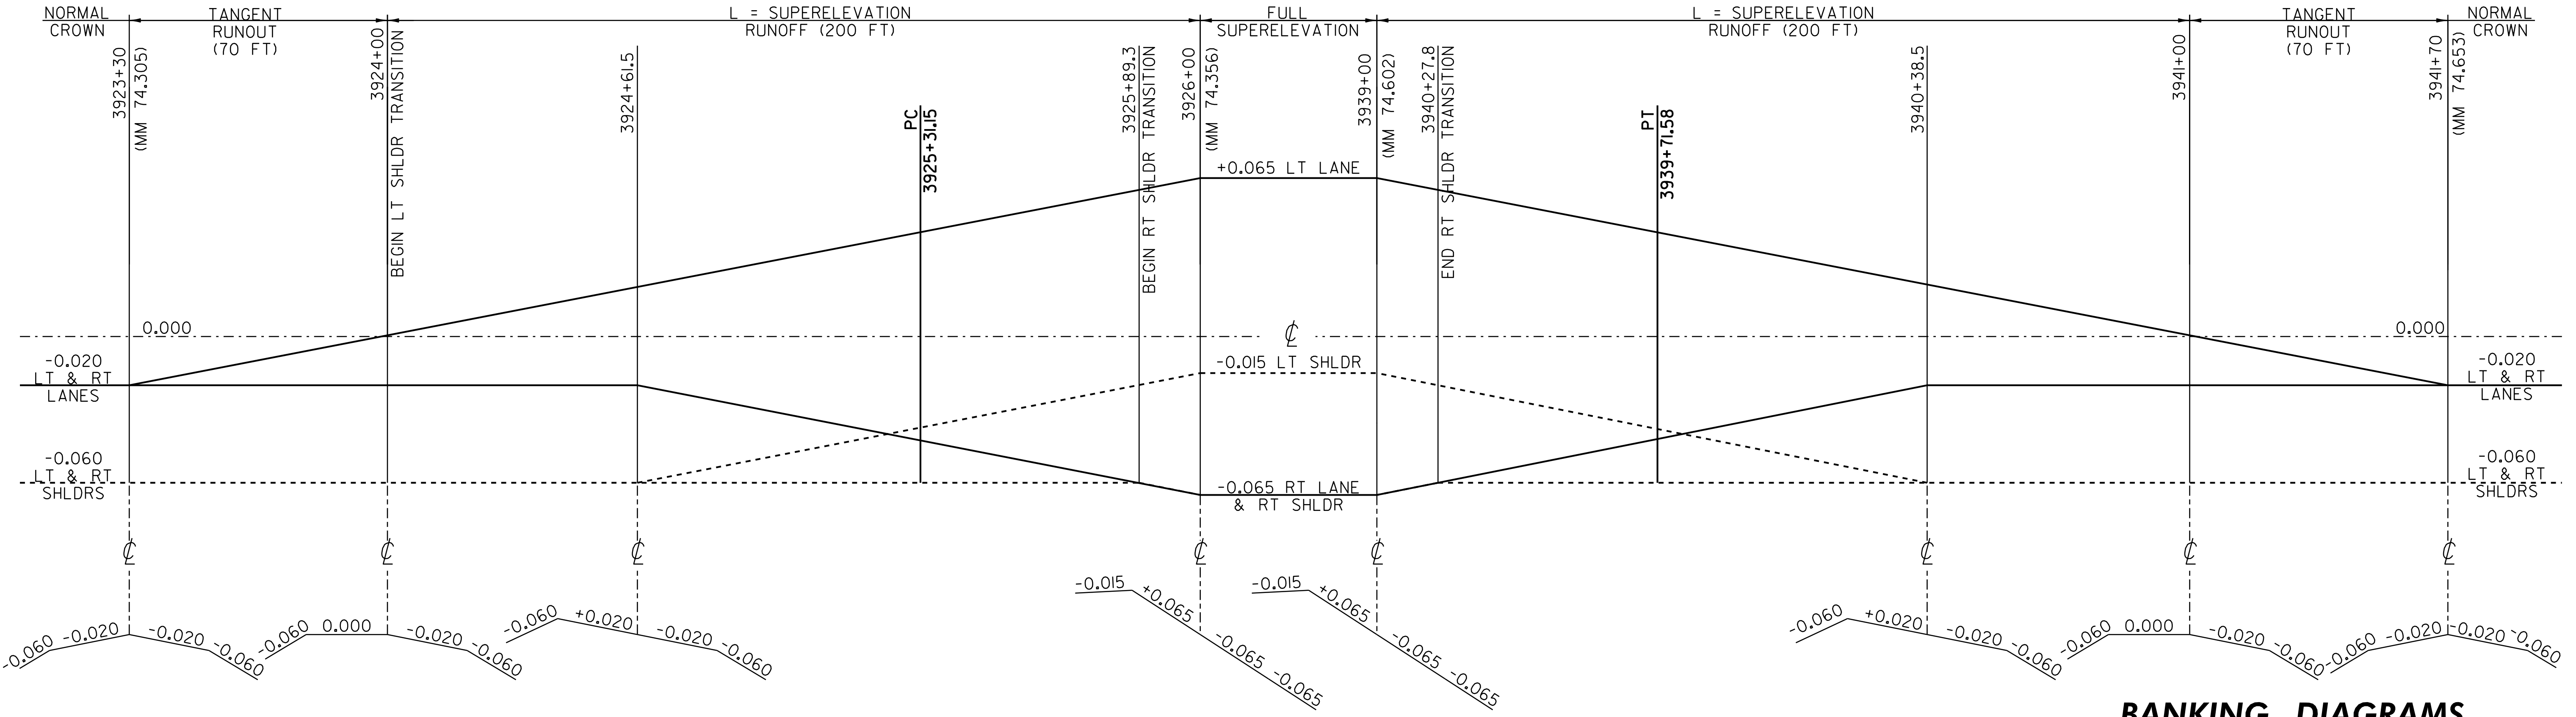

**CURVE 2**

STATION	NORTHING	EASTING	APPROX. MILE POINT	REMARKS
PC 3925+31.15	437366.6792	1690701.1836	74.343	DESIGN SPEED 70
PT 3939+71.58	438718.8517	1691151.8602	74.616	

**BANKING DIAGRAMS**

PROJECT NAME: HARTLAND-NORWICH  
 PROJECT NUMBER: IM 091-I(59)  
 FILE NAME: /pave/06a202/p06a202.dgn PLOT DATE: 19-JUN-2013 09:24  
 PROJECT LEADER: PTS DRAWN BY: WWG  
 DESIGNED BY: DAM CHECKED BY: PTS  
 IPARM FILE NAME: 06A202\_46 SHEET 46 OF 60