


GUARDRAIL TREATMENT - BRIDGE 45 N&S


INTERSTATE 91 OVER WILDER STATE HIGHWAY

NOTE
I. SEE NOTE 16 ON SHEET 8.

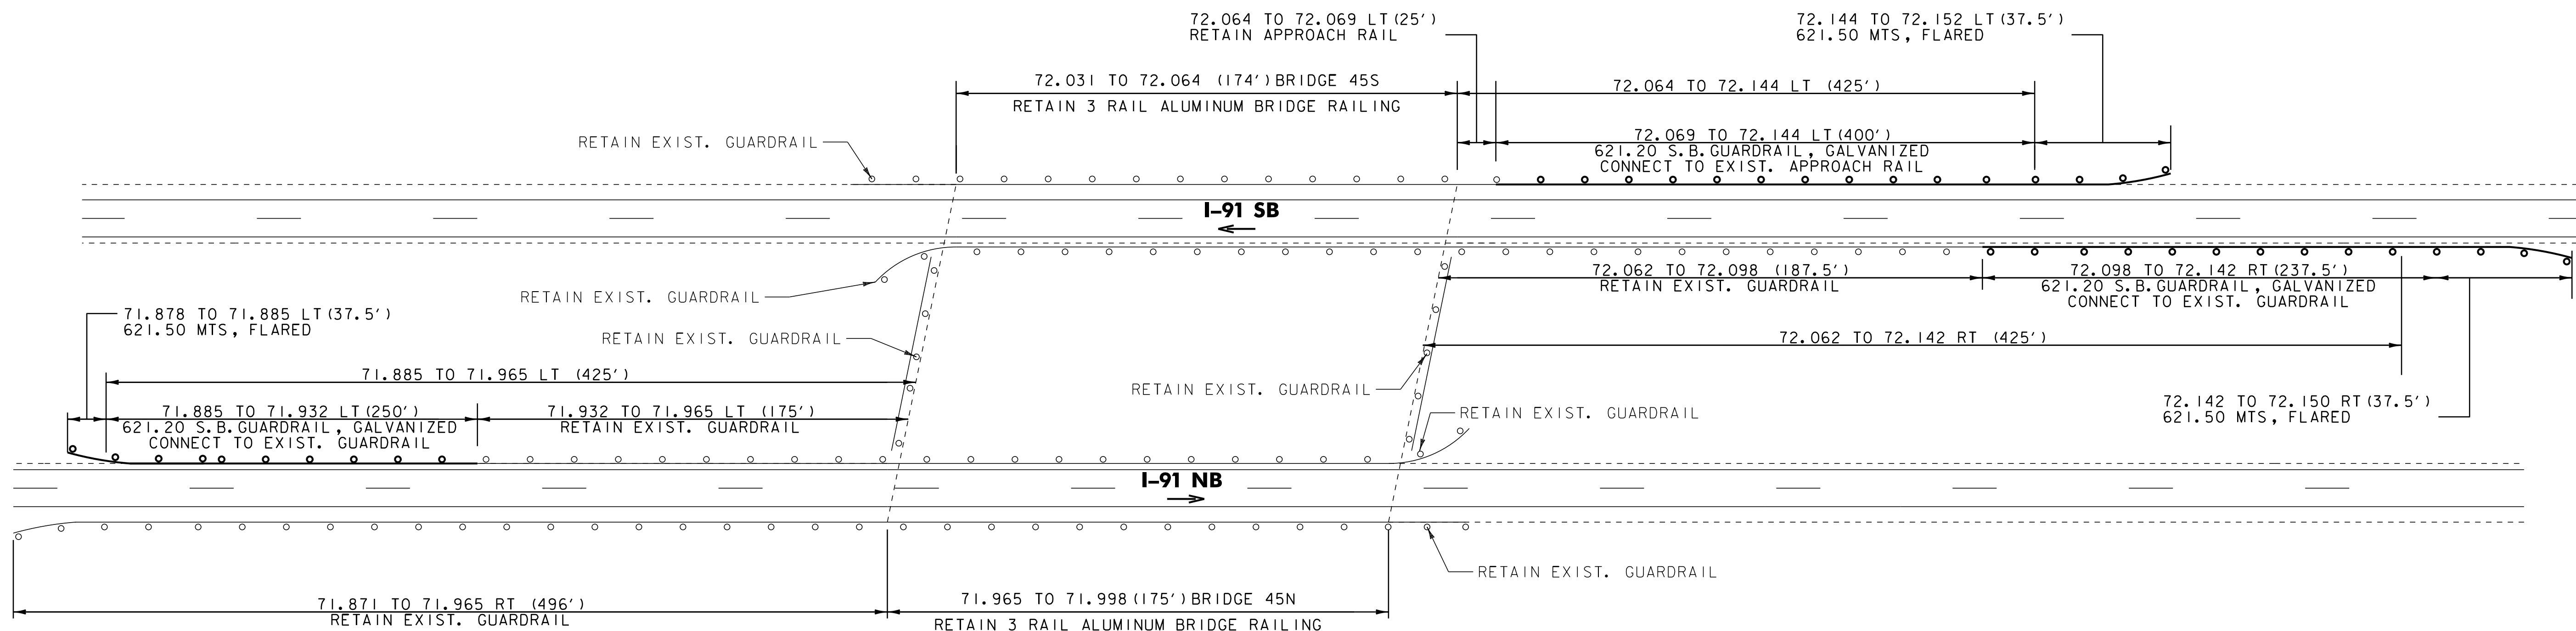

GUARDRAIL TREATMENT - BRIDGE 47 N&S

INTERSTATE 91 OVER US ROUTE 5

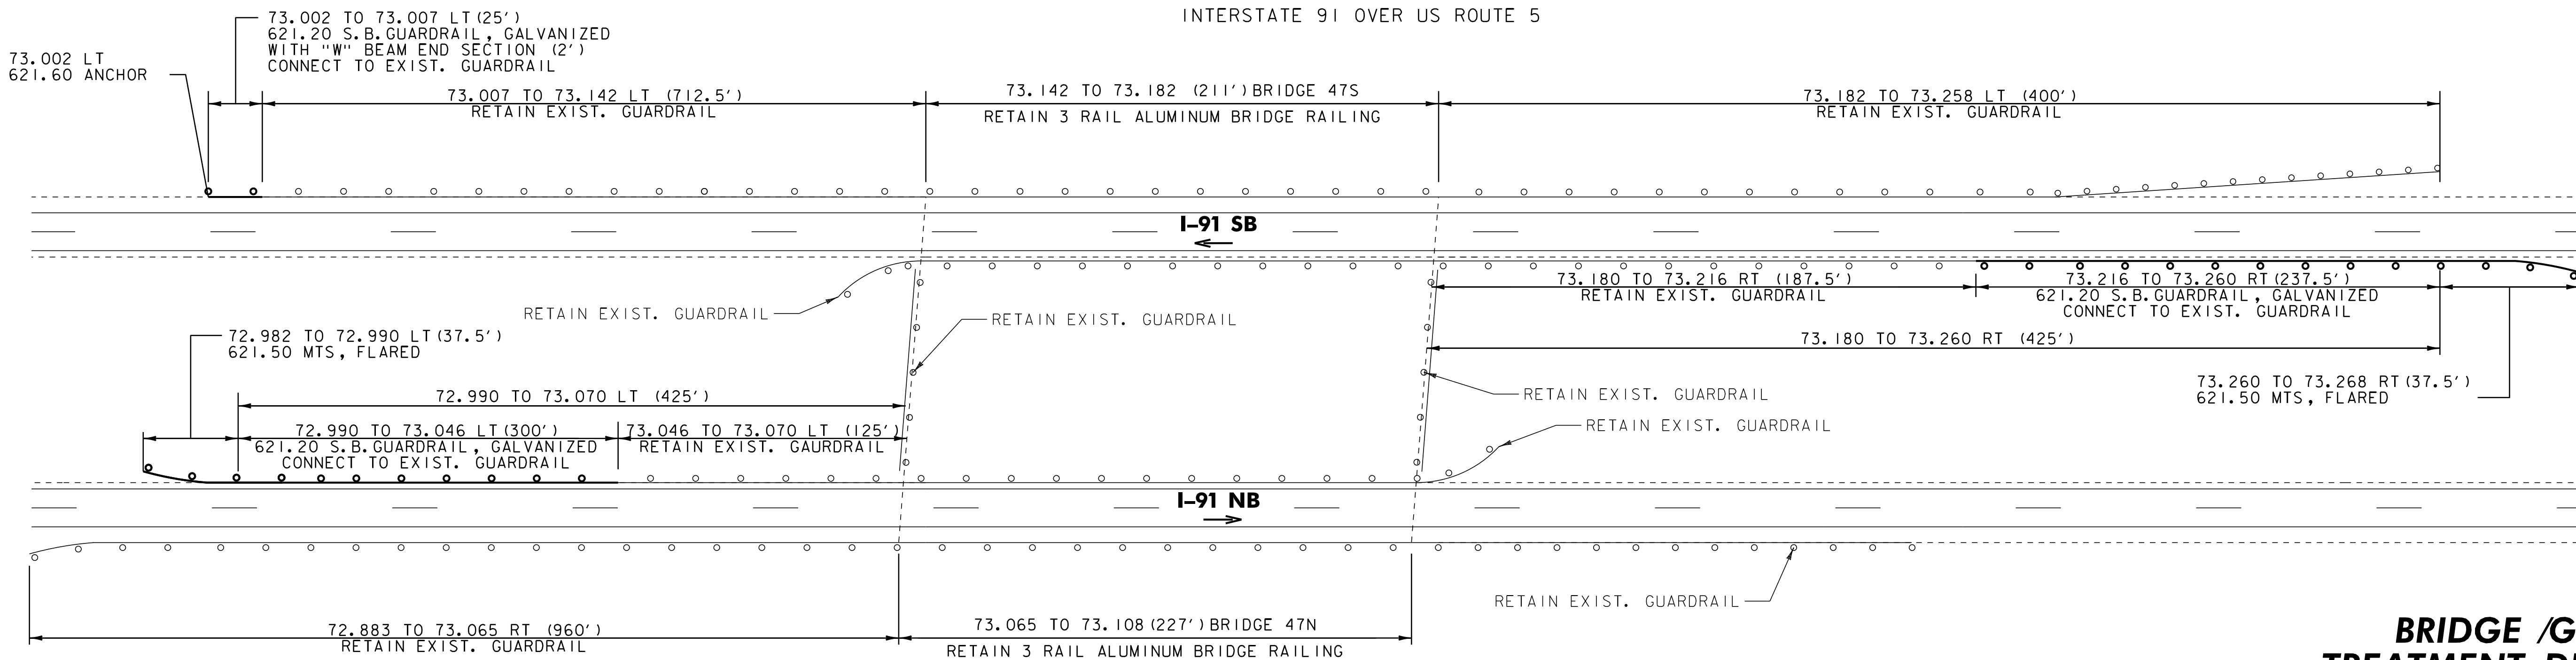

BRIDGE / GUARDRAIL TREATMENT DETAIL SHEET 4

PROJECT NAME: HARTLAND-NORWICH	FILE NAME: /pave/06a202/p06a202.dgn	PLOT DATE: 19-JUN-2013 09:21
PROJECT NUMBER: IM 091-I(59)	PROJECT LEADER: PTS	DRAWN BY: WWG
	DESIGNED BY: NULL	CHECKED BY: PTS
	IPARM FILE NAME: 06A202_50	SHEET 50 OF 60

• REFERENCE COMP. BINDER SECTION 621.XXX FOR GUARDRAIL SUMMARY SHEET

NOT TO SCALE