


GUARDRAIL TREATMENT - BRIDGE 485

INTERSTATE 91 OVER VT ROUTE 10A


NOTE

I. SEE NOTE 16 ON SHEET 8.

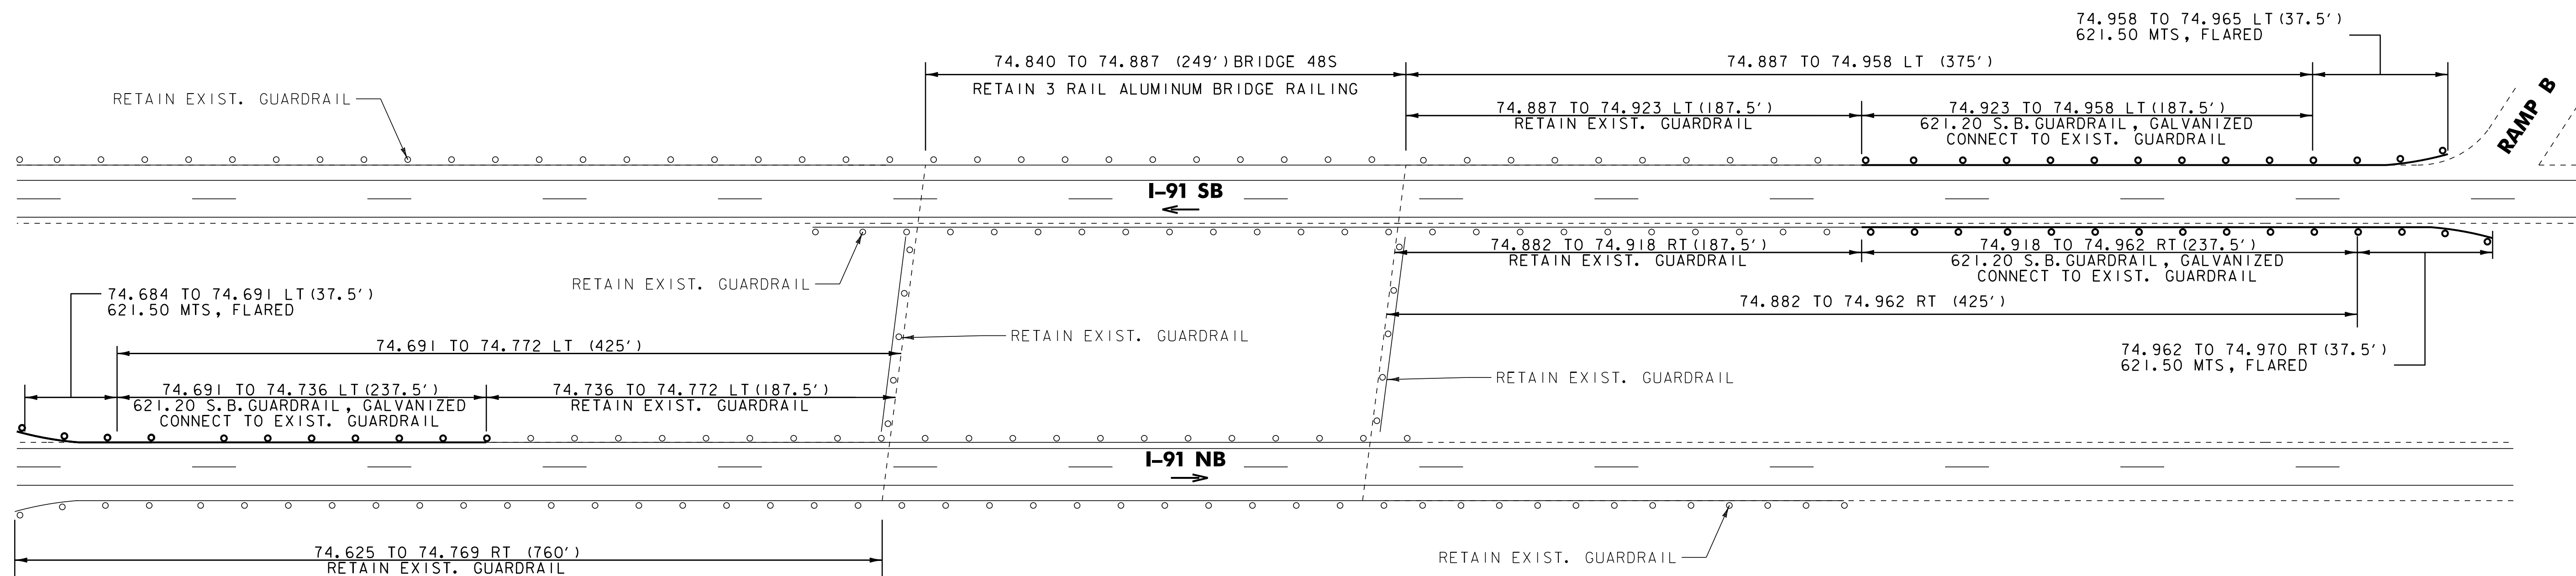

GUARDRAIL TREATMENT - BRIDGE 495

INTERSTATE 91 OVER US ROUTE 5

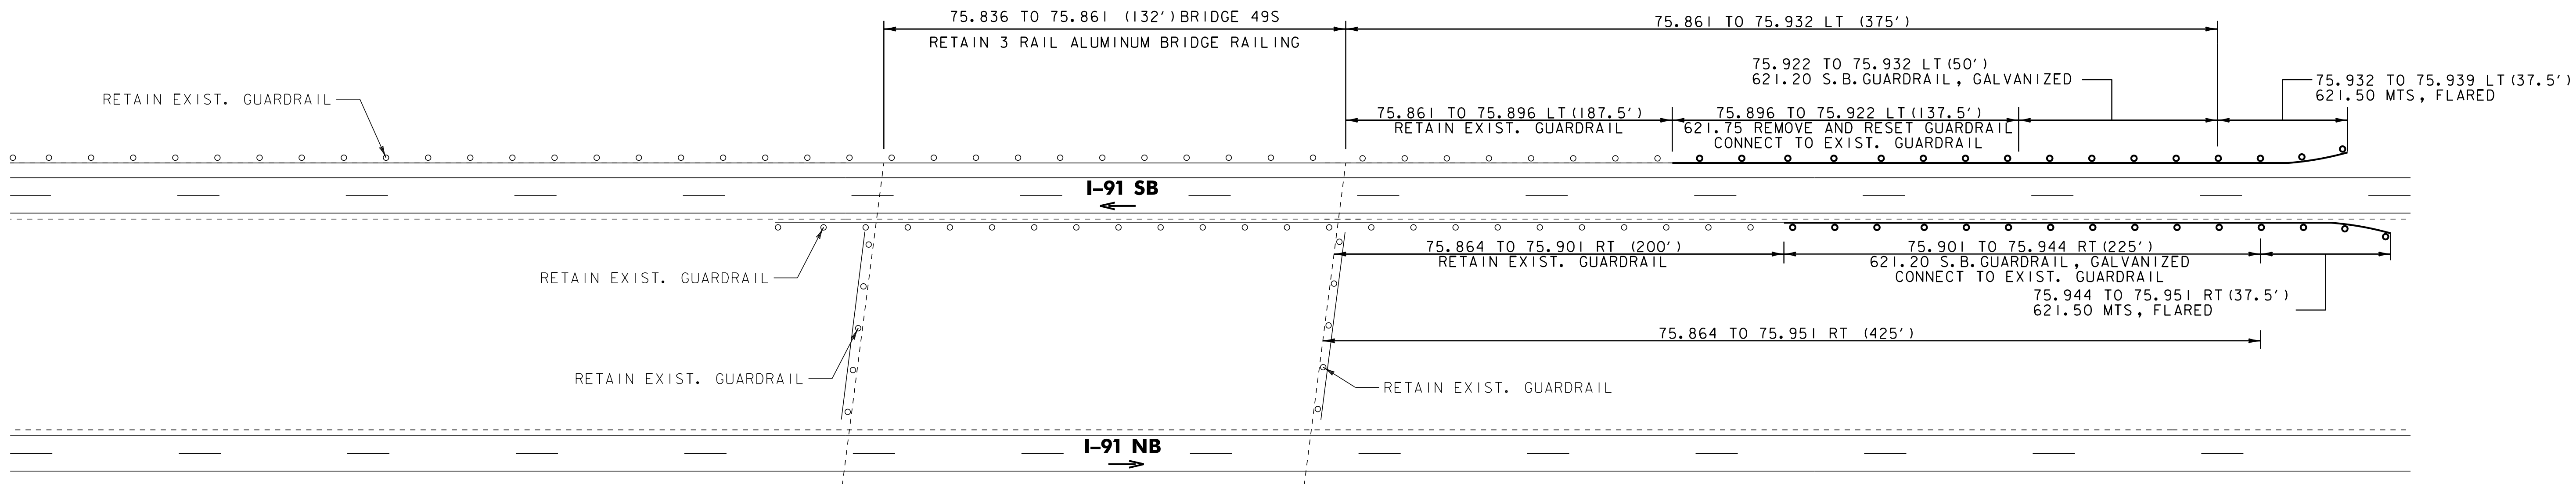

BRIDGE / GUARDRAIL TREATMENT DETAIL SHEET 5

PROJECT NAME: HARTLAND-NORWICH	FILE NAME: /pave/06a202/p06a202.dgn	PLOT DATE: 19-JUN-2013 09:2
PROJECT NUMBER: IM 091-I(59)	PROJECT LEADER: PTS	DRAWN BY: WWG
	DESIGNED BY: NULL	CHECKED BY: PTS
	IPARM FILE NAME: 06A202_51	SHEET 51 OF 60

* REFERENCE COMP. BINDER SECTION 621.XXX FOR GUARDRAIL SUMMARY SHEET

NOT TO SCALE